


2000
Two hundred
of the

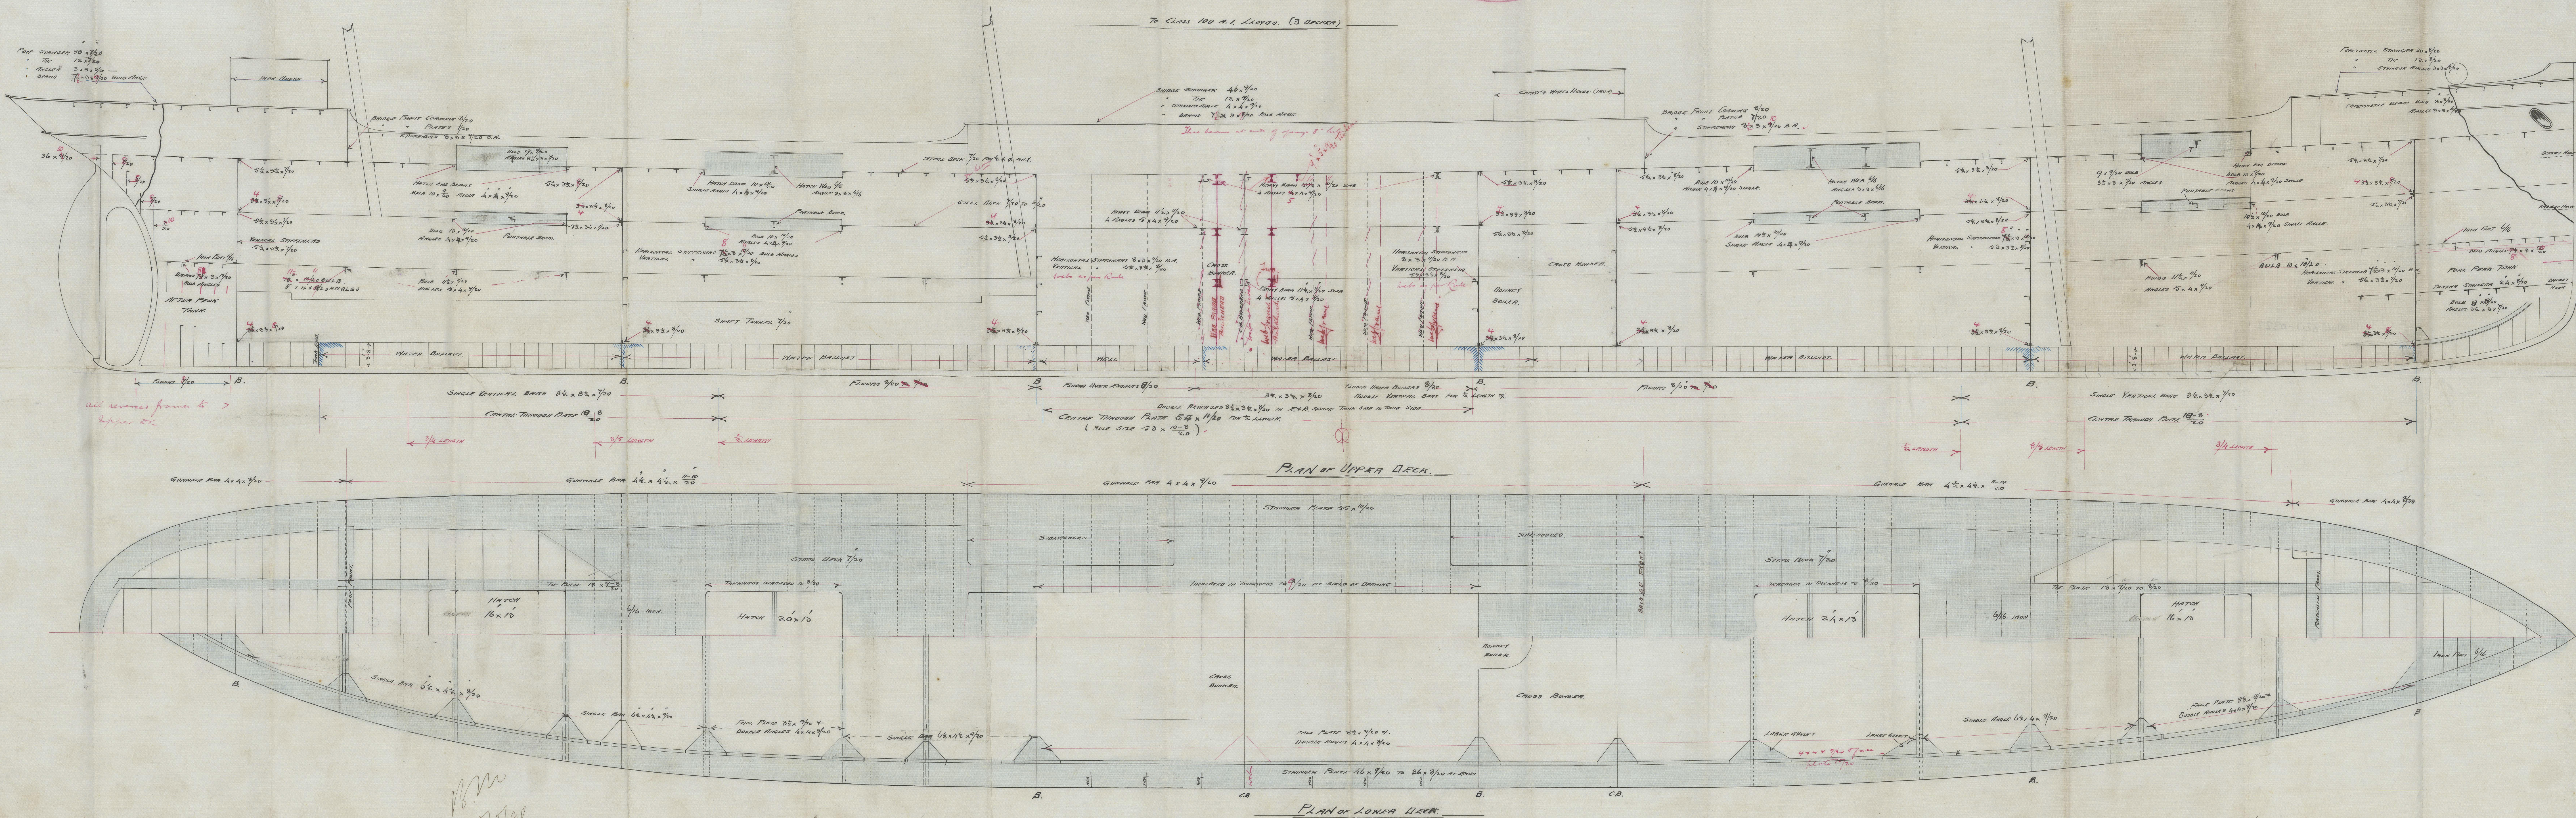

W. H. Chapman
14 the Actors
go.

15/10/90

