


EQUIPMENT NO. 37214.53.

$\frac{1}{2}$ MOUNDED BREADTH ———— 22.⁰.
 $\frac{1}{2}$ GIRTH ————— 45.91
 DEPTH ————— 29.88
 97.79
 7.00
 1ST NO. 90.79
 358.17
 2ND NO. 32518.2543.

PROPORTIONS.

DEPTH TO LENGTH - UPPER DECK	11.96
" " " MAIN	16.30
BREATHS " "	8.14

TONNAGE UNDER DECK ABOUT 3260.
TAKEN TO TOP OF INNER BOTTOM

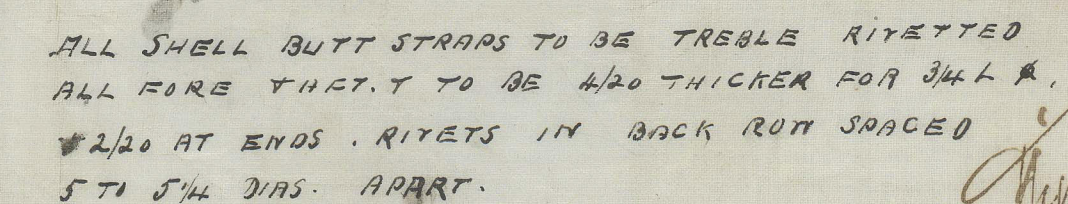

15/9/90
© 2021

EWCASTLE-ON-TYNE
1907/10/14

319 1919 319

[illegible]


Ans 26093

WWC820-0373