


MIDSHIP SECTION. N^o 657-658-659.

Scale $\frac{1}{2}$ inch = 1 Foot.

TUE 11 NOV 90

WED 24 SEP 90
FRI 10 OCT 90
TUE 11 NOV 90
THU 27 NOV 90
MON 18 DEC 90

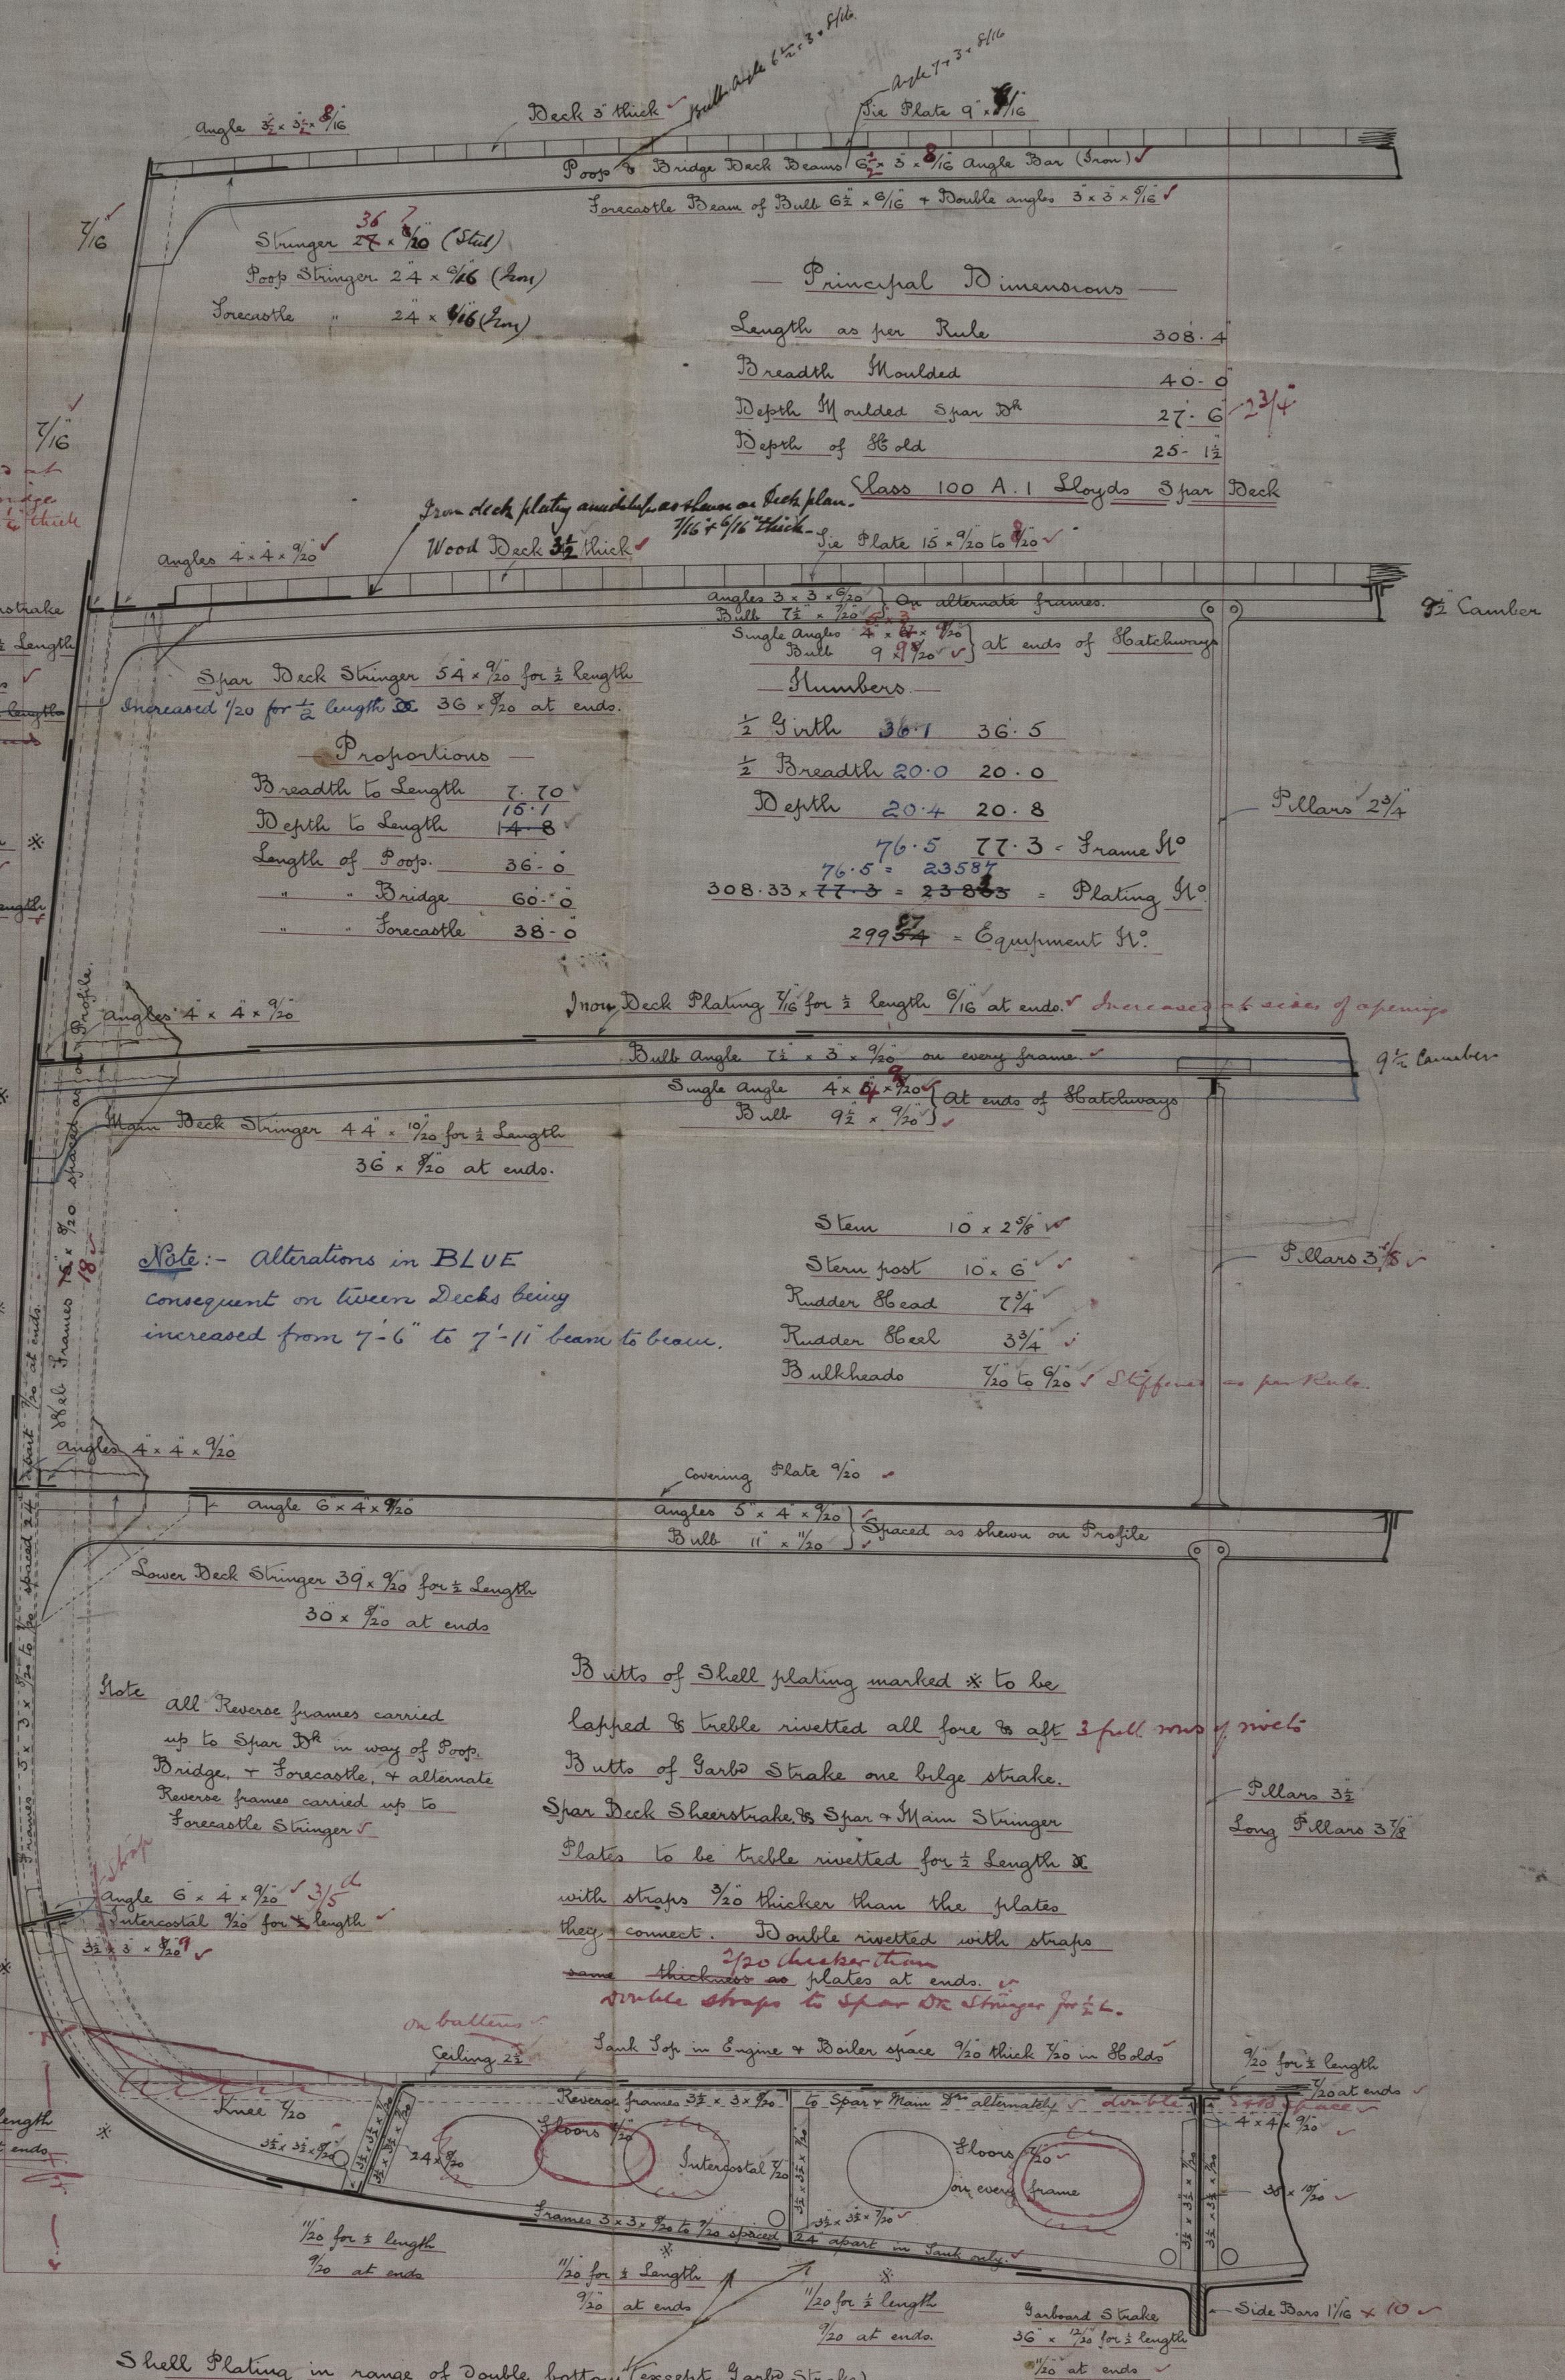

Principal Dimensions

| | |
|-------------------------|-------|
| Length as per Rule | 308.4 |
| Breadth Moulded | 40.0 |
| Depth Moulded Spar Deck | 27.6 |
| Depth of Hold | 25.12 |

Class 100 A.1 Lloyd's Spar Deck

Proportions

| | |
|-------------------|------|
| Breadth to Length | 7.70 |
| Depth to Length | 14.8 |
| Length of Poop | 36.0 |
| " Bridge | 60.0 |
| " Fore-castle | 38.0 |

Stumbers

| | | |
|--|------|------|
| $\frac{1}{2}$ Girth | 36.1 | 36.5 |
| $\frac{1}{2}$ Breadth | 20.0 | 20.0 |
| Depth | 20.4 | 20.8 |
| 76.5 77.3 - Frame N ^o | | |
| 76.5 = 23585 | | |
| 308.33 x 77.3 = 23863 = Plating N ^o | | |
| 29954 = Equipment N ^o | | |

Note:- alterations in BLUE

consequent on tween Decks being increased from 7'-6" to 7'-11" beam to beam.

Note

All Reverse frames carried up to Spar Deck in way of Poop, Bridge, + Fore-castle, + alternate Reverse frames carried up to Fore-castle Stringer.

Butts of Shell plating marked * to be

lapped & treble rivetted all fore & aft 3 full rows of rivets.

Butts of Garb Strake one bilge strake.

Spar Deck Sheerstrake & Spar + Main Stringer

Plates to be treble rivetted for $\frac{1}{2}$ length &

with straps $\frac{3}{20}$ thicker than the plates

they connect. Double rivetted with straps

same thickness as plates at ends. *Double straps to Spar Deck Stringer for $\frac{1}{2}$ length.*

Laik Top in Engine + Boiler space $\frac{1}{20}$ thick $\frac{1}{20}$ in Hold

Shell Plating in range of Double bottom (except Garb Strake)

to be reduced to in thickness where $\frac{11}{16}$ thick only.

23/19/90





© 21/9/90

Lloyd's Register Foundation

NW6821-0158

Francisco Crupi
No 687-8-79
Newspapers and
Reports 6045
The Ref. 26 2014

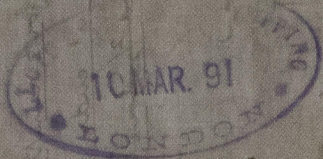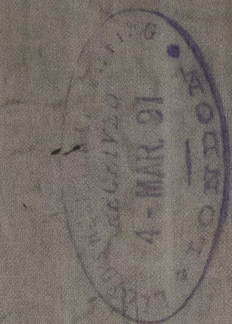





