


SCALE  $\frac{1}{8}$  INCH = ONE FOOT.

THU 27 NOV 93


I Nam De. lin

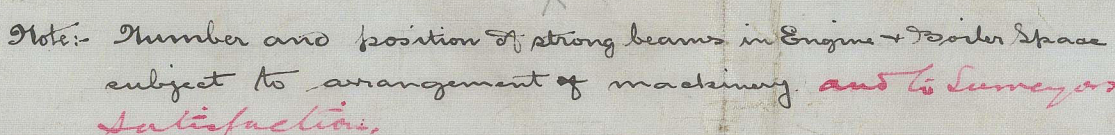

Spacing of stringers at ends not to exceed spacing amidships.

Strips of each plate 6/16 thick.

Stroke of local platy near opening  $\frac{1}{16}$  thick

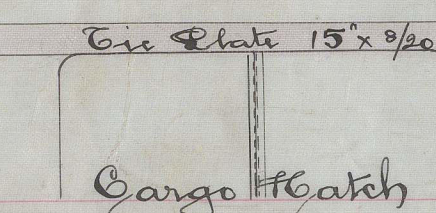

Cargo Hatch

4/16 Platina (3ma)

Gargo Hatch

## Engine Crasing

Gallery	Stole	
	Hole	

### Foot Tunnel Casing

Donkey	Stroke
Boiler	hole

Hatch		
-------	--	--

ingo to arch

2/11/21

		Care
--	--	------

goatch

This image shows a blank, aged, cream-colored page, likely an endpaper or flyleaf of a book. The paper has a slightly textured appearance with some minor creases and discoloration, characteristic of old paper. A vertical line is visible on the left side, possibly indicating a binding edge. The page is otherwise empty of any text or markings.

[illegible]

27/11/90

22/11/90



No 657-8 ~~7~~

Amended Plan

"Francesco Crispi"

(Two Report  
No 26075  
Greenwood)

Two First Entry  
report No 26202

5410-1287MN



© 2021

Lloyd's Register  
Foundation