



Ln. 5.3.91

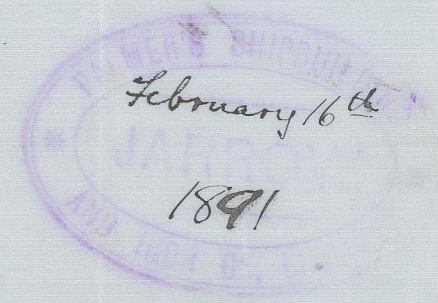

Pumping Arrangement 65728
Scale 8=1 Foot




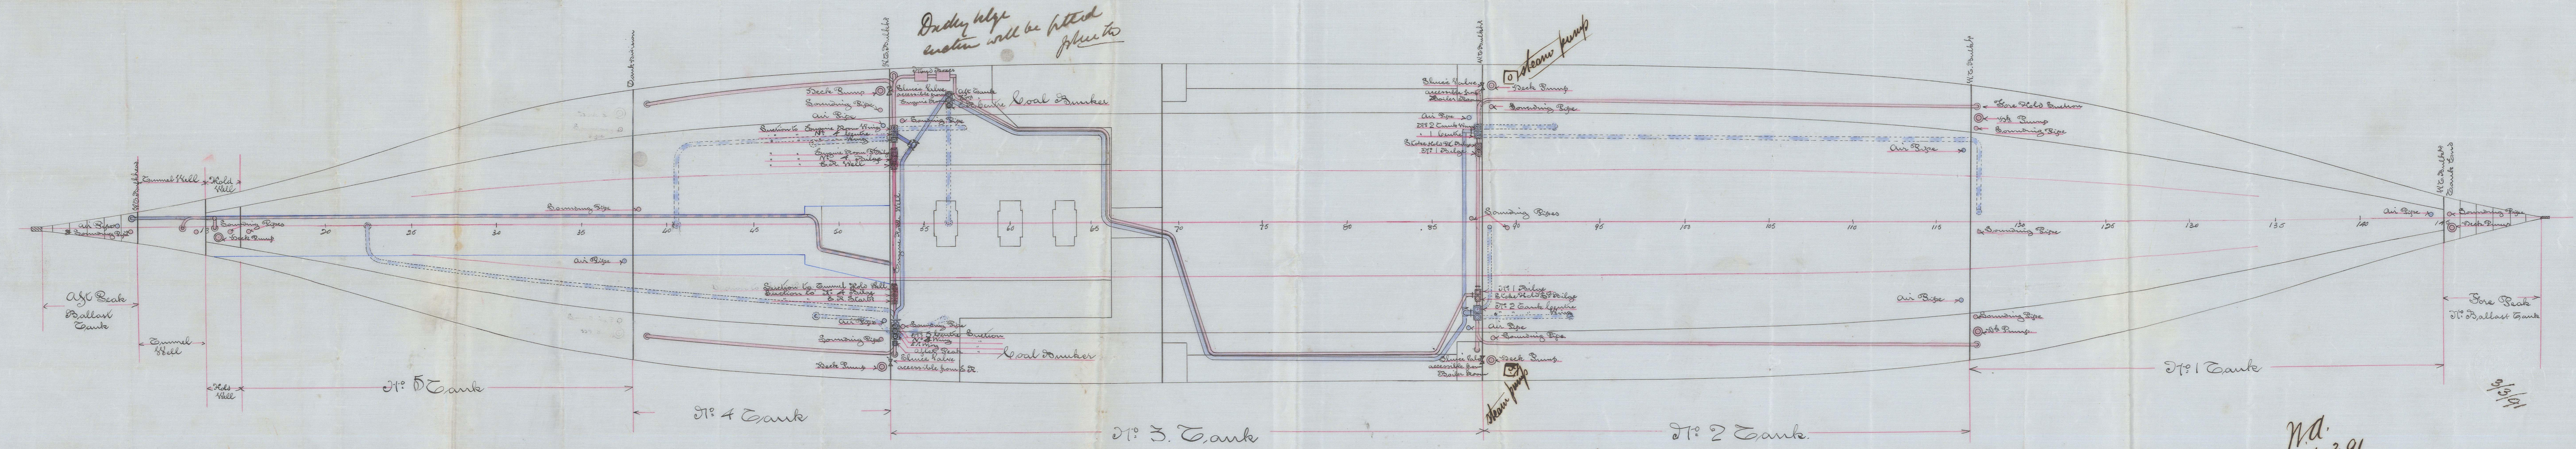

John W.

N.A.
4.3.91


3/3/91

No 65748

"Francesco Crispi"
Kuck Report No
26204

Two Reports

262044

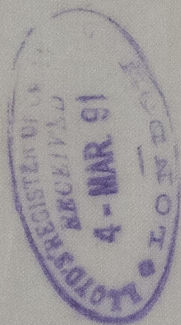

Lloyd's Register
Foundation