



11.3.91

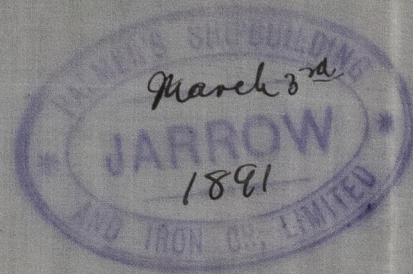

# Steel Masts S.S. Nos 65748

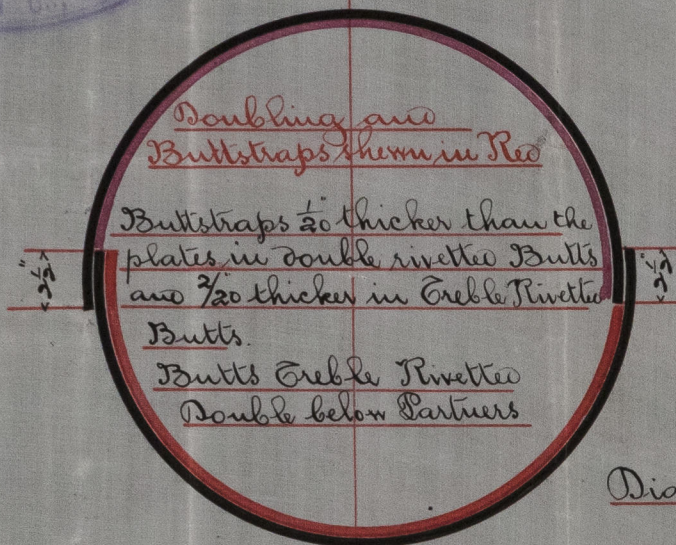


Main Mast 78'-3" long  
 Housing 18'-0"  
 D<sup>h</sup> to Housings 52'-3"  
 Head 8'-0"


Diameter of Keel  $18 \times \frac{6}{20}$   
 " Partners  $23 \times \frac{7}{20}$   
 " Housings  $19 \times \frac{6}{20}$   
 " Head  $15 \frac{1}{2} \times \frac{6}{20}$

Fore Mast 85'-0" long  
 Housing 27'-6"  
 D<sup>h</sup> to Housings 49'-6"  
 Head 8'-0"


Diameter of Keel  $19 \times \frac{6}{20}$   
 " Partners  $24 \frac{1}{2} \times \frac{7}{20}$   
 " Housings  $20 \times \frac{6}{20}$   
 " Head  $16 \times \frac{6}{20}$

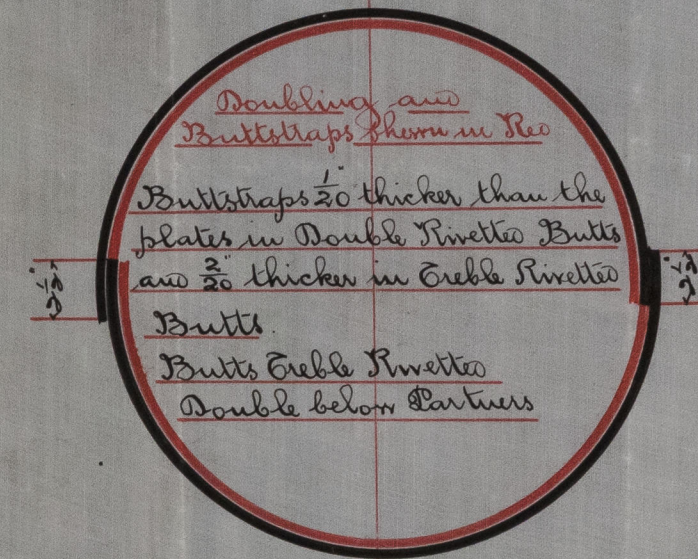

Keels efficiently strengthened

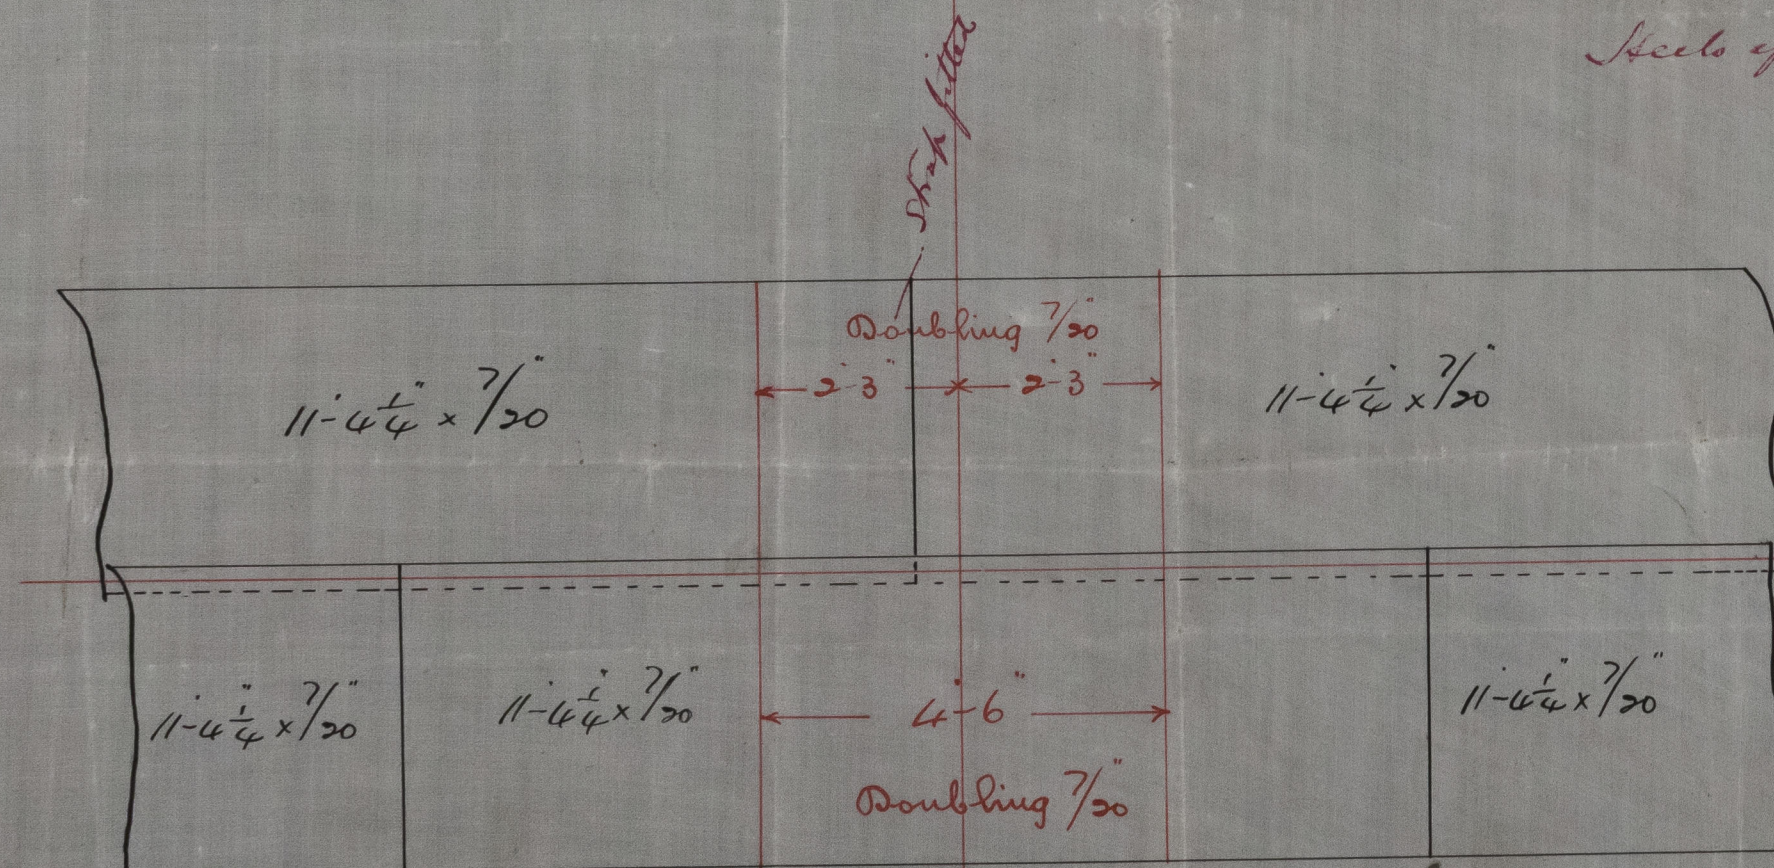

11/3/91

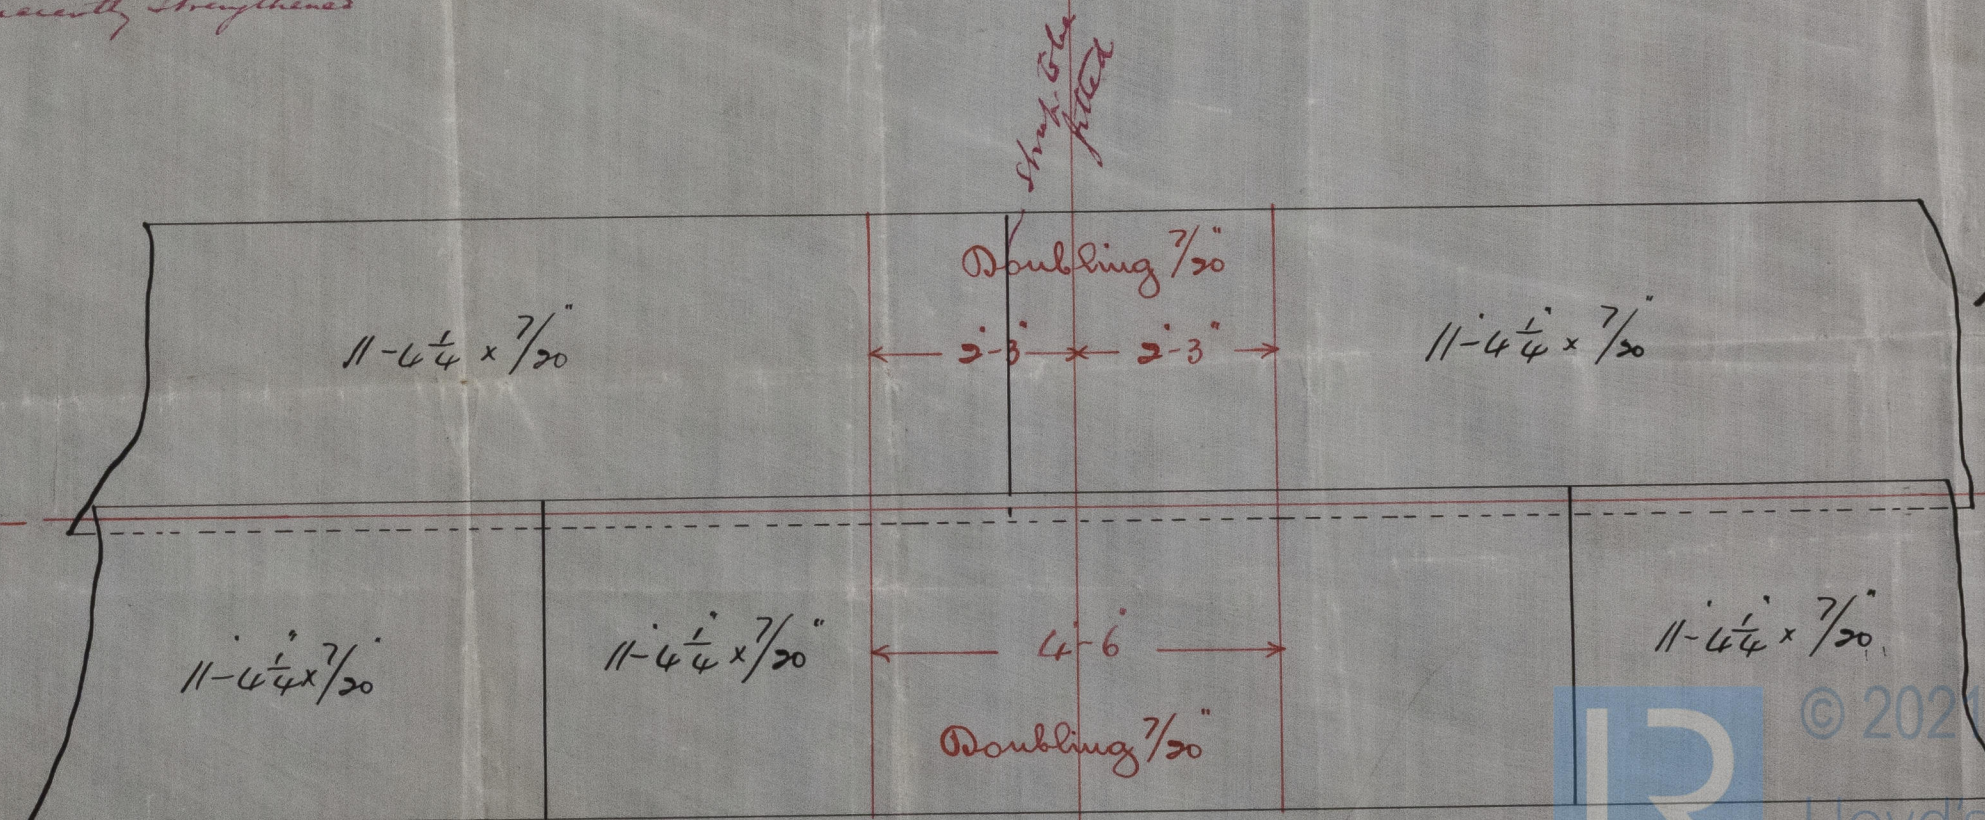

9/3/91



No 657 & 658

NWC821-0179


Warts.

"Francesco Crispi"


Two reports

26/2/24


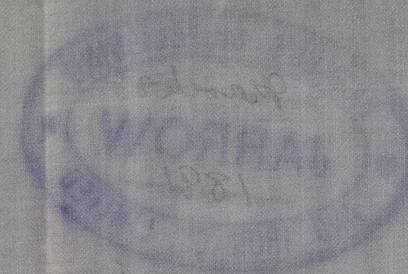


17.3.11

 


 


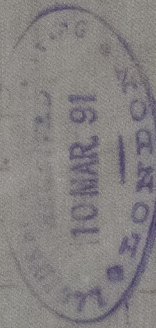






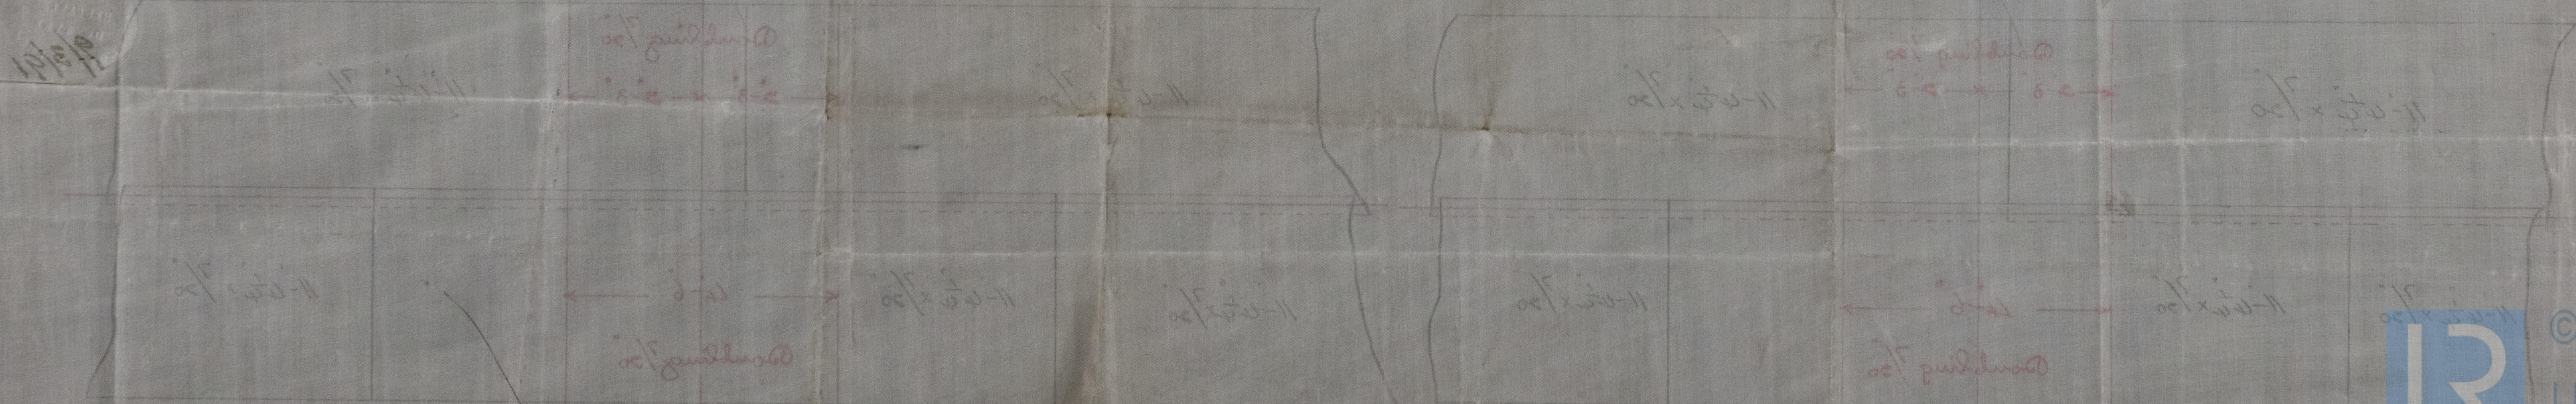

© 2021  
Lloyd's Register  
Foundation