

Lloyd's Register of British and Foreign Shipping.

(Report on Vessel No. 26204 Port Newcastle)

No. 598 SHIP FORGINGS OR CASTINGS.

The words FORGINGS or CASTINGS, IRON or STEEL, should be struck-out as may be required.

I have to report that the undermentioned Iron ~~or Steel~~ Forgings ~~or Castings~~, manufactured by

The Palmer & S Co of Jarrow

for the Vessel No. 657, being built by The Palmer & S Co

of Jarrow have been inspected by me as set forth below, and found to be, so far as can be seen, sound

Mark on Forgings.


Lloyd's  
No. 174B  
76

John O Craig  
Newcastle

6/5/91

	STERN FRAME.	RUDDER FRAME.	STEM.
Material*	<u>Scrap Iron</u>	<u>Scrap Iron</u>	<u>Scrap Iron</u>
How made	<u>Forged</u>	<u>Forged</u>	<u>Forged</u>
Dimensions	<u>10 - 6</u>	<u>7 3/4 - 3 3/4</u>	<u>10 - 2 5/8</u>
Process on Inspection	<u>Forged &amp; Smithed</u>	<u>Forged &amp; Smithed</u>	<u>Smithed</u>
Dates when Inspected	<u>Oct 1-10-17</u>	<u>March 4-13</u>	<u>November 26/90</u>
	<u>Nov 6-17/90</u>	<u>April 8-5-22/91</u>	

SKETCHES OF FRAMES SHewing POSITION AND DESCRIPTION OF WELDS OF FORGINGS, OR PARTICULARS OF TESTS APPLIED TO CASTINGS.

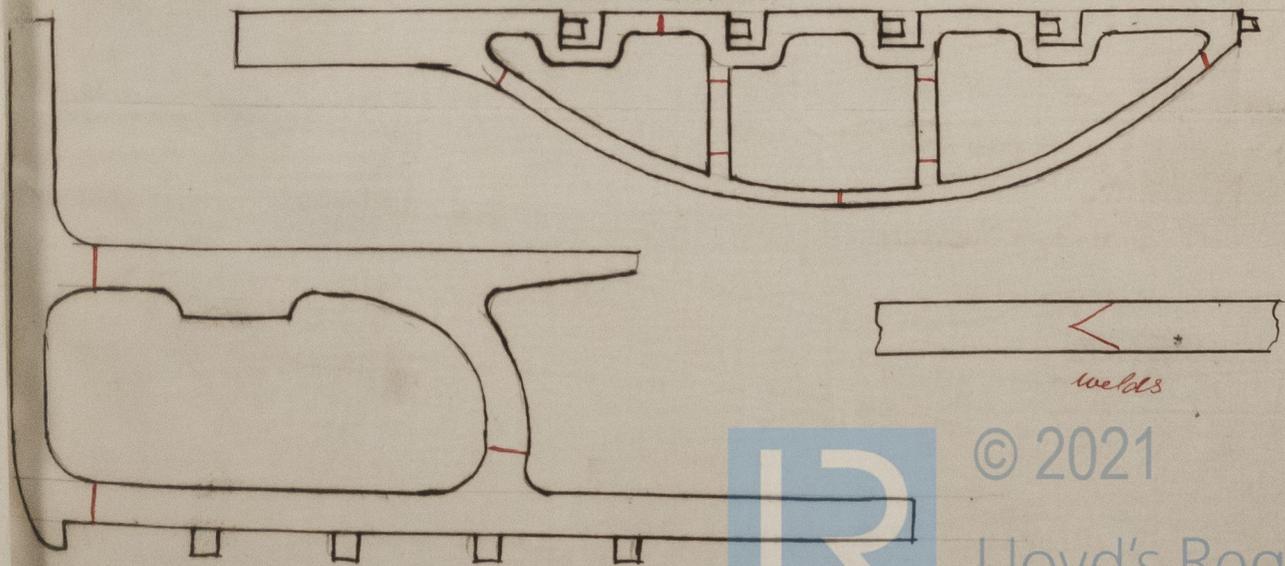

\* If of Iron, state whether scrap or puddled Iron.



NW 921-0182