

Lloyd's Register of British and Foreign Shipping.

(Report on Vessel No. 26361 Port Newcastle)No. 599 SHIP FORGINGS OR CASTINGS.I have to report that the undermentioned Iron ~~or Steel~~ Forgings ~~or Castings~~, manufactured byThe Palmer S & I Co of Jarrowfor the Vessel No. 658, being built by The Palmer S & I Coof Jarrow have been inspected by me as set forth below, and found to be, so far as can be seen, sound


Mark on Forgings.


Lloyd's

No. 199B86John C CraigNewcastle6/5/91

	STERN FRAME.	RUDDER FRAME.	STEM.
Material* - - -	<u>Scrap Iron</u>	<u>Scrap Iron</u>	
How made - - -	<u>Forged</u>	<u>Forged</u>	
Dimensions - - -	<u>10-6</u>	<u>7$\frac{3}{4}$-3$\frac{3}{4}$</u>	
Progress on Inspection -	<u>Forged & Smithed</u>	<u>Forged & Smithed</u>	<u>Not Seen</u>
Dates when Inspected	<u>Oct 12-30 Nov 6-17</u> <u>25 December 9-17/90</u>	<u>March 4-13</u> <u>April 8-15-22/91</u>	

SKETCHES OF FRAMES SHEWING POSITION AND DESCRIPTION OF WELDS OF FORGINGS, OR PARTICULARS OF TESTS APPLIED TO CASTINGS.

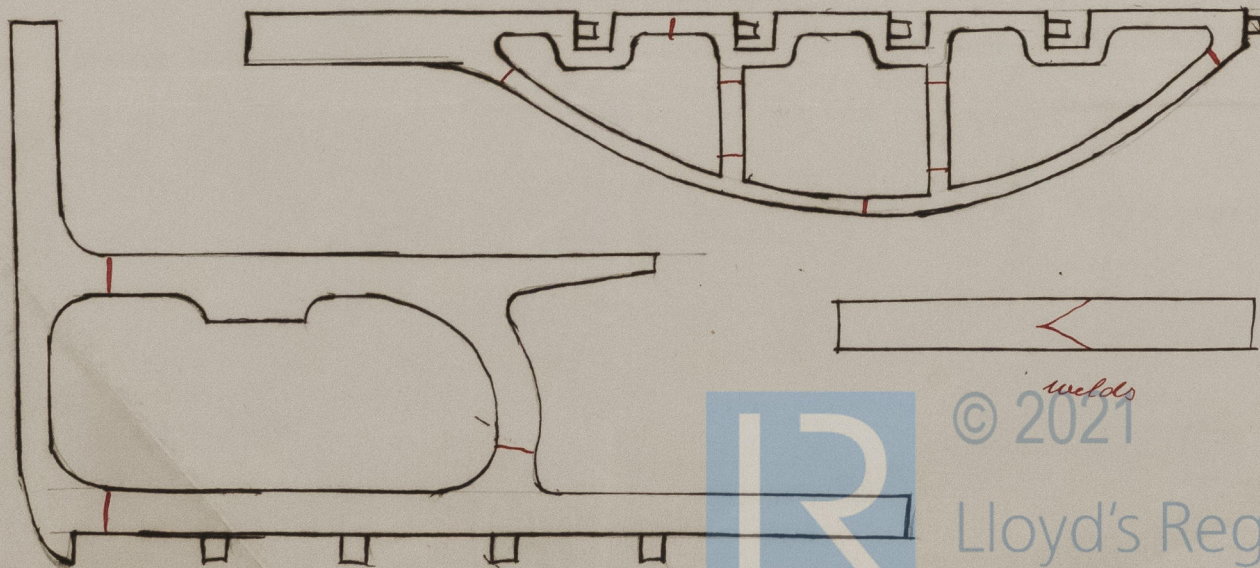

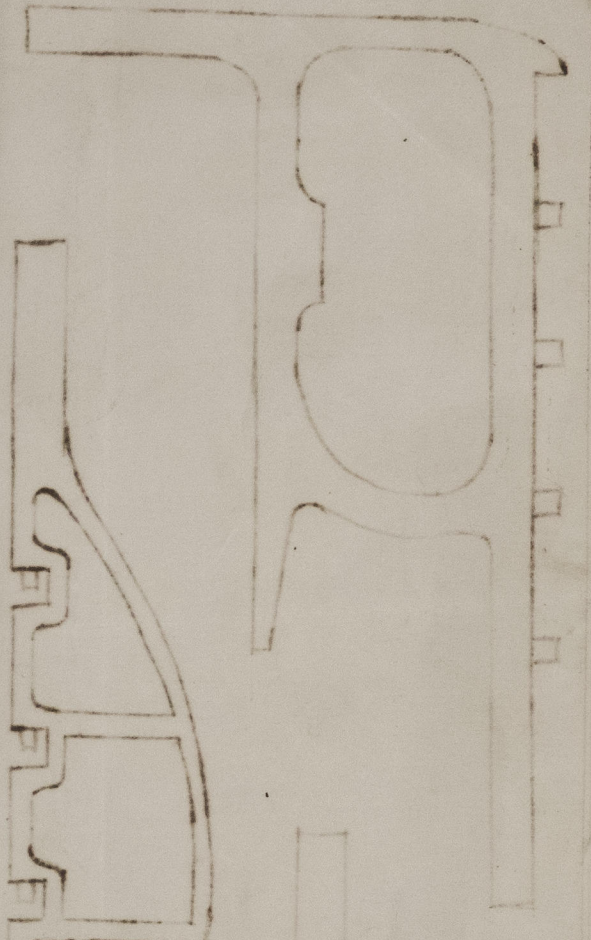



100

[Faint handwritten notes, possibly bleed-through from the reverse side.]

1840
 1841
[Faint handwritten notes, possibly bleed-through from the reverse side.]

Palmer 658

1840

James M. Smith