

Lloyd's Register of British and Foreign Shipping.

(Report on Vessel No. 26445 Port Newcastle)

No. 811

SHIP FORGINGS OR CASTINGS.

The words FORGINGS or CASTINGS, IRON or STEEL, should be struck out as may be required.

I have to report that the undermentioned Iron ~~or Steel~~ Forgings ~~or Castings~~, manufactured by Messrs J & G Joicey of Newcastle for the Vessel No. 57, being built by Messrs Edwards & B Co of Howdon have been inspected by me as set forth below, and found to be, so far as can be seen, sound

Mark on Forgings.


Lloyd's
No. 22615
JG

John C Craig
Newcastle

10/2/91

	STERN FRAME.	RUDDER FRAME.	STEM.
Material*	Scrap Iron	Scrap Iron	Scrap Iron
How made	Forged	Forged	Forged
Dimensions	10-6	8-4	10-2 3/4
Progress on Inspection	Forged & Smithed	Forged & Smithed	Smithed
Dates when Inspected	Jan 16-24-27 Feb 12 19-26 April 8-16/91	June 3-12-17 July 1 August 4-21/91	April 8/91

SKETCHES OF FRAMES SHEWING POSITION AND DESCRIPTION OF WELDS OF FORGINGS, OR PARTICULARS OF TESTS APPLIED TO CASTINGS.

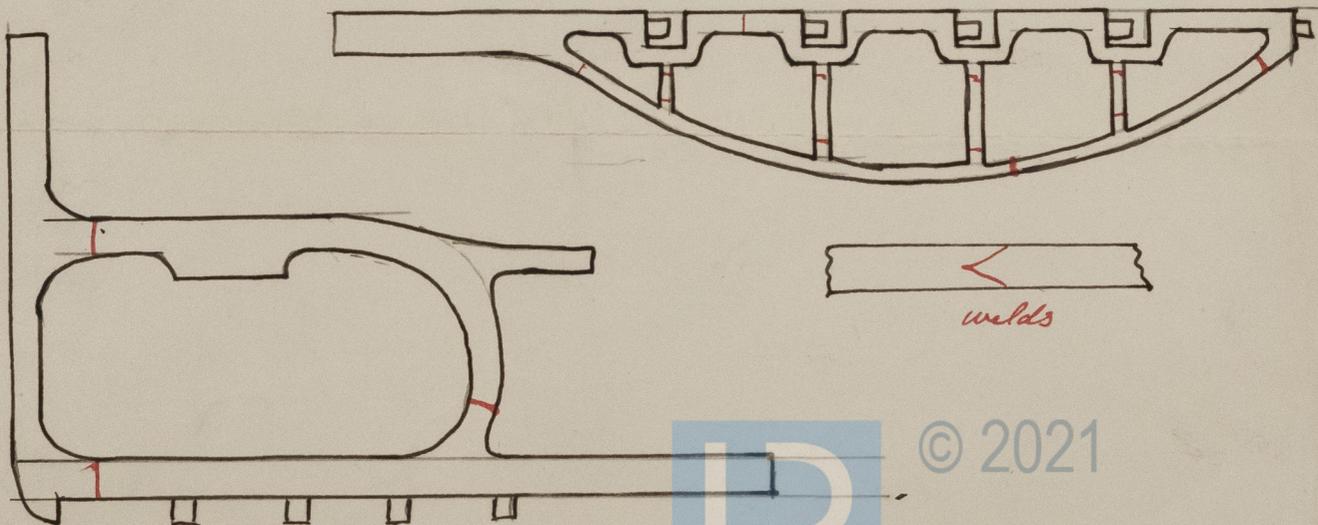

* If of Iron, state whether scrap or puddled Iron.

Edwards
5-4

[Faint, illegible handwritten text, possibly bleed-through from the reverse side of the page]

[Faint, illegible handwritten text]

[Faint, illegible handwritten text]

[Faint, illegible handwritten text]



© 2021
Lloyd's Register
Foundation