


# MIDSHIP SECTION

"Penwell Tower"

S.S. No 57

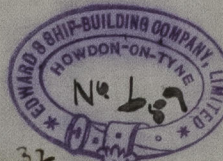

6/11/90

PROPOSED FREE-BOARD 6'-6"  
FROM TOP OF WOOD DECK  
IF SHEATHED

1/2 GIRTH 37'32"  
1/2 BREADTH 19'95"  
DEPTH 22'58"

1/2 GIRTH = 37'32"  
1/2 BREADTH = 20'00"  
DEPTH = 22'58"  
25179-1005 25179-31533 25179-7990-121N9  
25179-31533 25179-7990-121N9

D. TO L. = 10'44" TO SPAR DECK  
D. TO L. = 13'964" TO MAIN DECK  
B. TO L. = 7'88"

BRIDGE POOP BEAMS = 6 1/2 x 3 x 8/20 BULB ANGLE ALT. FRAMES  
F'CLE BEAMS = BULB 7 x 7/20 & 2 BARS 3 x 3 x 4/20

Side plates of poop bridge of fore castle 7/20

TO CLASS 100.A.1.

## EQUIPMENT


2 BOWERS	36 1/2 CWTs EX. STOCK
1 " "	31 " " "
1 STREAM	11 1/4 " " "
1 KEDGE	5 1/2 " " "
1 " "	2 3/4 " " "
300 FATHOMS	1 15/16 STUO CHAIN CABLE 60
90 "	1 1/2 STREAM CHAIN
100 "	4 TOWLINE
100 "	10 HAWSER
100 "	8 1/2 WARP

## EQUIPMENT No

1/2 GIRTH: 44-94  
1/2 BEAM = 19-95  
DEPTH = 30-20

LENGTH OF ERECTIONS 168 FEET  
COMBINED LENGTH OF POOP & BRIDGE  
UNDER 2 1/2 TH LENGTH OF VESSEL

2998872-9 = No IF FLUGH DECK  
1987 = APP. FOR ERECTIONS  
31971-72 = EQ. No

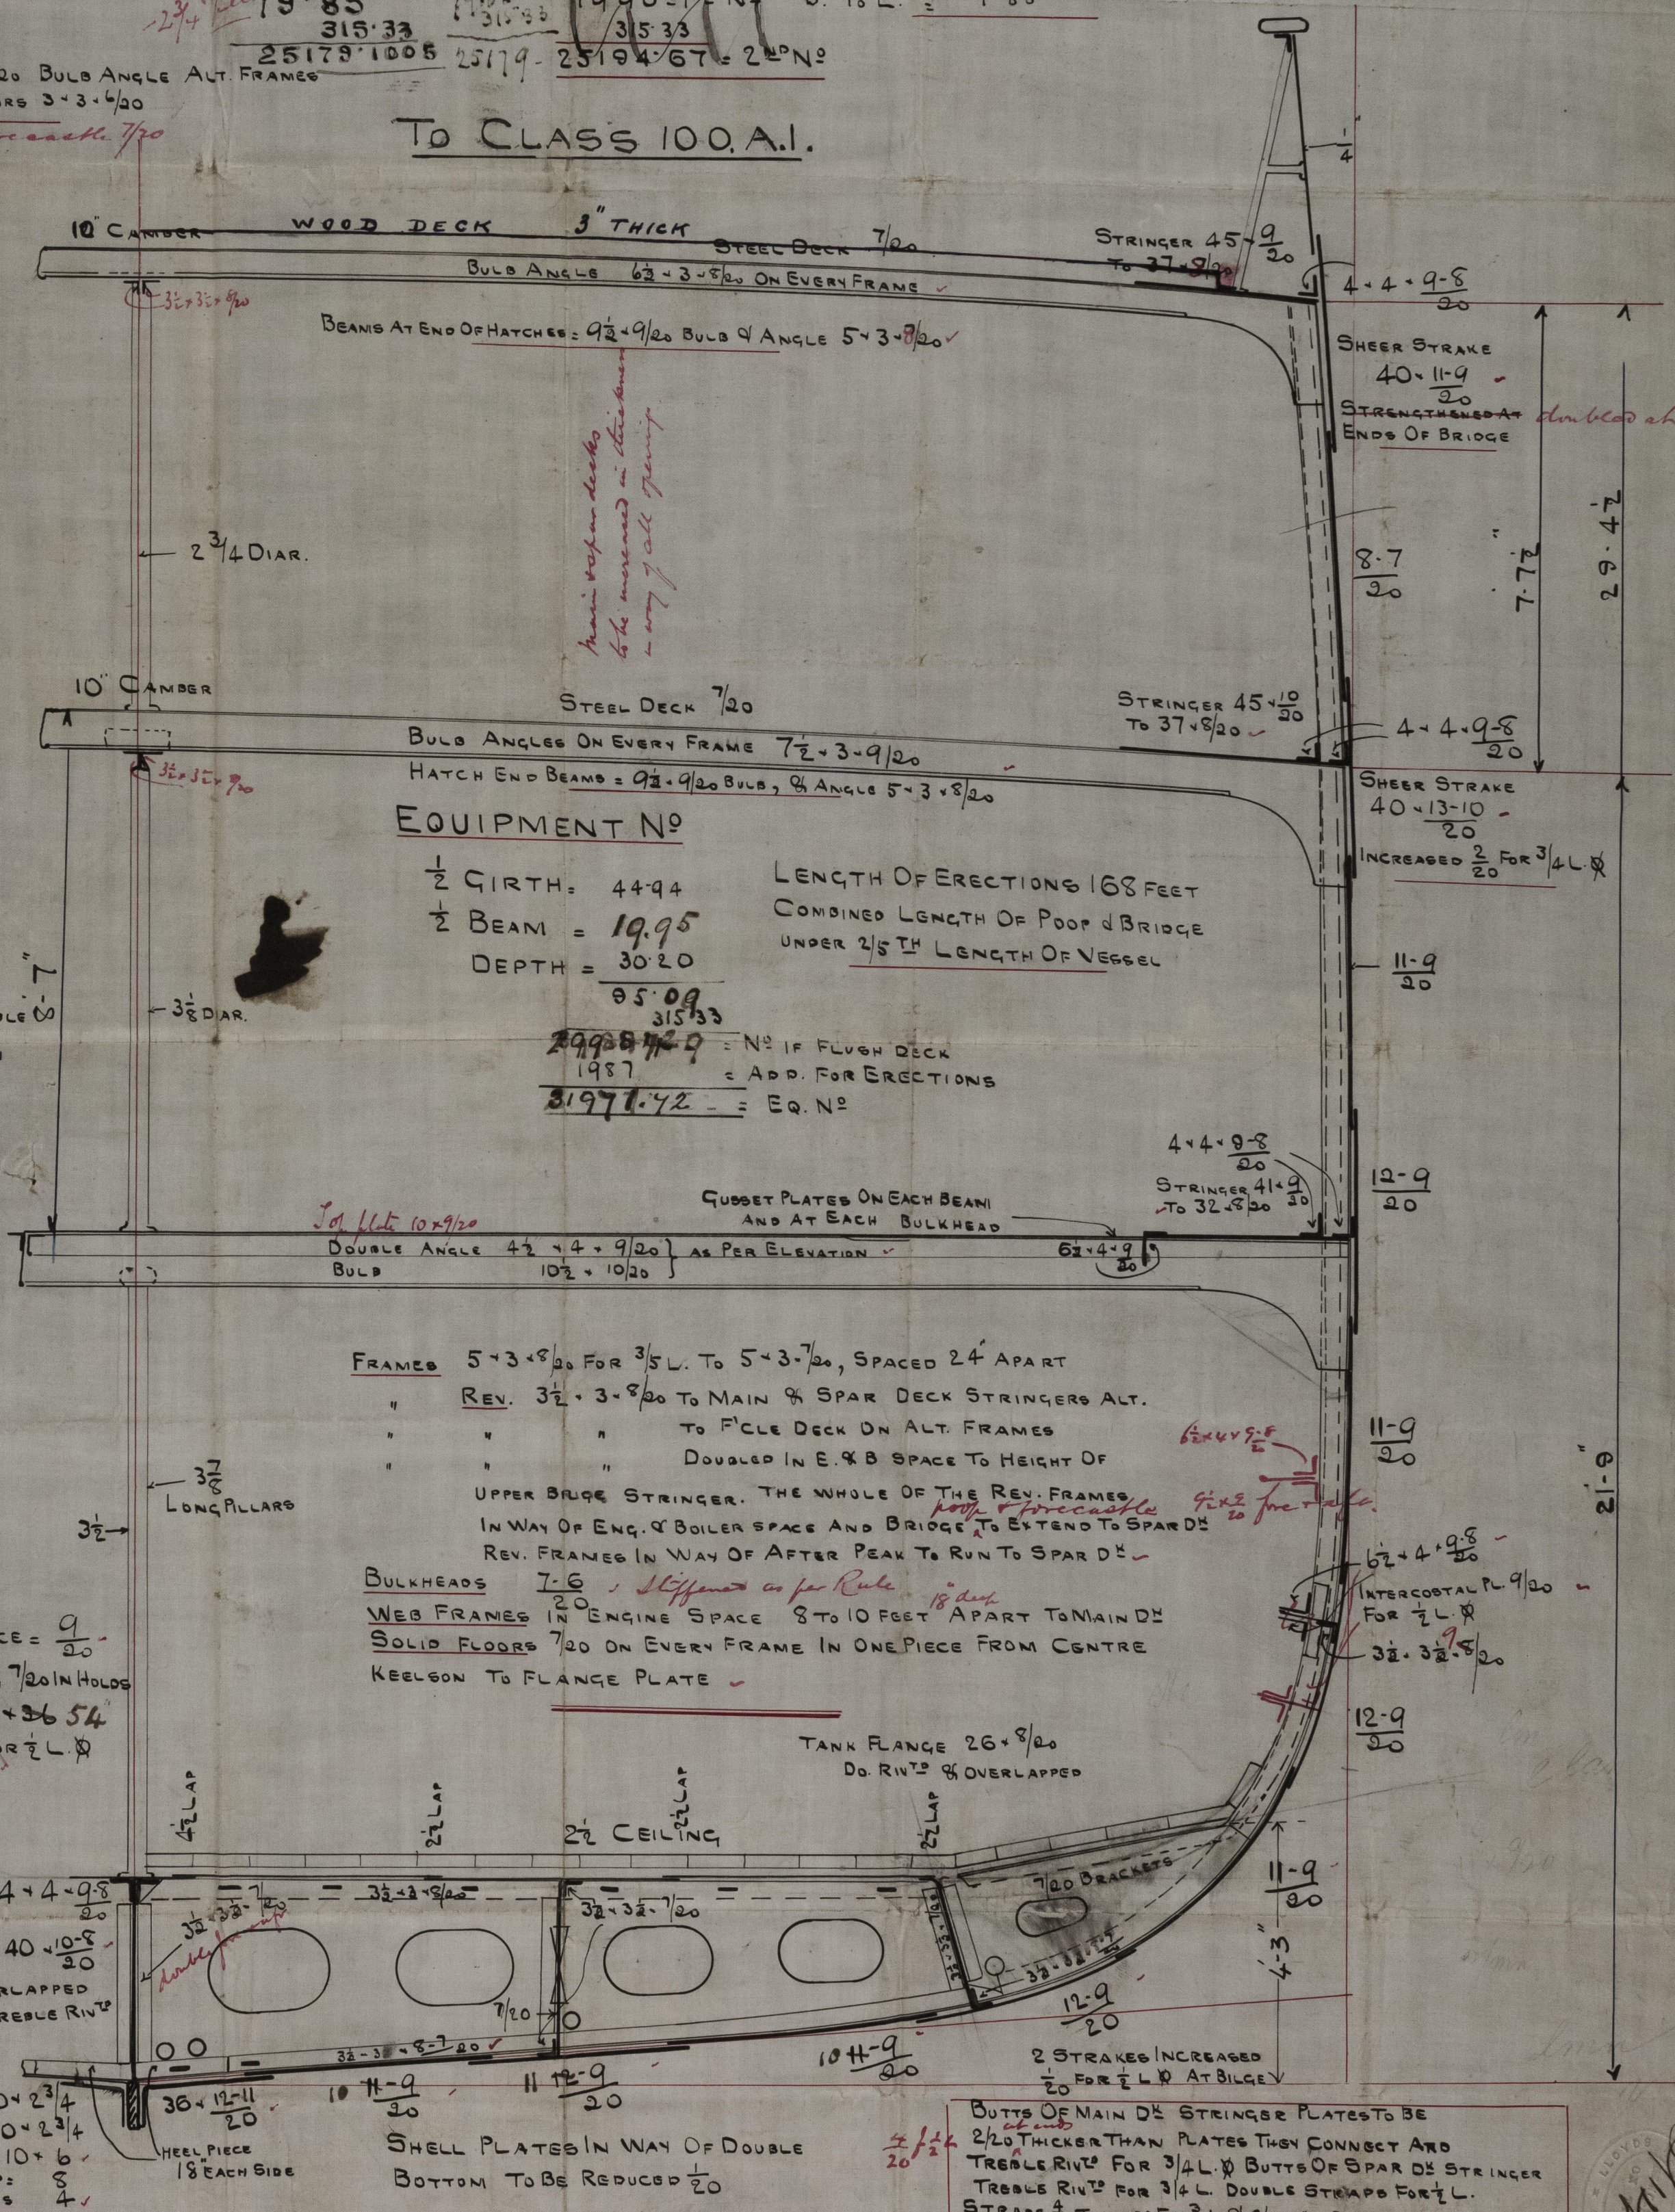

TANK TOP IN E. & B. SPACE = 9/20  
INNER BOTTOM PLATING 7/20 IN HOLDS  
CENTRE STRAKE 9-8 x 36 5/4  
BUTTS DOUBLE RIVTS FOR 1/2 L. &  
SINGLE AT ENDS

BAR KEEL = 10 x 2 3/4  
STEM = 10 x 2 3/4  
STERN POST = 10 x 6  
RUDDER HEAD = 8  
HEEL & PINTLES 4

SHELL PLATES IN WAY OF DOUBLE  
BOTTOM TO BE REDUCED 1/20

BUTTS OF MAIN DECK STRINGER PLATES TO BE  
2/20 THICKER THAN PLATES THEY CONNECT AND  
TREBLE RIVTS FOR 3/4 L. BUTTS OF SPAR DECK STRINGER  
TREBLE RIVTS FOR 3/4 L. DOUBLE STRAPS FOR 1/2 L.  
STRAPS 1/2 THICKER FOR 3/4 L. 2/20 AT ENDS  
BUTT STRAPS OF SHELL PLATING TO BE TREBLE RIVTS  
FOR 3/4 L. THE BACK ROW OF RIVETS MAY BE SPACED  
FROM 5 TO 5 1/4 DIAS APART  
THE BUTT STRAPS FOR 1/2 L. TO BE 4/20 THICKER THAN PLATES  
AND THE REMAINING STRAPS 2/20 THICKER THAN PLATES  
THEY CONNECT

10/11/90



MIDSHIP

2.2 No

Proposed Free-board  
From top of Wood Deck  
If weathered

27.32

27.32

Mid: Section

S. S. Benwell Lower  
New Freeboard report

No 26342

EQUIPMENT

Bowers

365 Cwts Ex Stock

" " "

" " "

" " "

" " "

" " "

" " "

" " "

" " "



© 2021

Lloyd's Register  
Foundation