



# PIPE PLAN No 57 $\frac{1}{8}'' = 1'-0''$

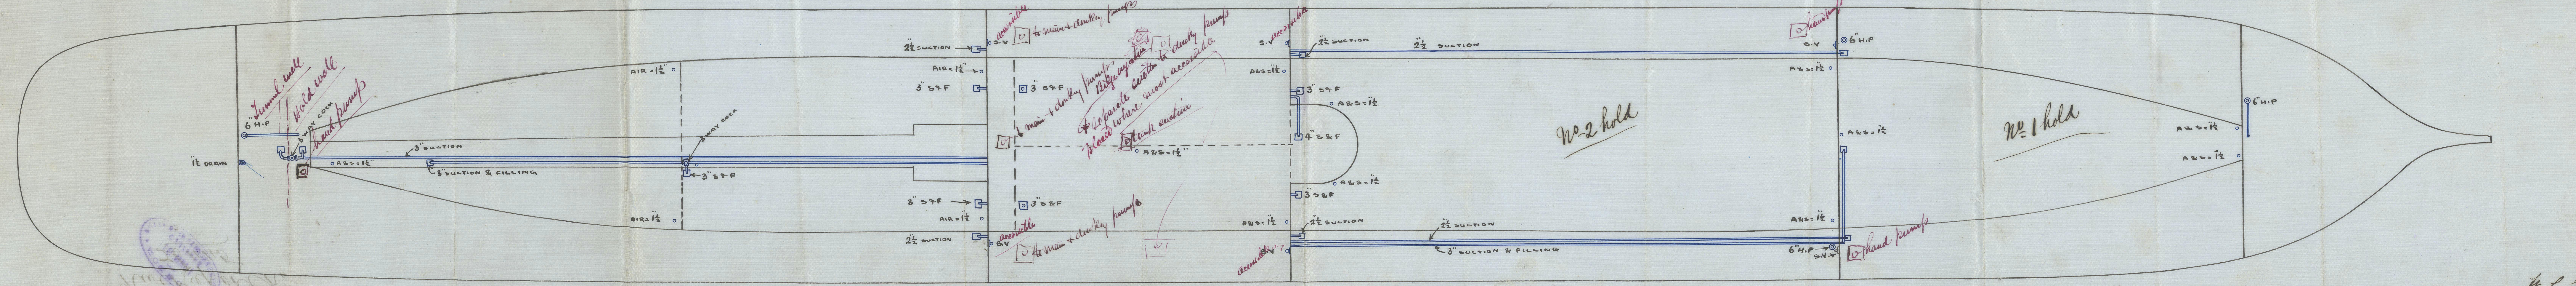

Rev. 22.12.90  
 7/1/91



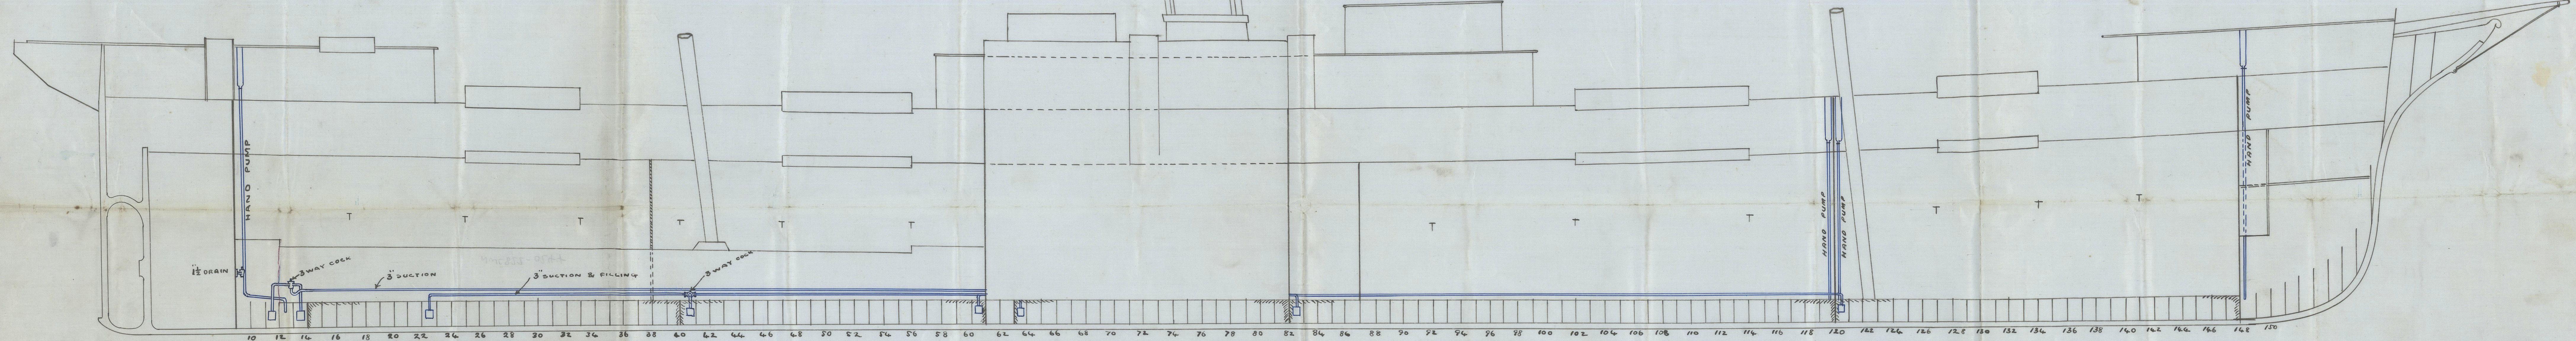


NA  
 1-1-91



57  
Pumping

S. Benwell Tower  
New Report No

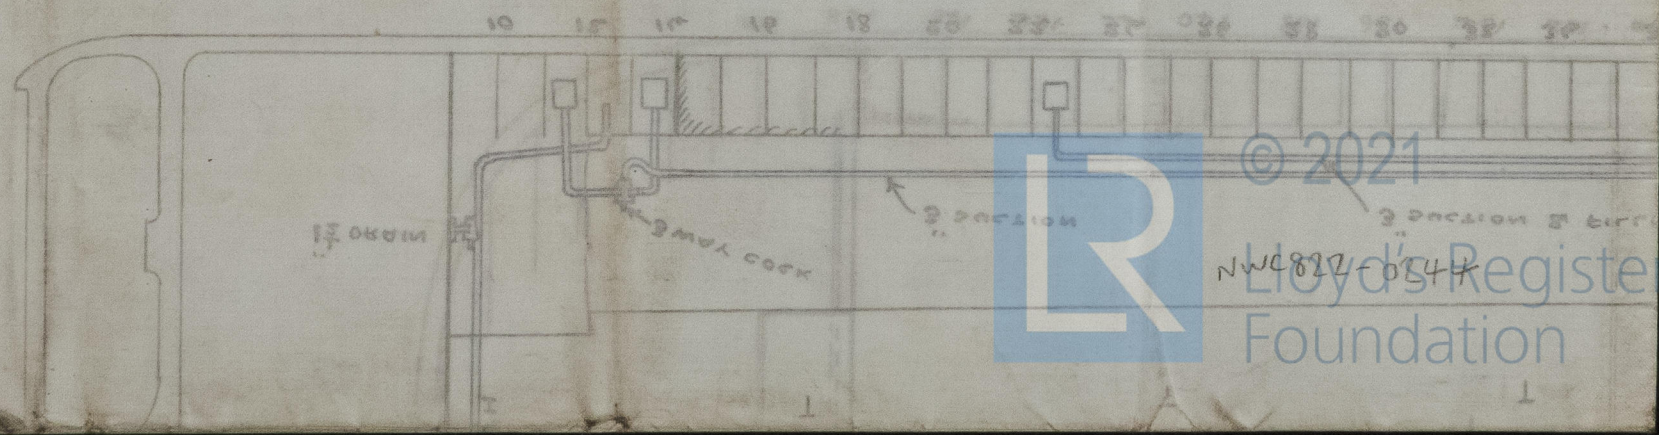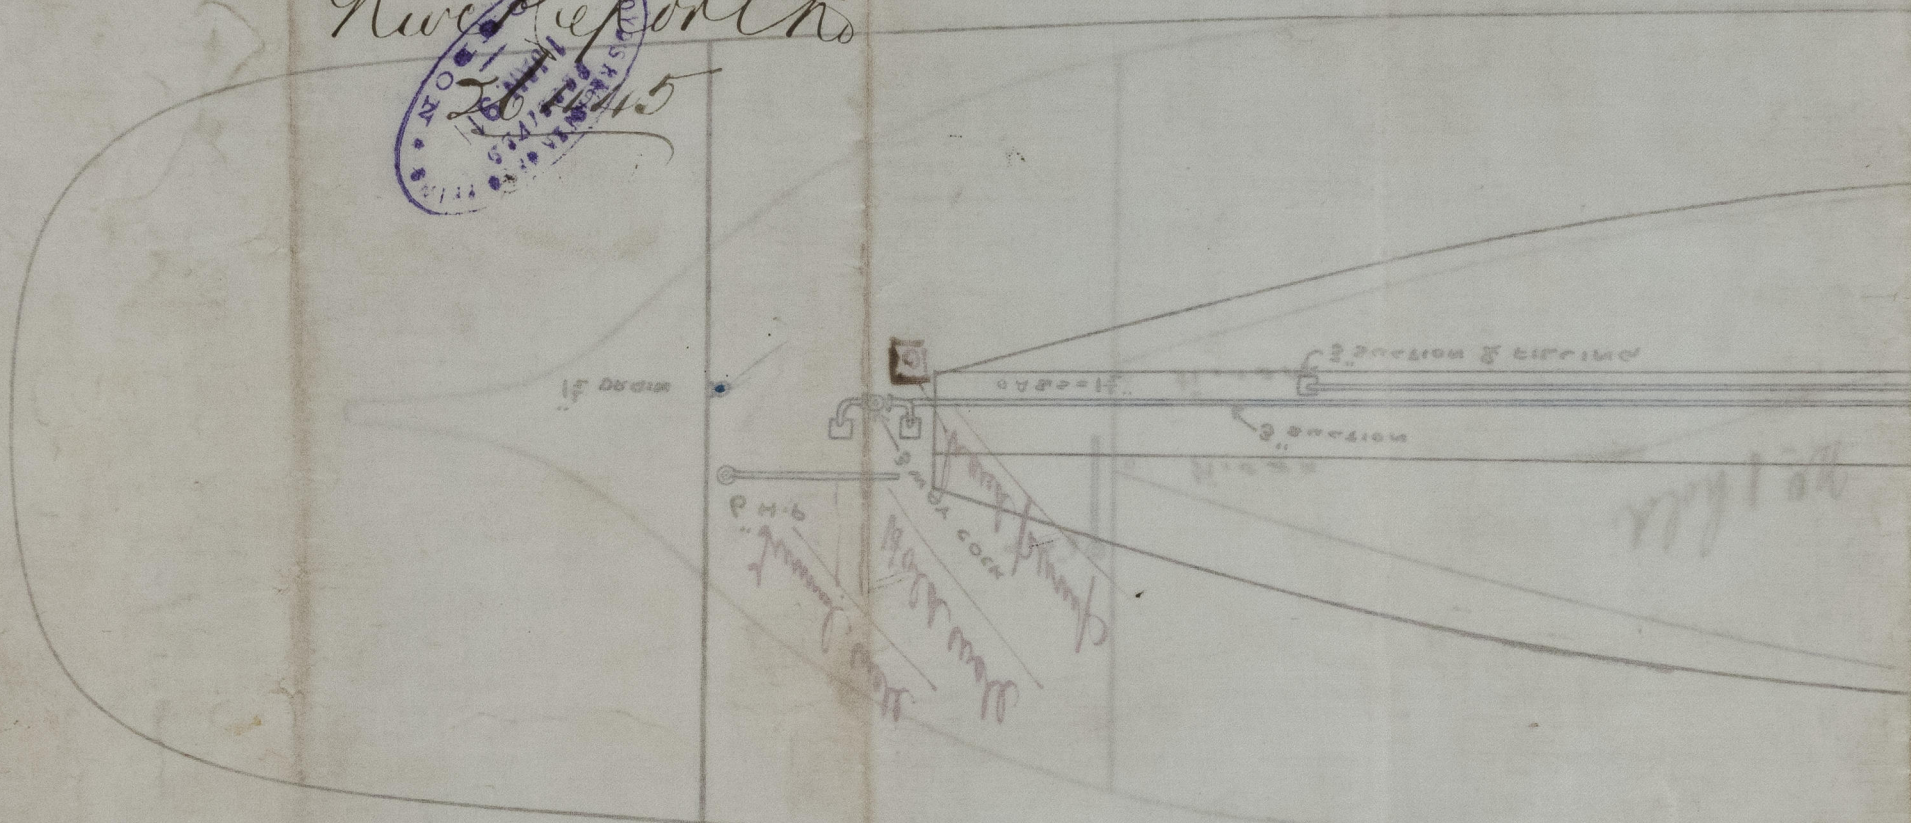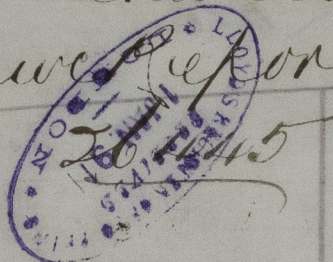

© 2021

Lloyd's Register  
Foundation