


N<sup>os</sup> 48-9 SHIPS

SCALE  $\frac{1}{8}'' = 1 \text{ FOOT}$

Ms. 4.9.9

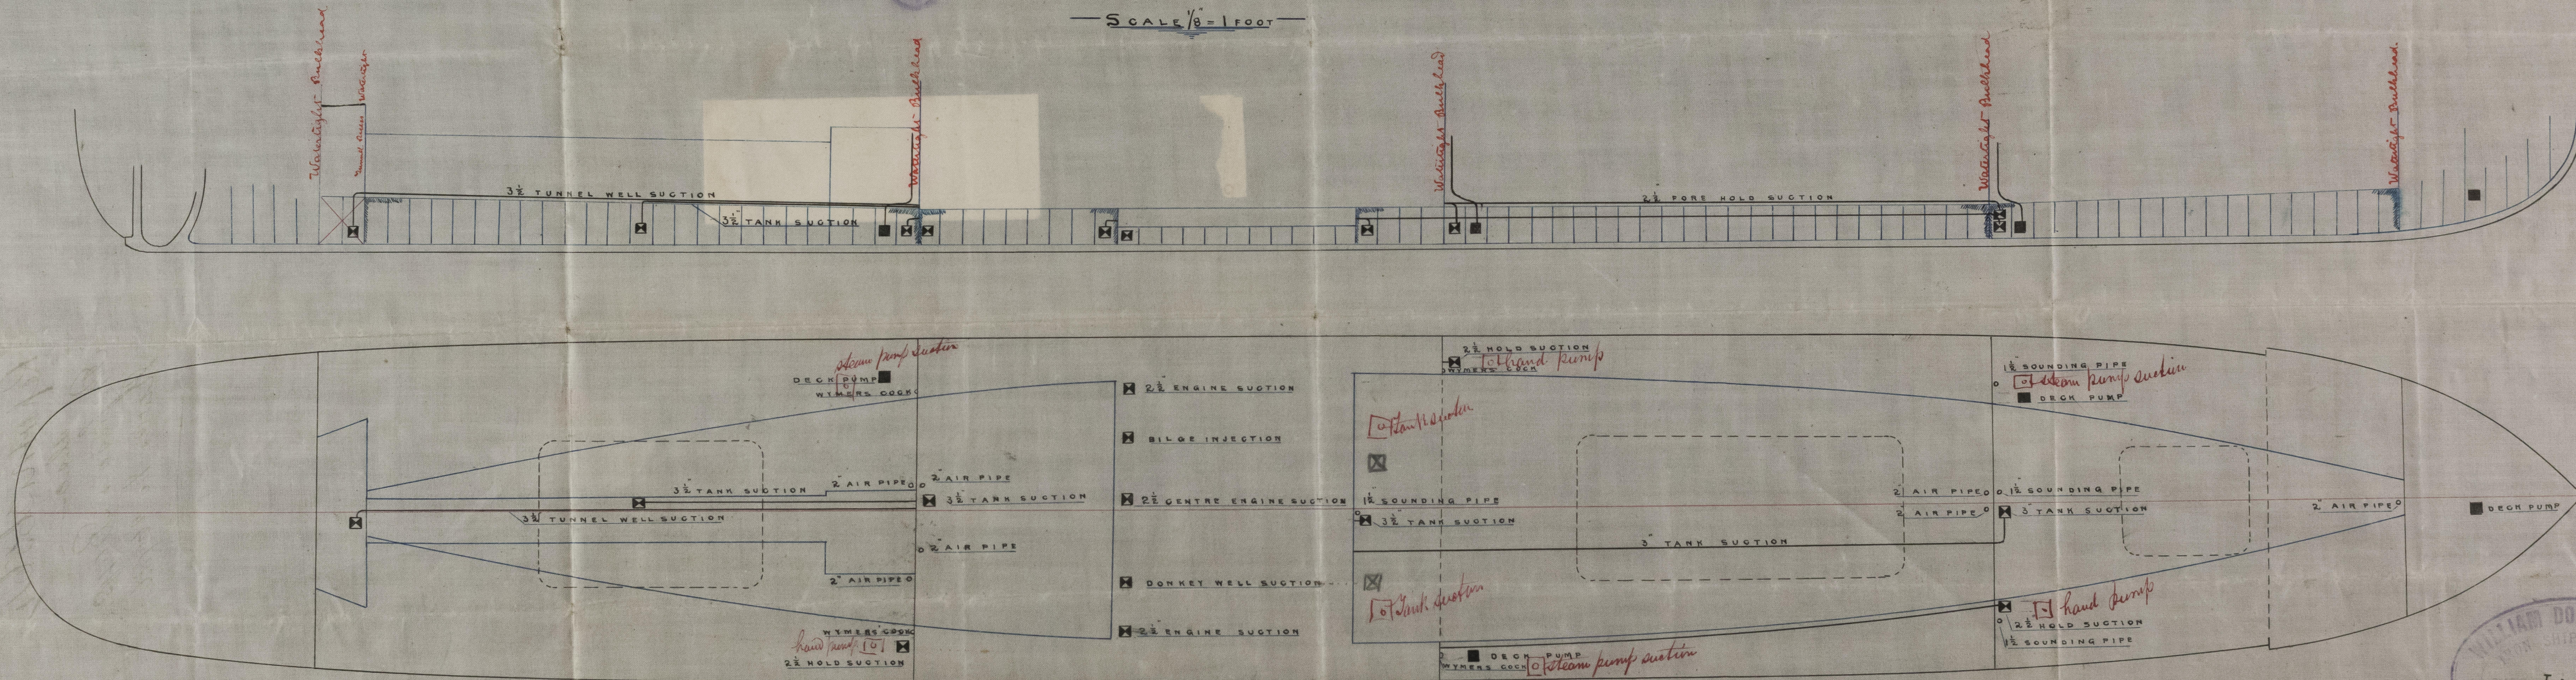

W.A.  
9.7.91



Lloyd's Register  
Foundation  
NWC823-002072



NWC 823-0020 2/2

WM. DOBSON & Co., LOW WALKER.

ENCLOSURE

FOR

Miss Lloyd's Survey

Newcastle upon Tyne





Newcastle  
Report 36564  
also  
Professor. Bayes.  
Newcastle 26486.

July 3rd 1891

19/7/91

NWC823-0020 1/2

NWC823-0020 2/2  
WM. DOBSON & CO., LOW WALKER.  
ENCLOSURE  
Messrs Lloyd's Register  
Newcastle-on-Tyne

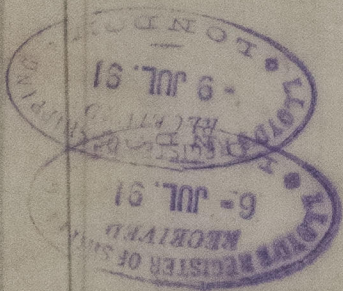

—N0248-9 SHIP  
—SECTION PLAN

—SCVFE 18-11001—

© 2021

Lloyd's Register  
Foundation