
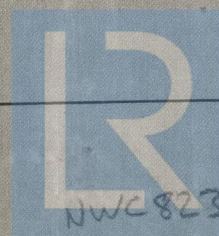
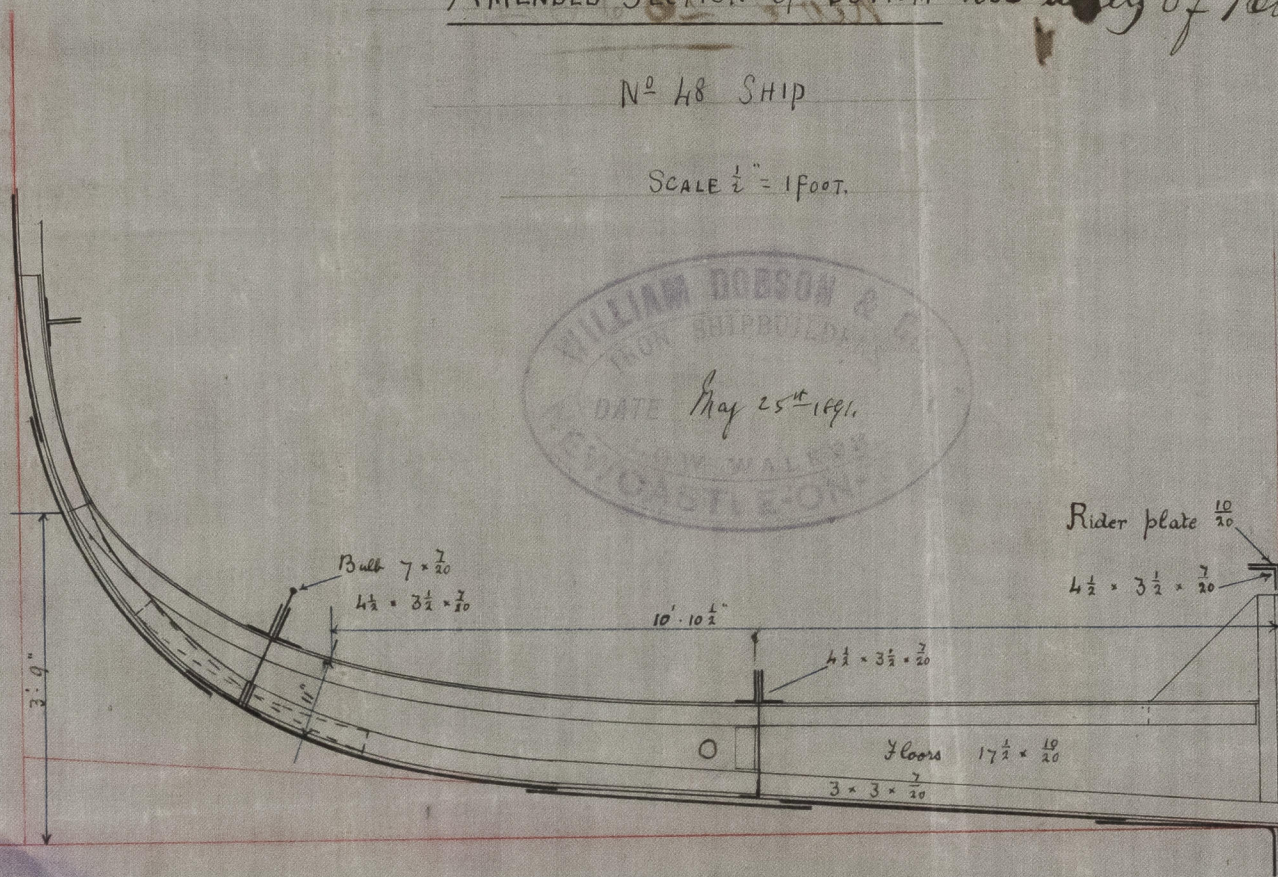


"Minister Tak van Poortvliet"

AMENDED SECTION OF BOTTOM in way of Boilers

N^o 48 SHIP

SCALE $\frac{1}{2}$ " = 1 foot.

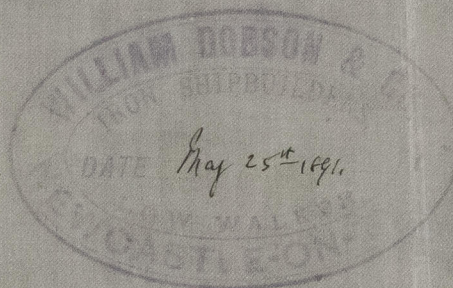

© 2021

Lloyd's Register
Foundation

NWC 823-0023

10/10/90

W. Dobson & Co
78 & 49

Munich Lak van Gootelut

Neve 26564



© 2021



Lloyd's Register
NWC823 0023
Foundation