

Lloyd's Register of British and Foreign Shipping.

(Report on Vessel No. 26564 Port Newcastle)

No. 826

SHIP FORGINGS OR CASTINGS.

The words FORGINGS or CASTINGS, IRON or STEEL, should be struck out as may be required.

I have to report that the undermentioned Iron ~~or Steel~~ Forgings ~~or Castings~~, manufactured by The Jarrow Forge & Co of Jarrow for the Vessel No. 48, being built by Messrs W Dobson & Co of Walter have been inspected by me as set forth below, and found to be, so far as can be seen, sound

Mark on Forgings.


Lloyd's
No. 302B
JB

John C Craig
Newcastle

19/9/91

	STERN FRAME.	RUDDER FRAME.	STEM.
Material*	<u>Scrap Iron</u>	<u>Scrap Iron</u>	<u>Scrap Iron</u>
How made	<u>Forged</u>	<u>Forged</u>	<u>Forged</u>
Dimensions	<u>7-4 1/2</u>	<u>5-3</u>	<u>7-2 1/4</u>
Progress on Inspection	<u>Forged & Smithed</u>	<u>Forged & Smithed</u>	<u>Smithed</u>
Dates when Inspected	<u>May 1-5-12-22/91</u>	<u>July 2-30 Aug 7 11-18/91</u>	<u>June 2/91</u>

SKETCHES OF FRAMES SHEWING POSITION AND DESCRIPTION OF WELDS OF FORGINGS, OR PARTICULARS OF TESTS APPLIED TO CASTINGS.

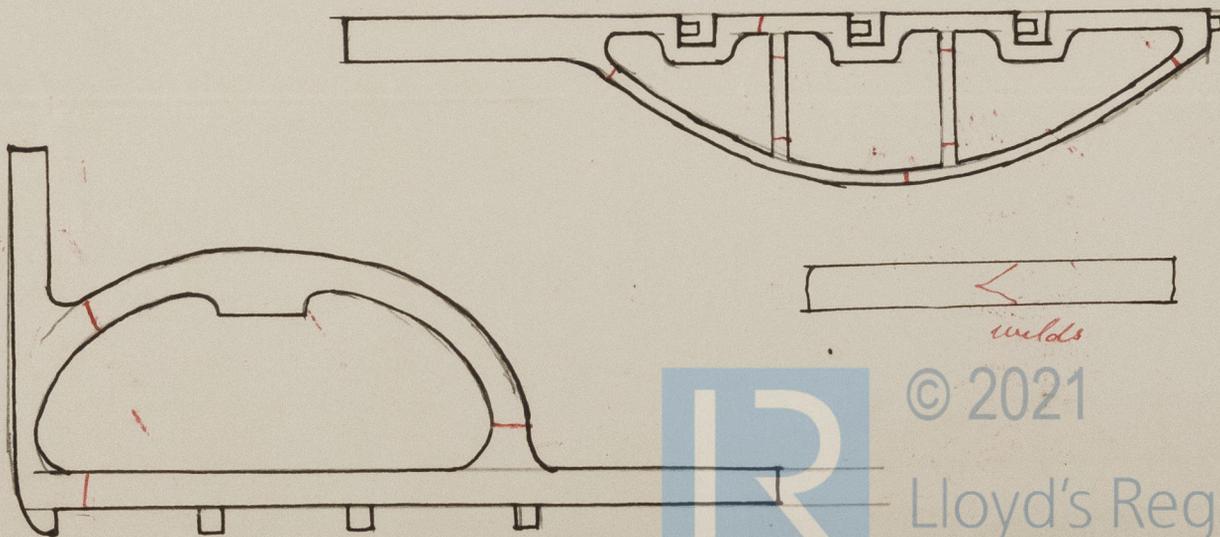

L200-3282M2



© 2021

Lloyd's Register
Foundation

