


PUMPING ARRANGEMENT


— N^o 162 ⁵/₈ —

— SCALE ¹/₄" INCH = ONE FOOT. —

chr
7/9/91

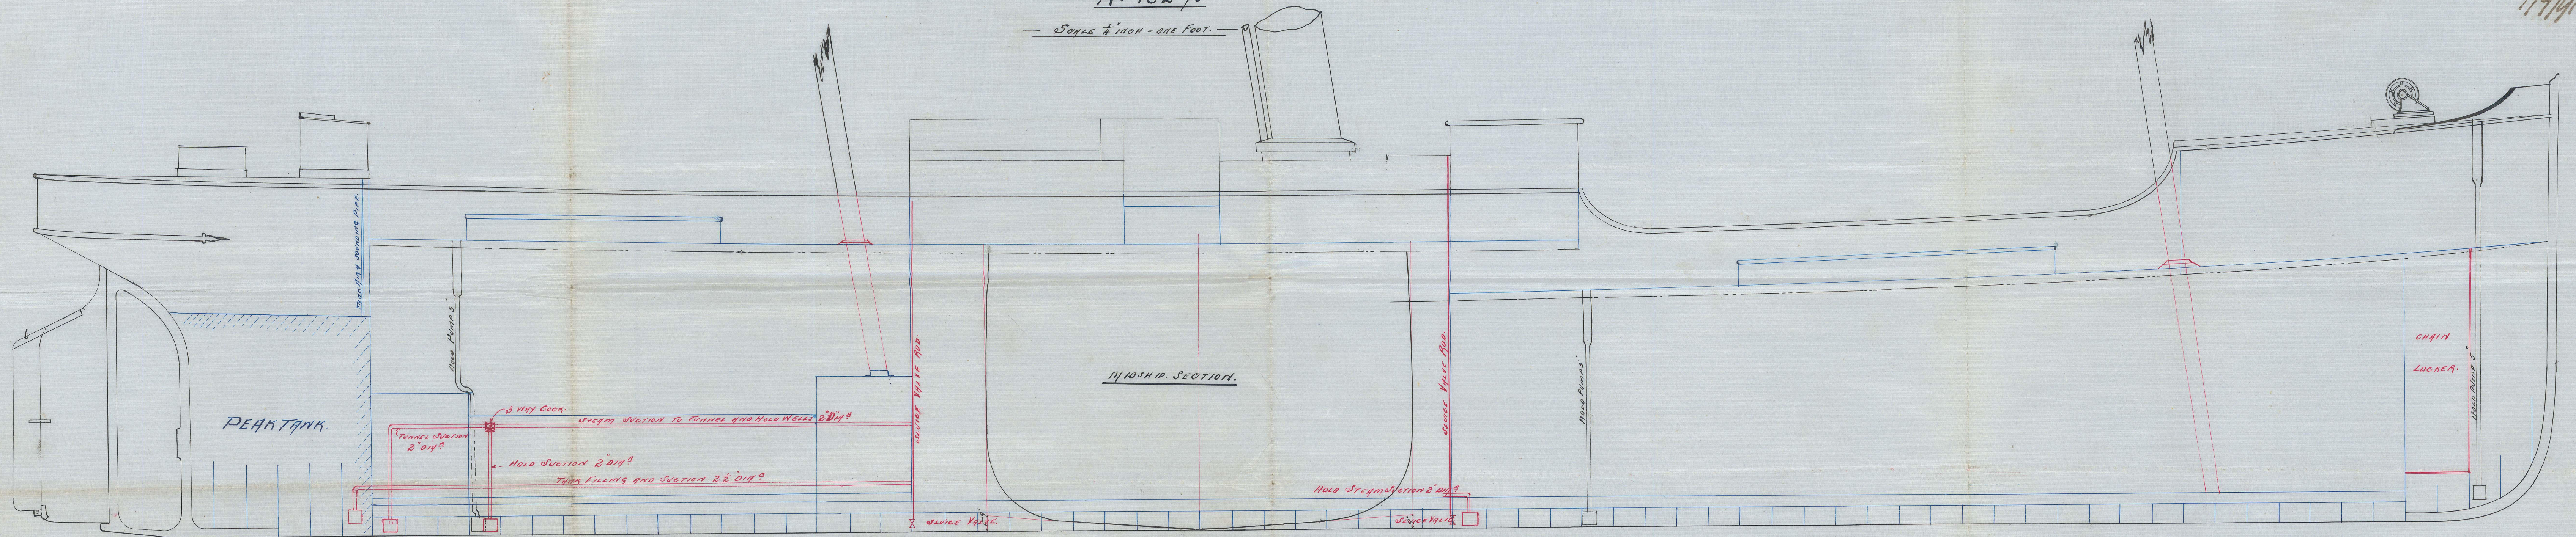

2 1/2\"/>

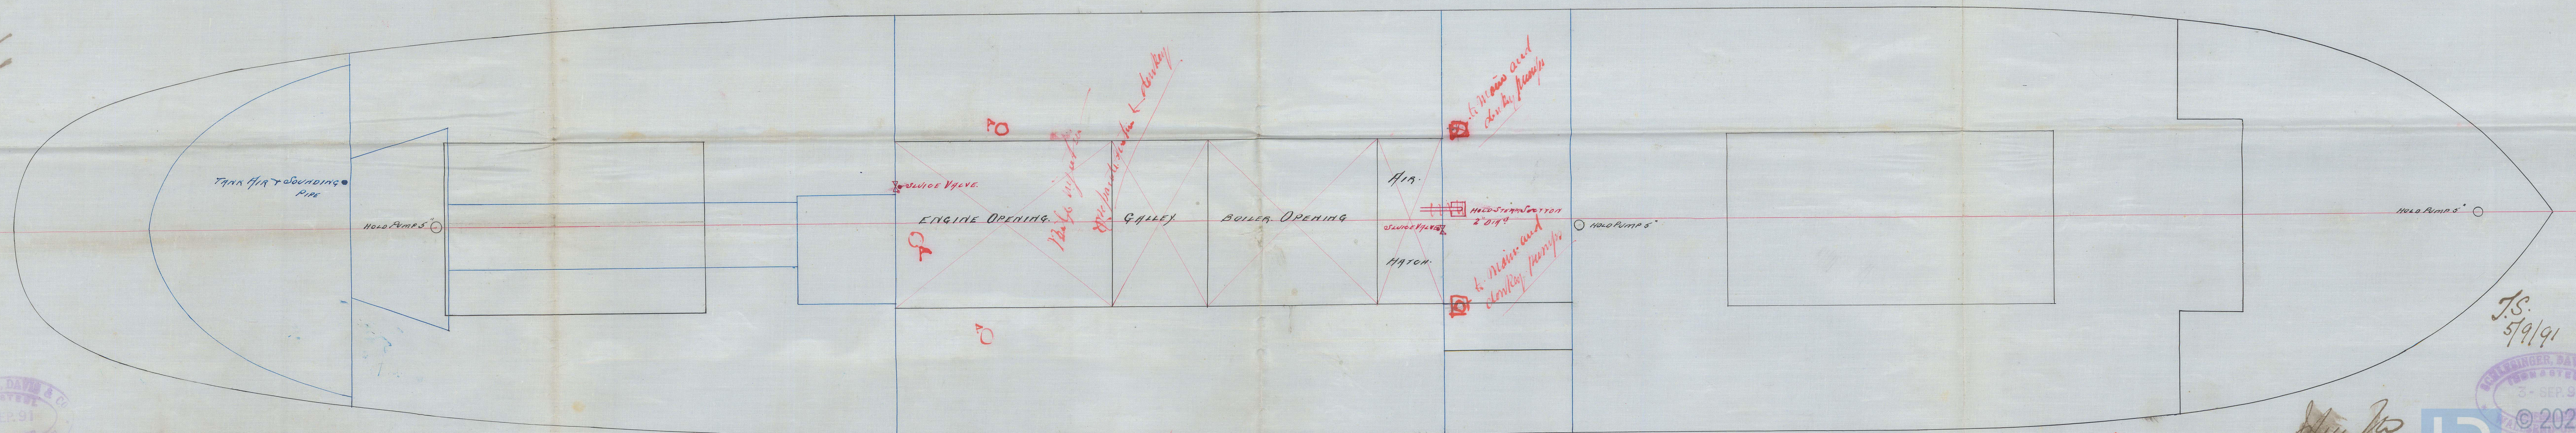

*A. Section to main and donkey
steams pumps.*

*W.A.
7-9-91*

John Peto



SHIELDS & DAVIS & CO
IRON & STEEL
25 SEP 91
WALLSEND-ON-TYNE

J.S.
5/9/91
SHIELDS & DAVIS & CO
IRON & STEEL
25 SEP 91
WALLSEND-ON-TYNE

R
The Register
Foundation

City of London.
New Report No.
96473.

See 4/9/41

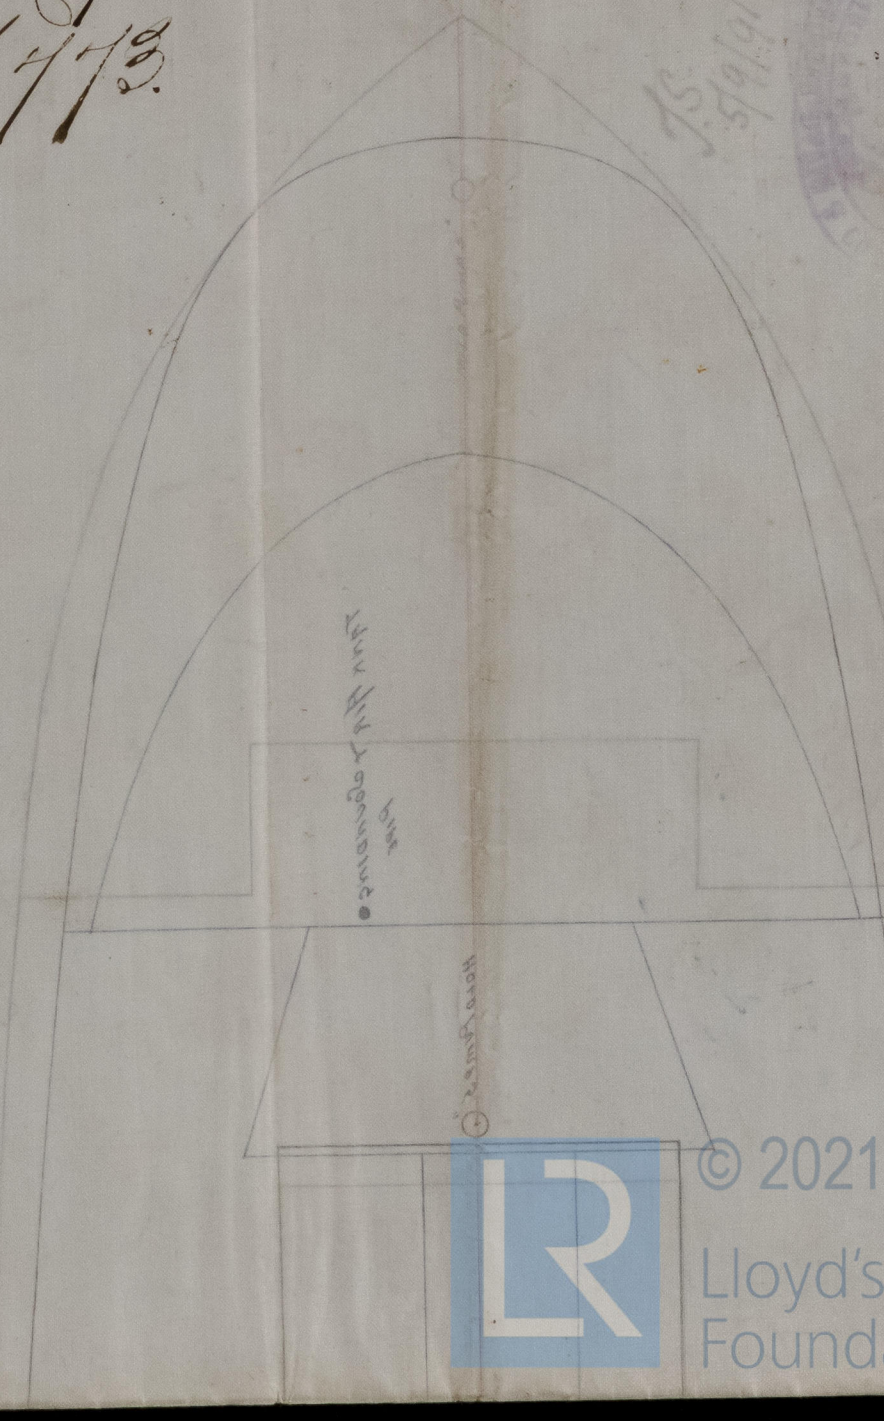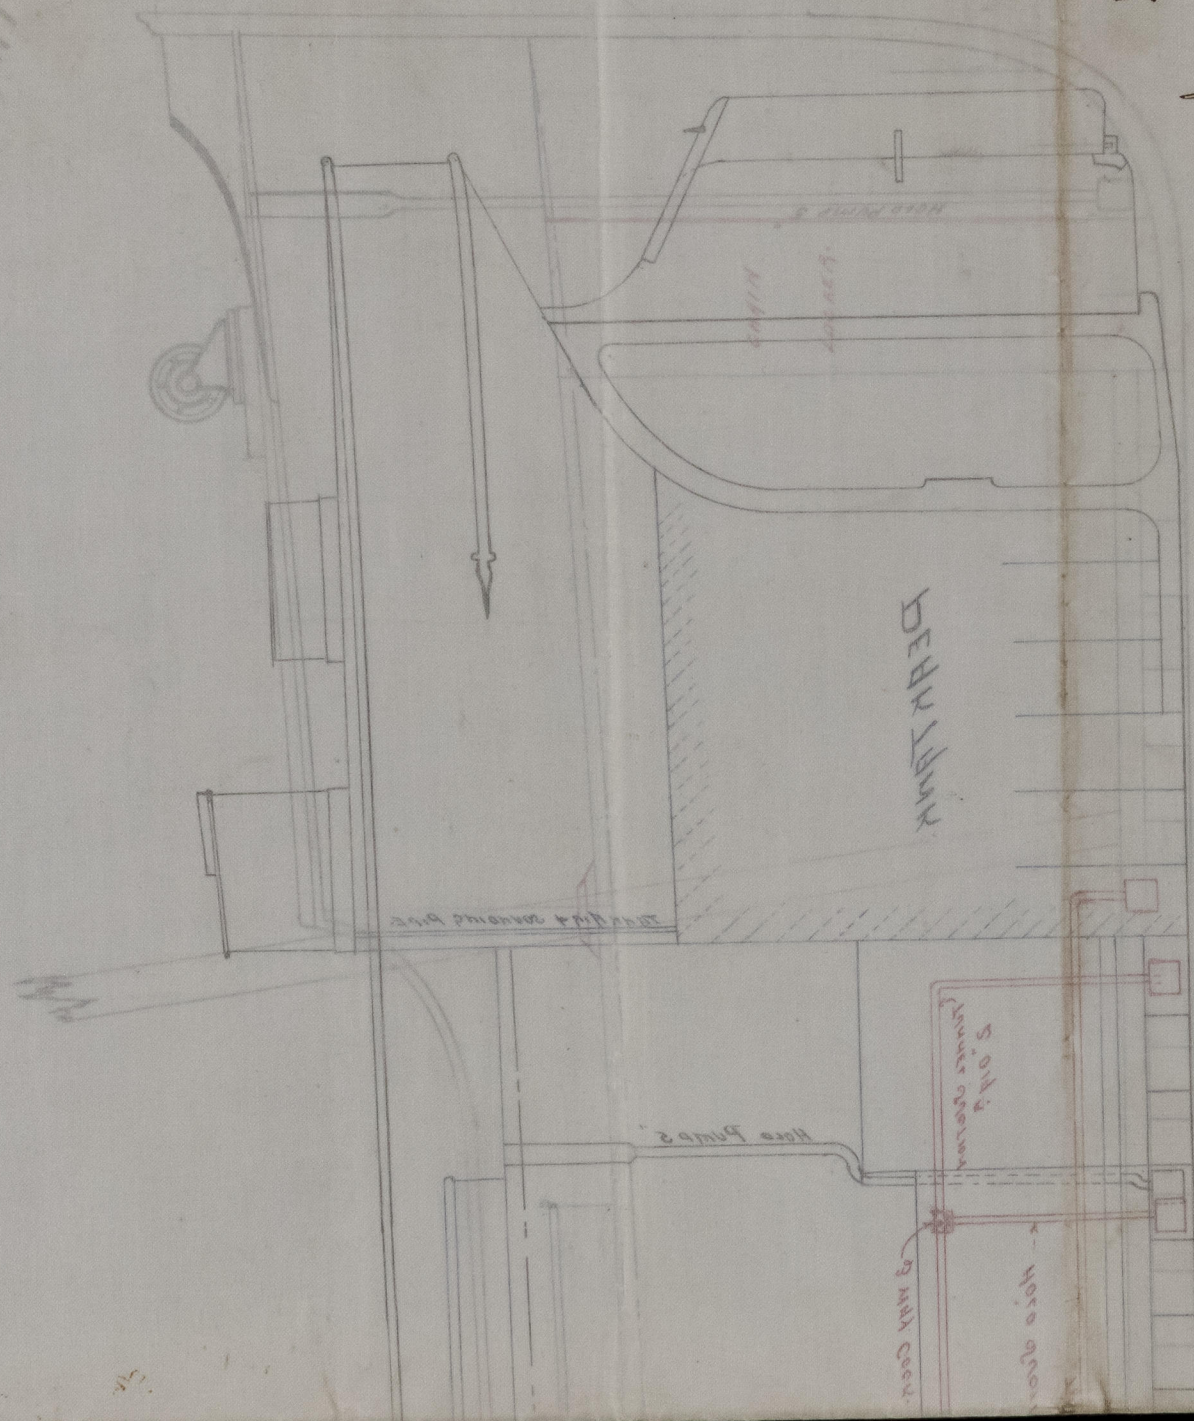





NW 824-0039




© 2021

Lloyd's Register
Foundation