

N^{os} 312 & 3.

30. 11. 91
16. 6. 92


Midship Section of a Steel Screw Steamer
To Class 100 H. 1 Aurning deck Rule.

359'9" x 48'-0" x 36'9" to Avonrig deck

Scale $\frac{1}{2}$ inch = 1 Foot.

26/11/91

Alternative Method of Framing in lieu of Wet Frames. (Not adopted.)

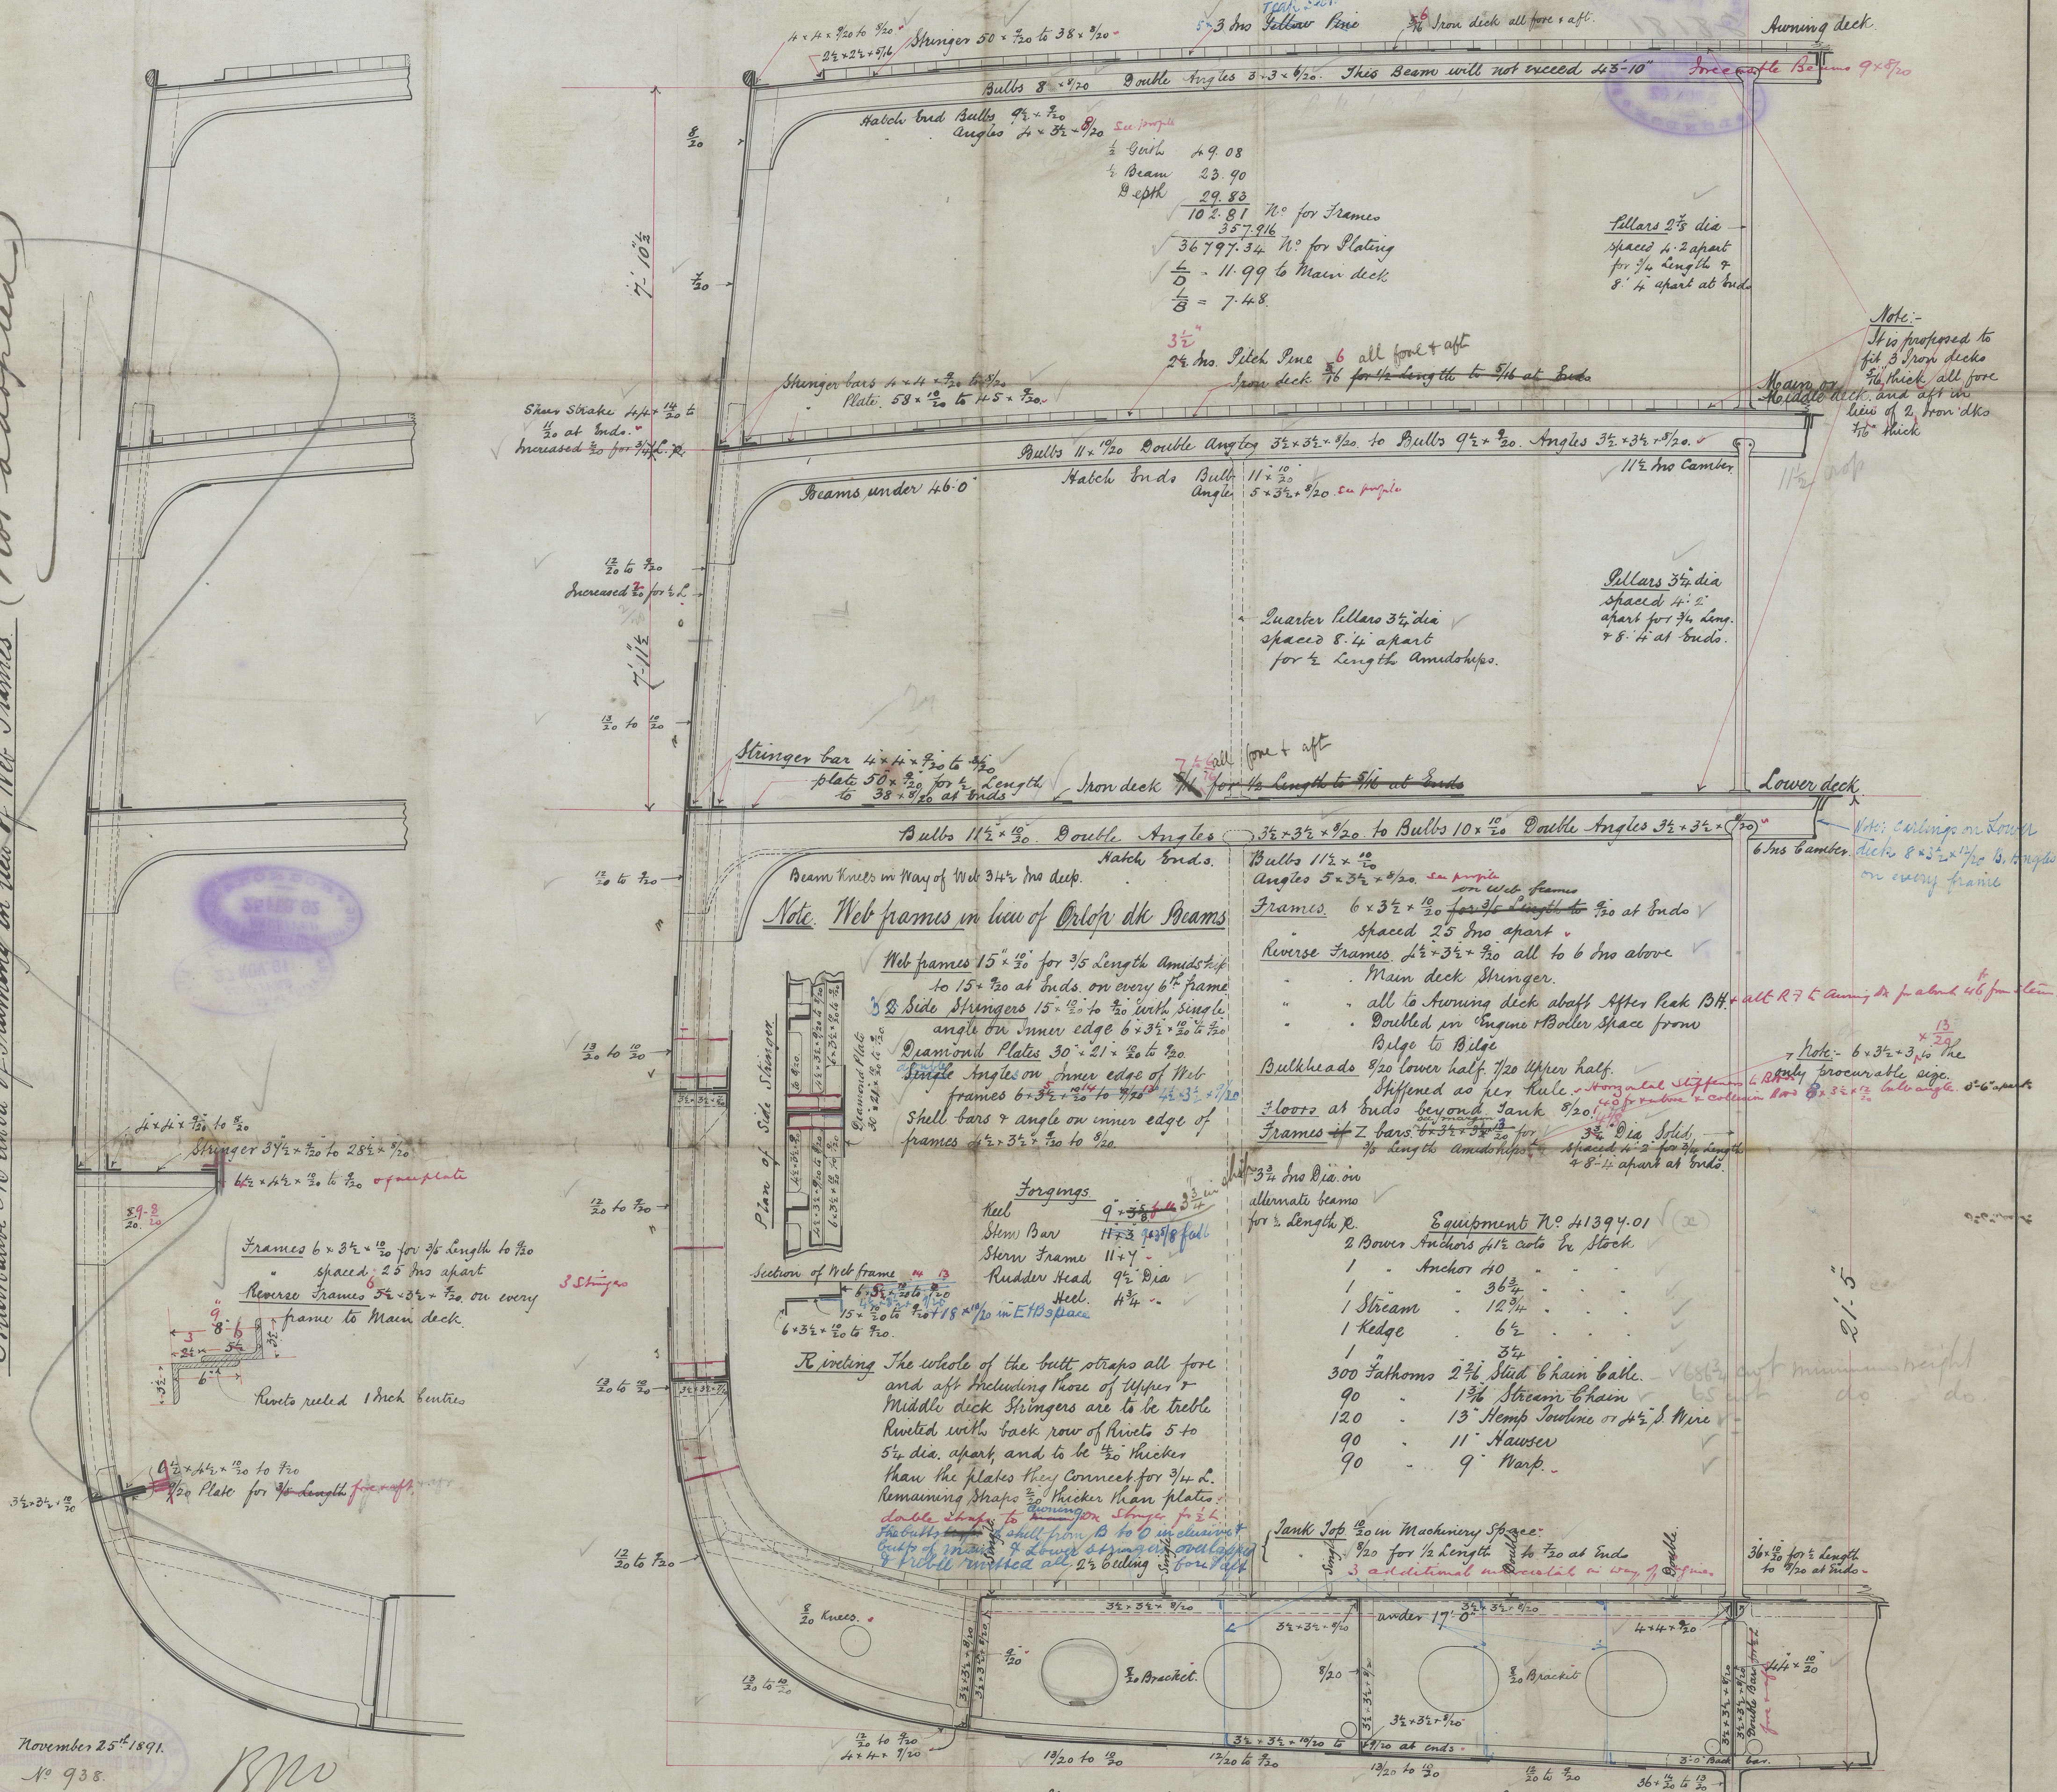

November 25th 1891.
No 938.

B. M. V.
30/11/91

Note:- Shell plating wholly in way of Double Bottom except Garb'd Strake reduced $\frac{1}{20}$ where $\frac{1}{20}$ and above.

10/11/21

*S/S. Port Melbourne
Hawthorn, Leslie & Co
No 312.*

Rive Ref. 27975

*S/S Port Hunter
Ch. Leb. 312*

*No 312
No 28181*



© 2021

Lloyd's Register
Foundation

1613

1613



27 NOV 91

