

Lloyd's Register of British and Foreign Shipping.

(Report on Vessel No. 28181 Port Newcastle)No. 1390 SHIP FORGINGS OR CASTINGS.

The words FORGINGS or CASTINGS, IRON or STEEL, should be struck out as may be required.

I have to report that the undermentioned Iron ~~or Steel~~ Forgings ~~or Castings~~, manufactuerd by Messrs. Hawthorn Leslie & Co of Hebburn for the Vessel No. 313, being built by Messrs. Hawthorn Leslie & Co of Hebburn have been inspected by me as set forth below, and found to be, so far as can be seen, sound


Mark on Forgings.

Lloyd's
No. 387B
JB

John C Craig
Newcastle
30/12/92

	STERN FRAME.	RUDDER FRAME.	STEM.
Material* - - -	<u>Scrap Iron</u>	<u>Scrap Iron</u>	<u>Scrap Iron</u>
How made - - -	<u>Forged</u>	<u>Forged</u>	<u>Forged</u>
Dimensions - - -	<u>11-7</u>	<u>9 1/2-4 3/4</u>	<u>11-3</u>
Progress on Inspection -	<u>Forged & Smithed</u>	<u>Forged & Smithed</u>	<u>Smithed</u>
Dates when Inspected	<u>Dec 11-14/91 Jan 26 Feb 29 July 22 Aug 15-22 Sept 2-14</u> <u>April 1-26-28/92 14 Oct 11-27/92</u>		<u>March 26/92</u>

SKETCHES OF FRAMES SHEWING POSITION AND DESCRIPTION OF WELDS OF FORGINGS, OR PARTICULARS OF TESTS APPLIED TO CASTINGS.

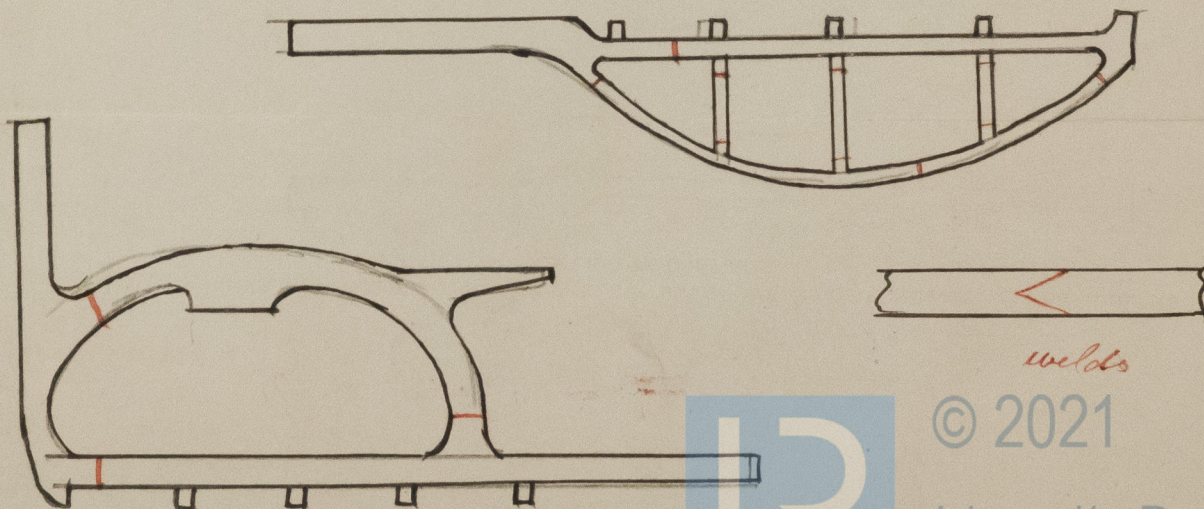

H. Leslie & Co
313



© 2021

Lloyd's Register
Foundation