


PUMPING PLAN No 312-313 S.S.
SCALE 1/8" INCH

28/7/92.

Mr
26.2.92
24/2/92.

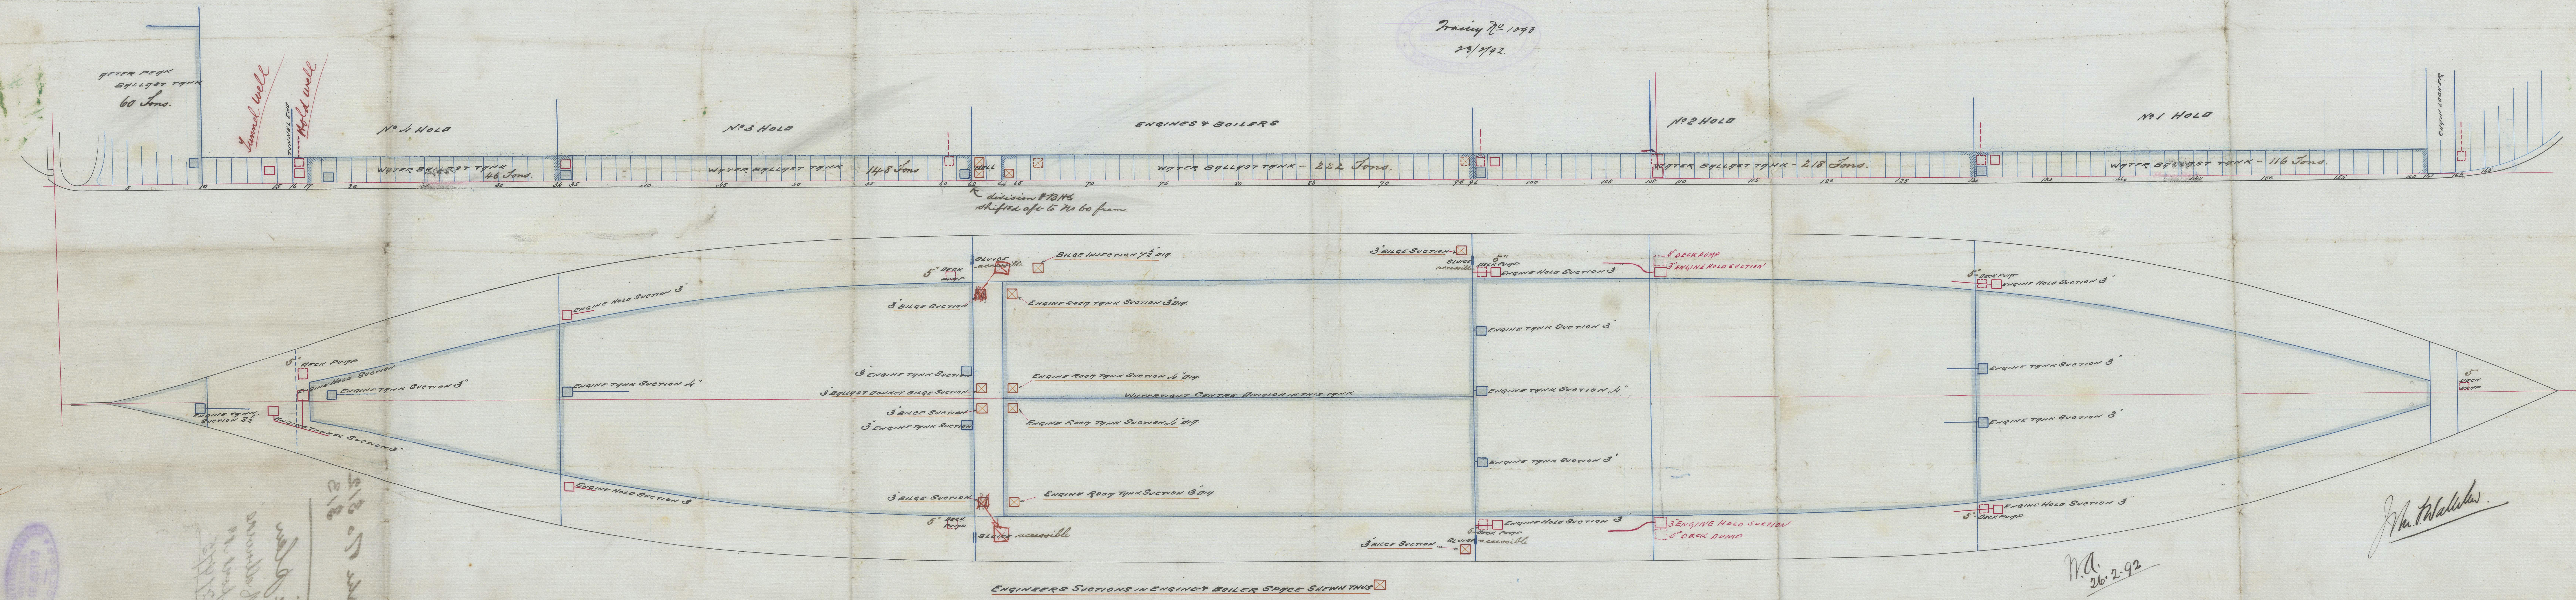


Mr. T. Walshaw
26.2.92

H. Lake No 312
313

Pipe plan
"Port Melbourne"
No Report 19
27/9/5



NWC 828-0167



© 2021

Lloyd's Register
Foundation