


2 STEEL BOILERS

Working pressure 160 lb. test pressure 320 lb. per square inch. "Lloyd's Survey"
All material of Steel, except tubes & girders &c. All holes drilled in place where practicable

SCALE 1" = 1 FOOT

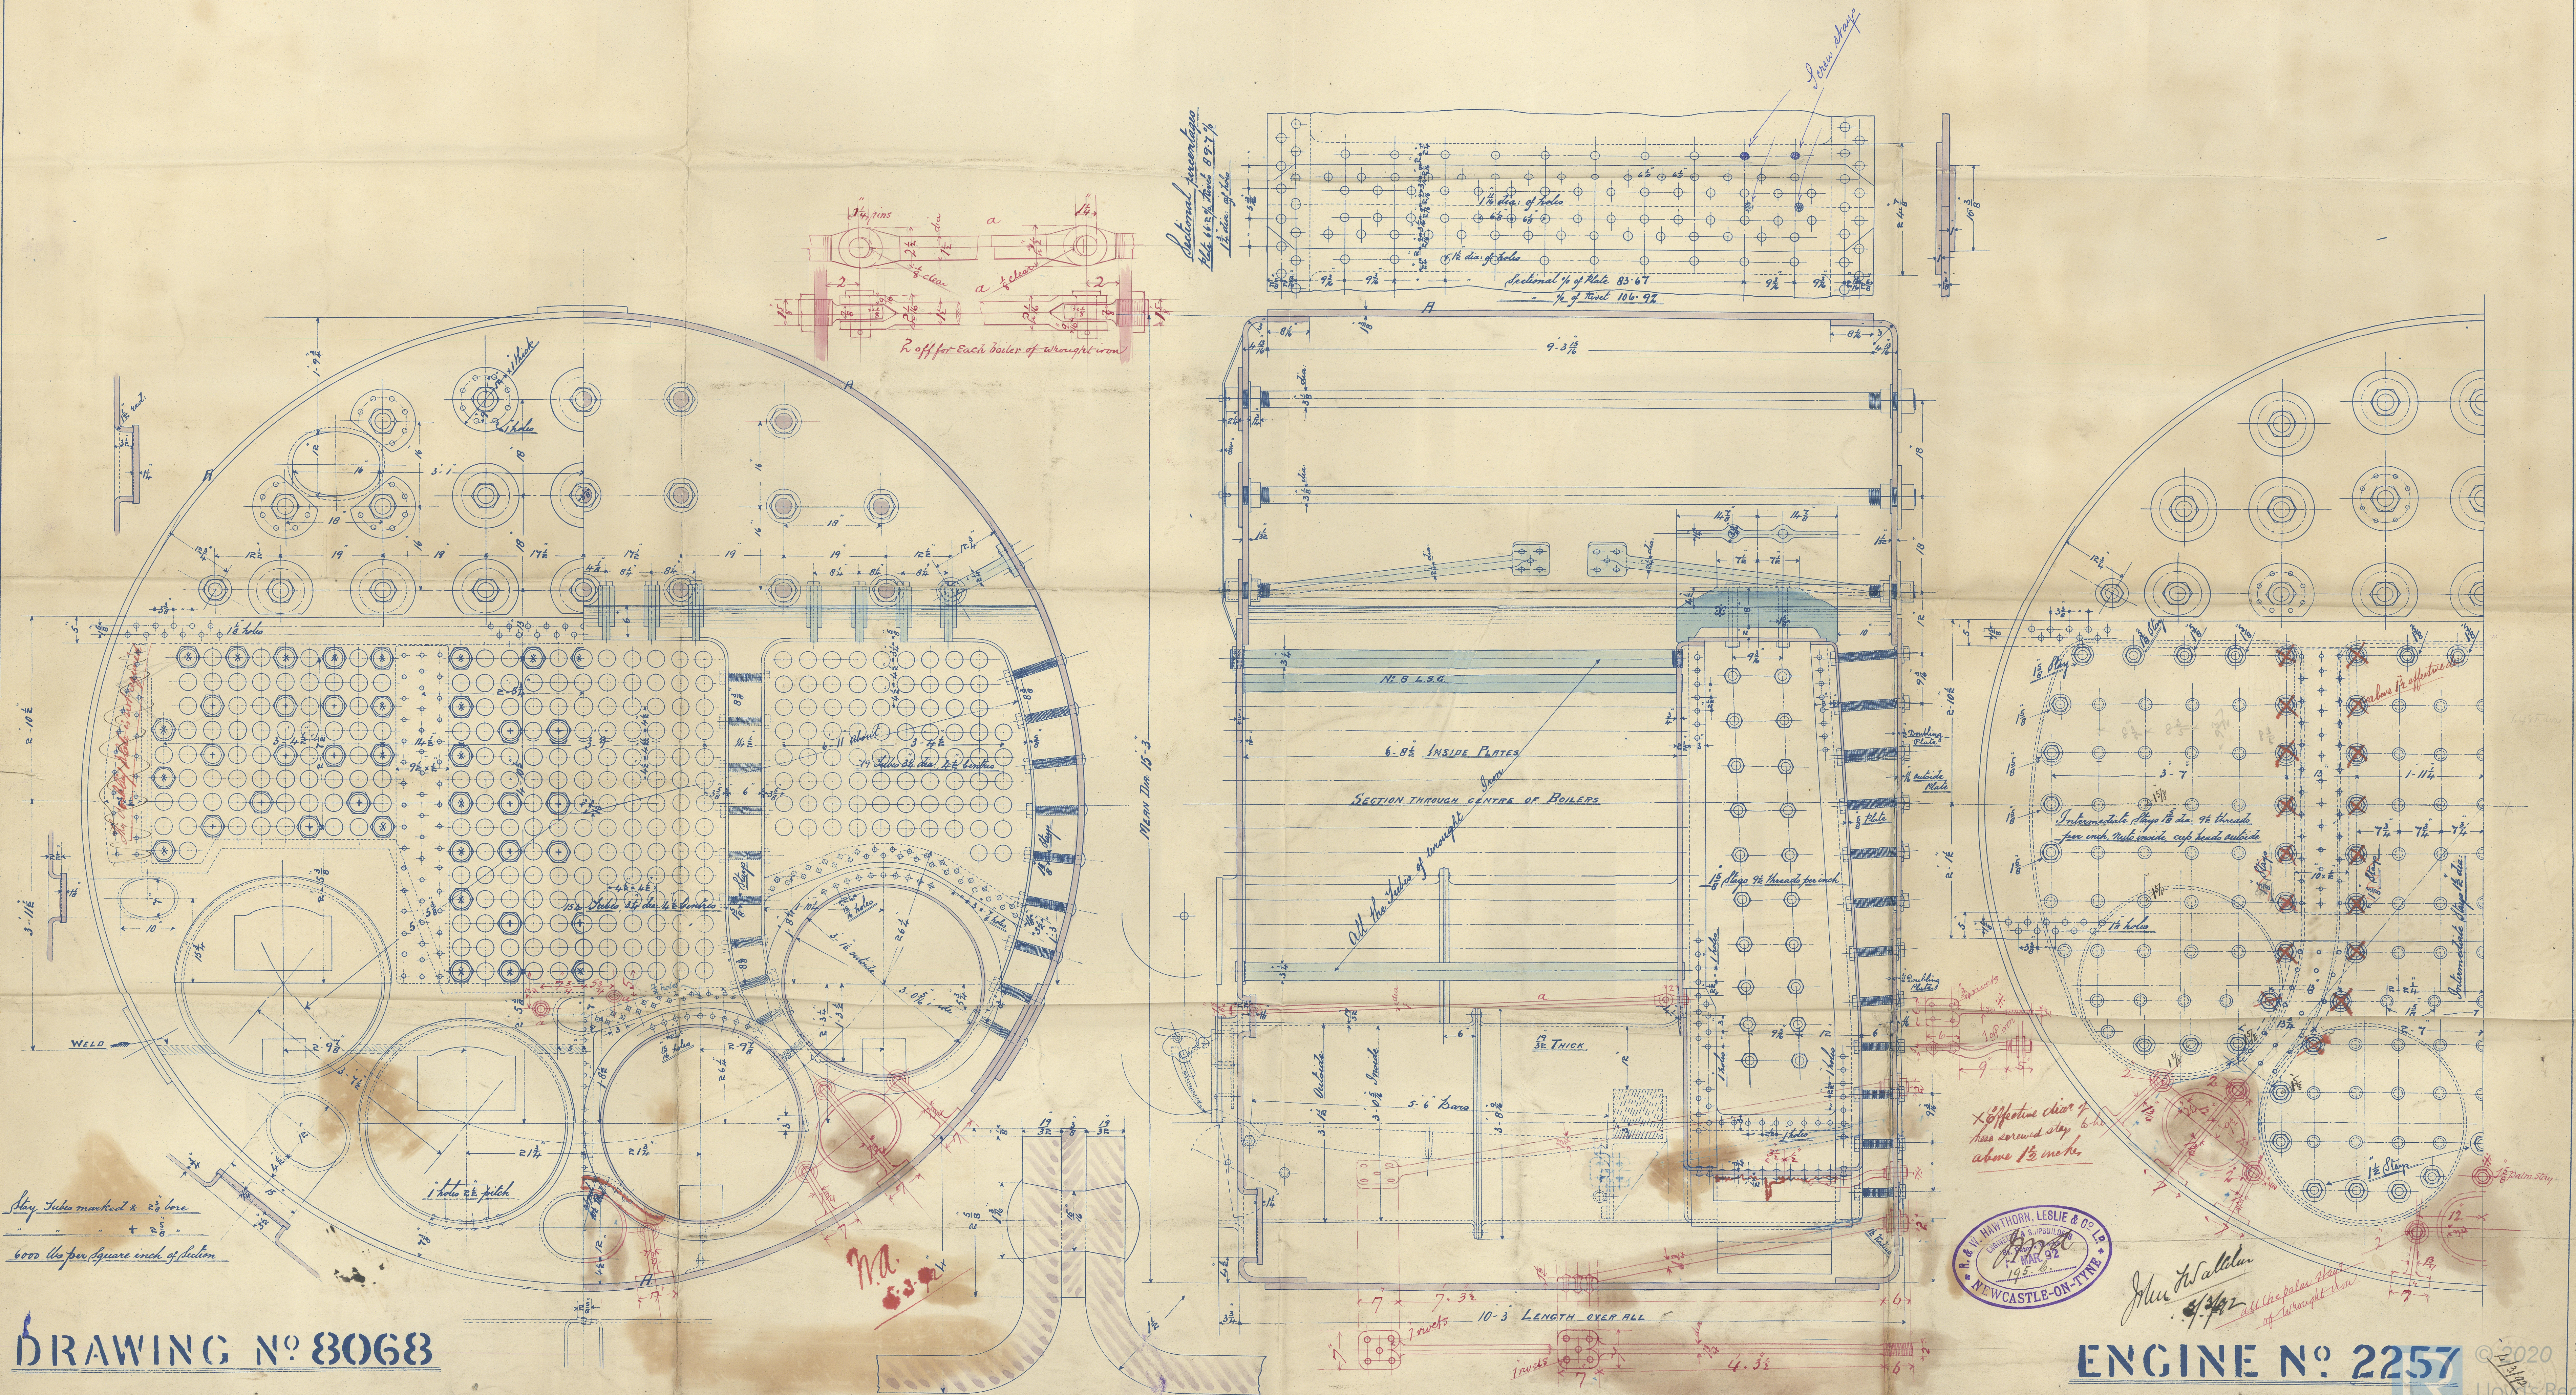

DRAWING N° 8068

ENGINE N° 2257

2020
11/21/22
Lloyd's Register
Foundation

H. L. No 314

2257

Great Northern
New Report W 28091

No 3991

Days Est

3206

J F M

22-10-92



© 2020

Lloyd's Register
Foundation