

Dec. 25: 5: 92

Steel Multitubular Boiler.

10'-6" Dia x 10'-0" long.

Hawthorn Leslie & Co 314 5/8



Boiler No 1541

160 lbs per sq. inch working pressure.

Scale 1" = 1 foot


1" Dia holes 3 1/2" pitch

Double Butt Strap joints, Drilled holes 1" Dia
Inside Butt Straps 11/16 outside 9/8
Steel Rivets and Steel Plates

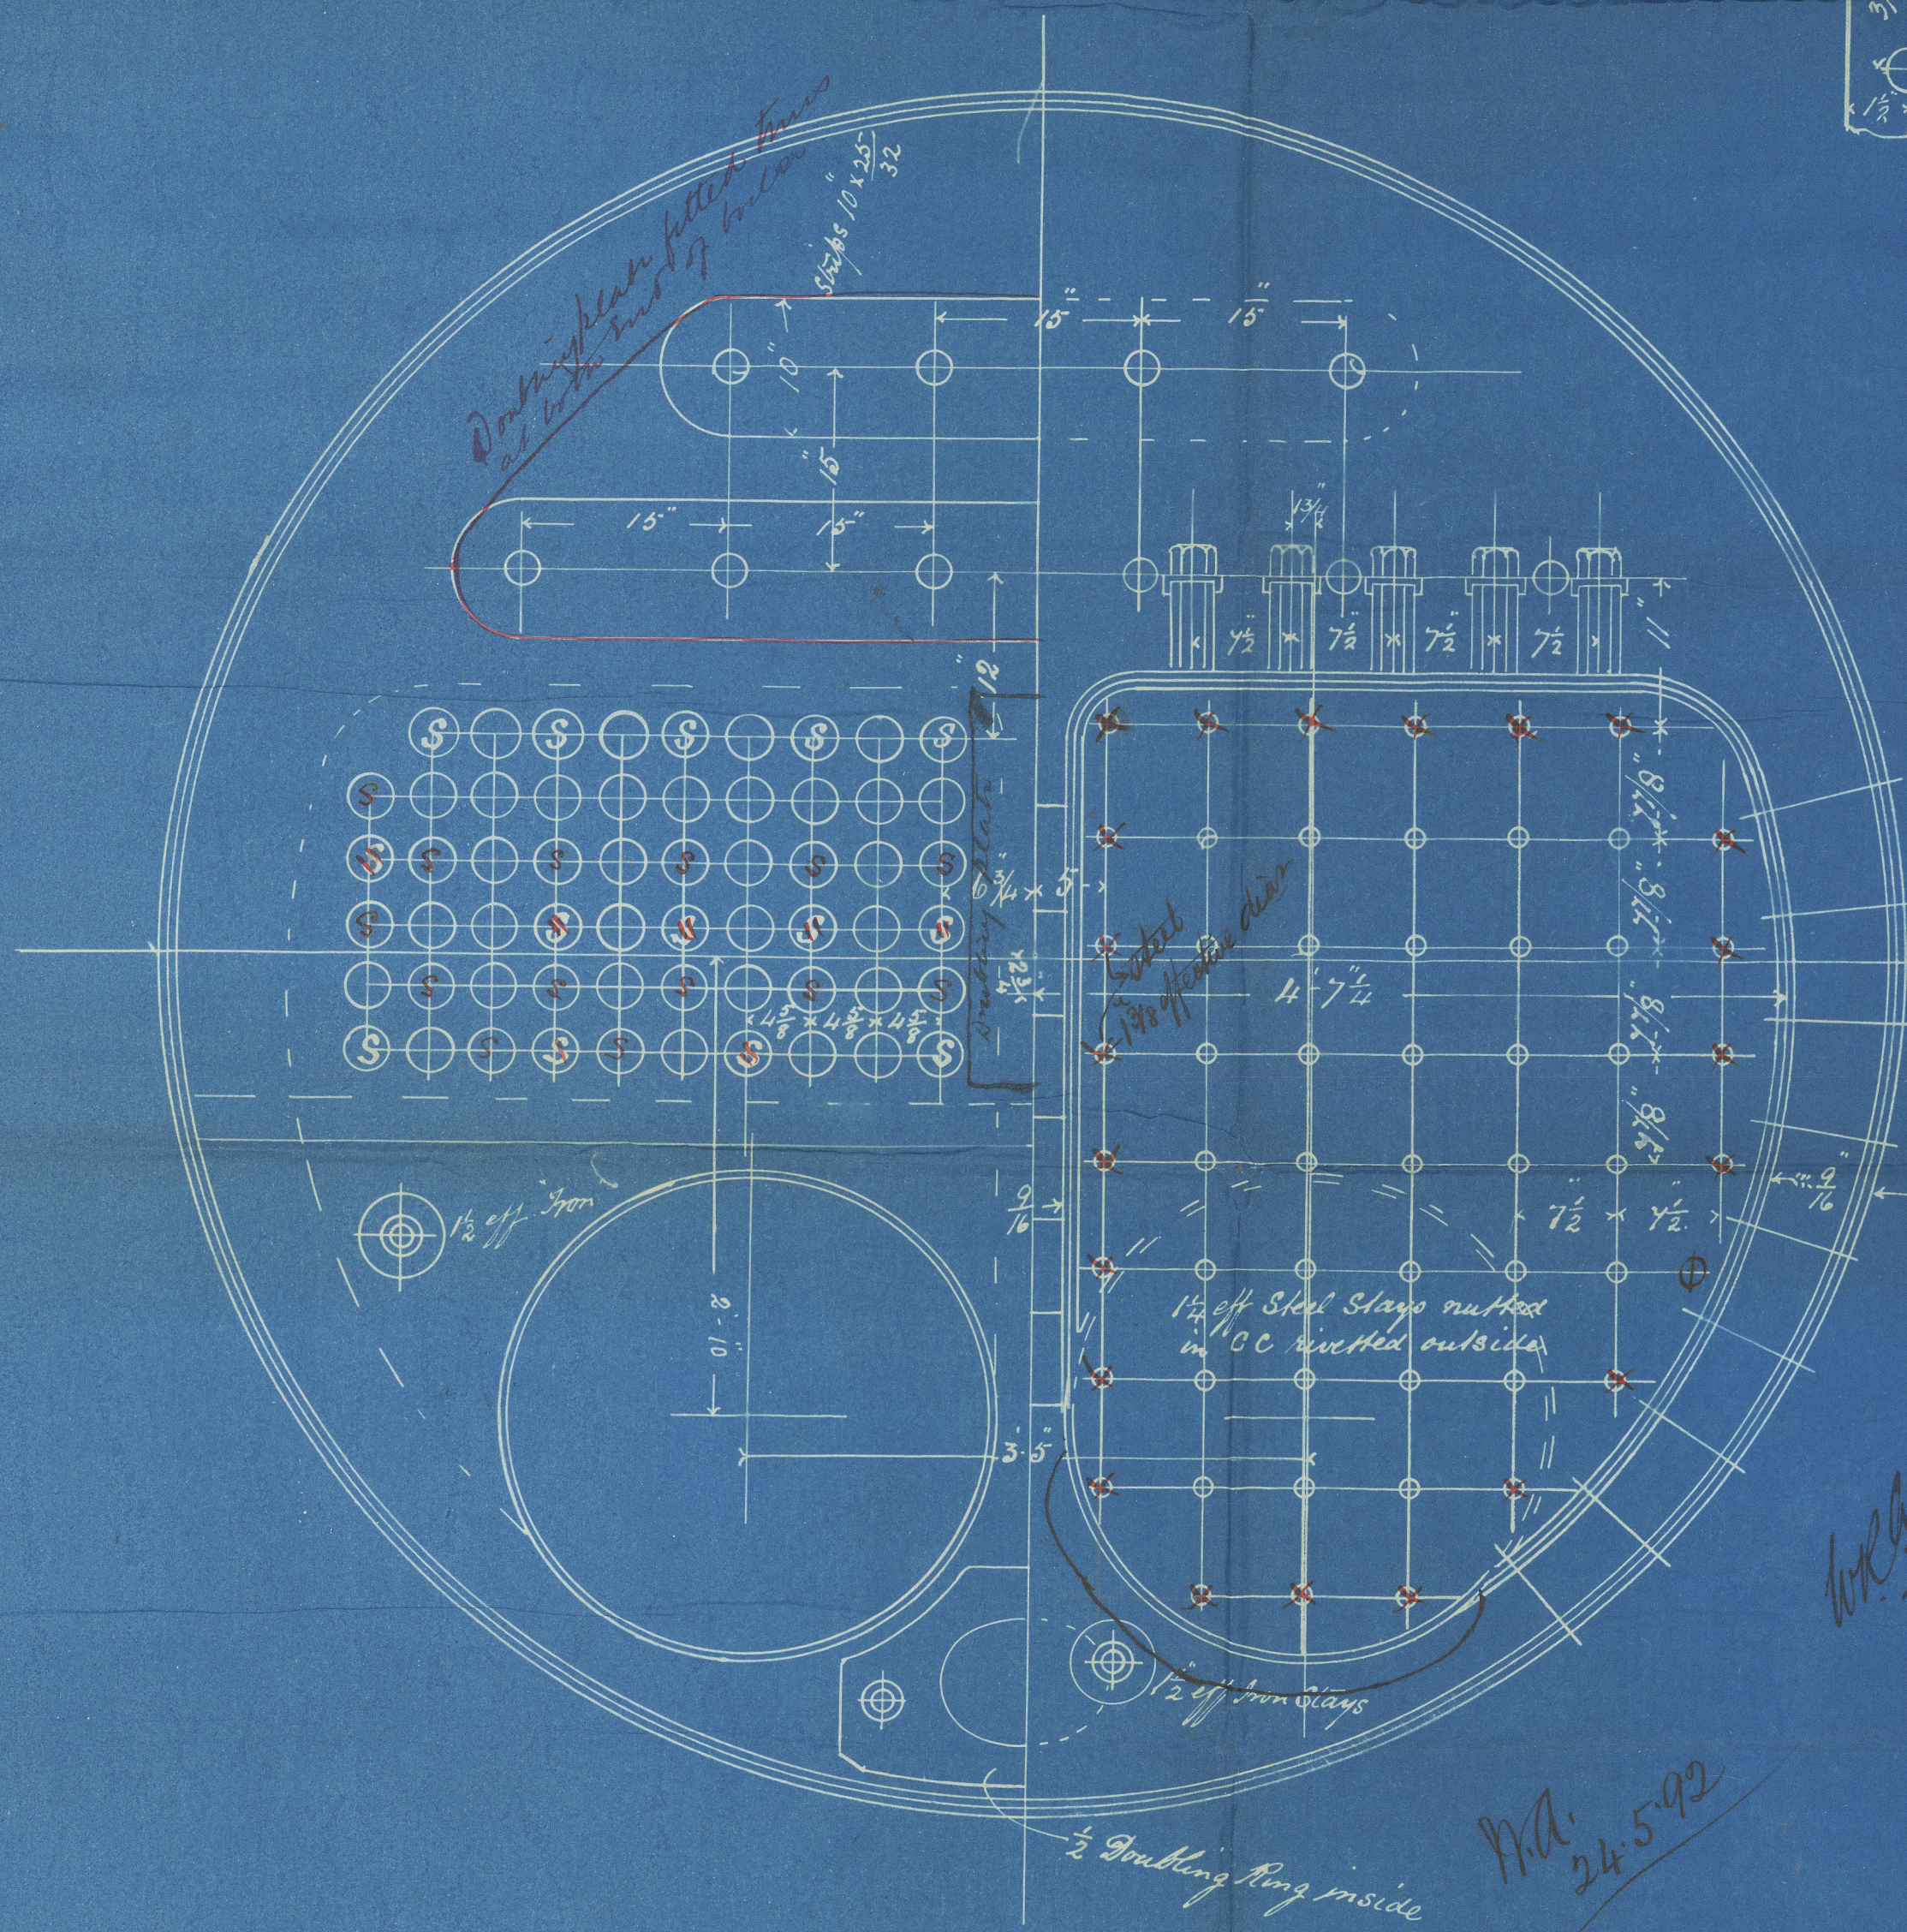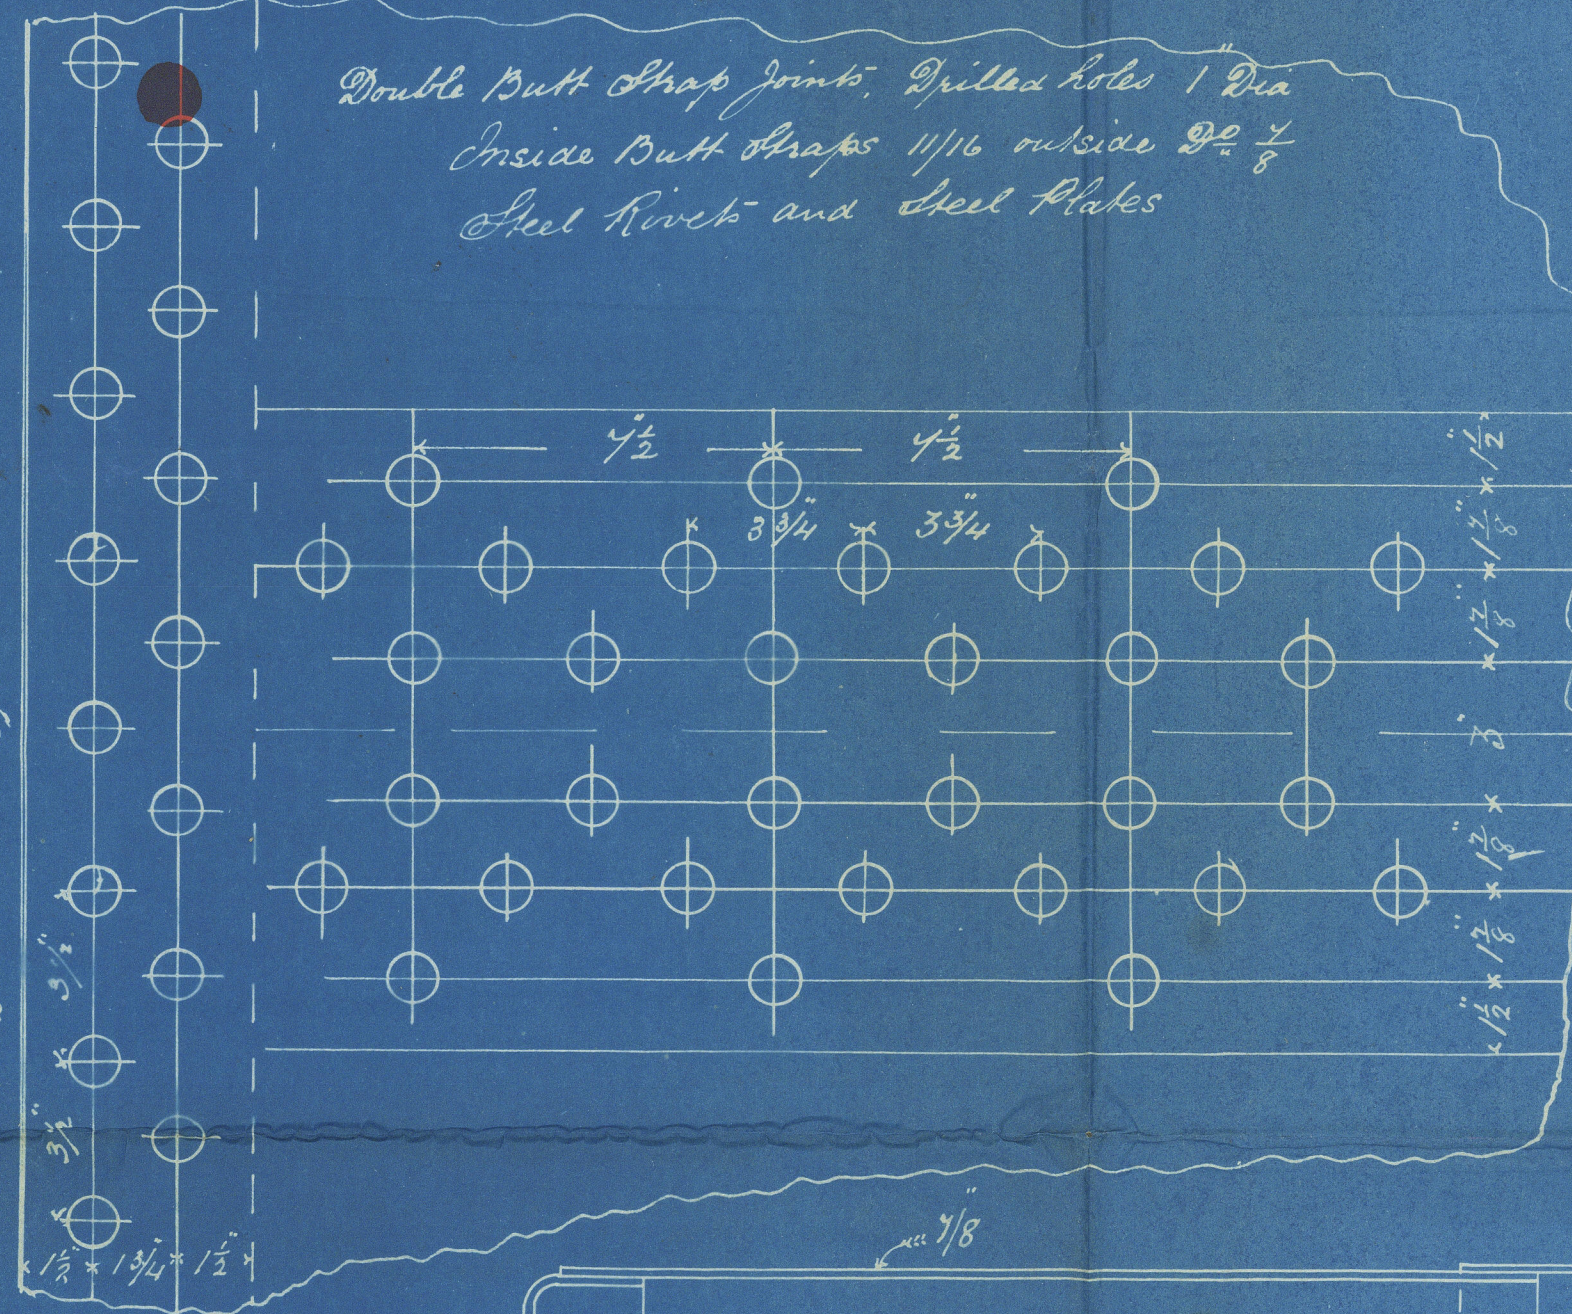

W.R.A.
25th May 1892.

W.R.A.
24.5.92

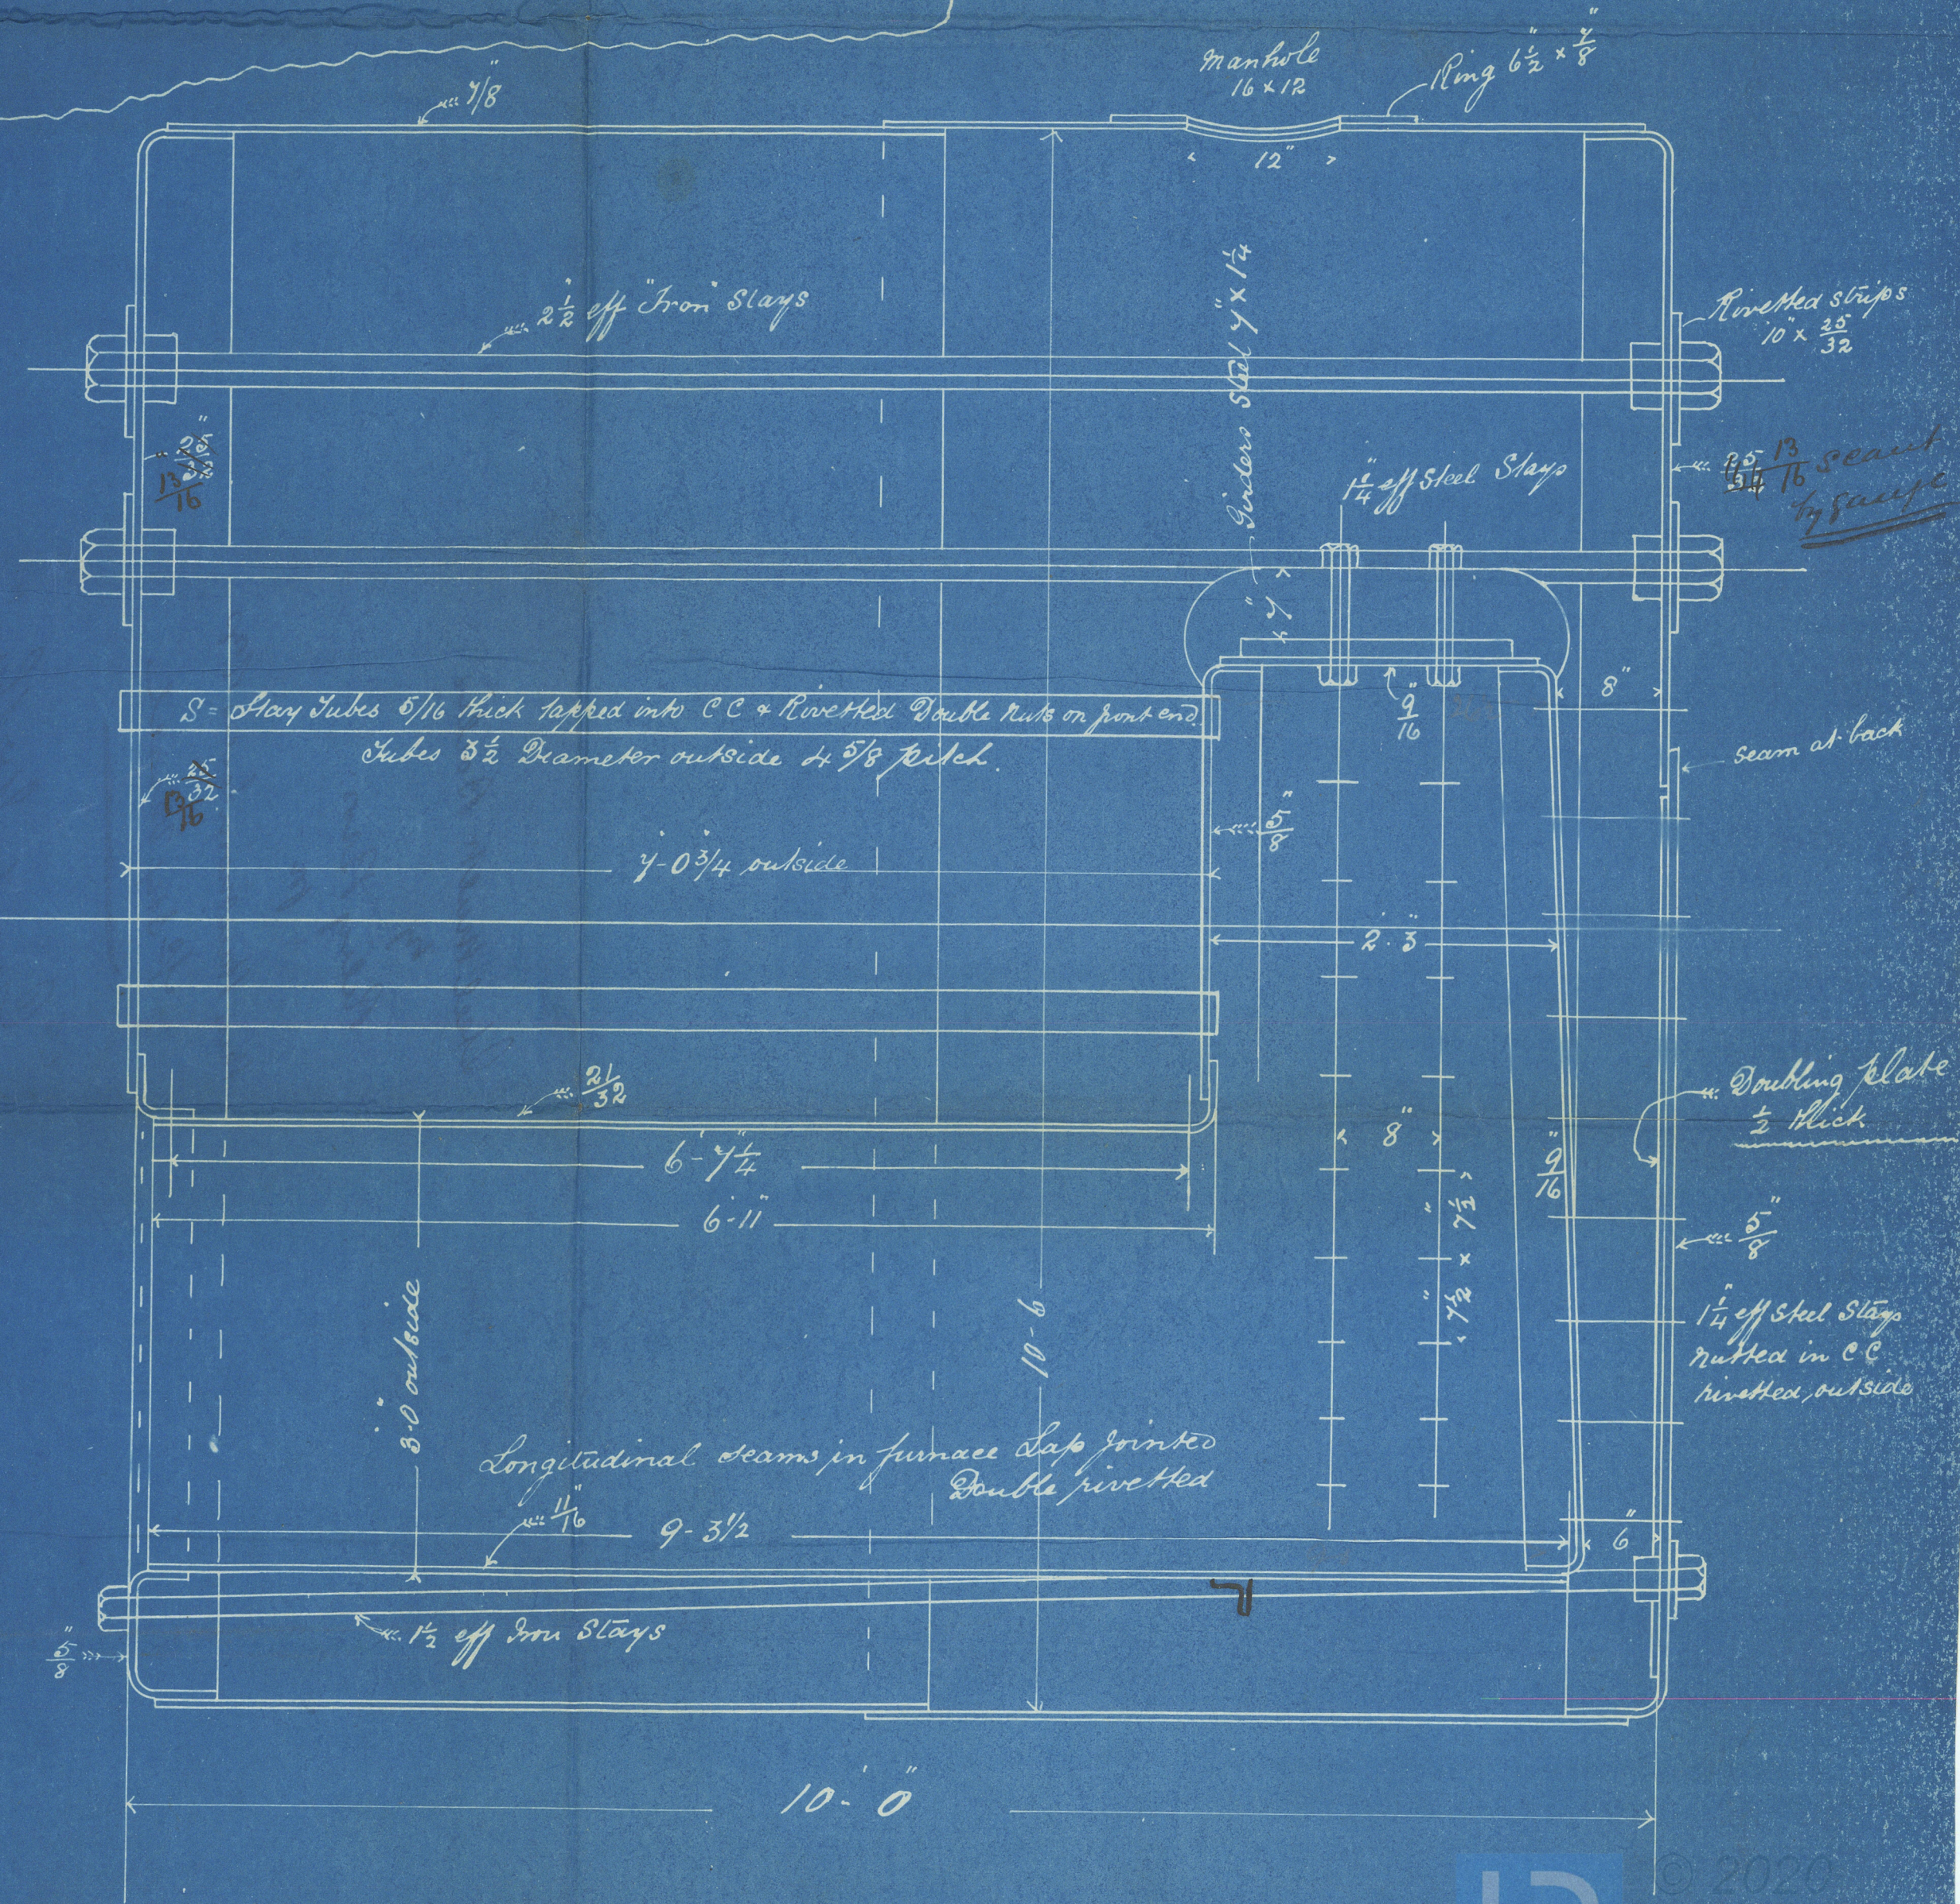

Steel Mult. Boiler

by

Riley Bros.

for

Wm. Hammond & Sons

No 314 Vessel

"Great Northern"

NWCF report No 28091



© 2020

Lloyd's Register
Foundation

NWC829-0128