


Ln. 28/4/92


PLAN OF SUCTION PIPES NO 314 SHIP

SCALE 1/8" = 1 FOOT 2257

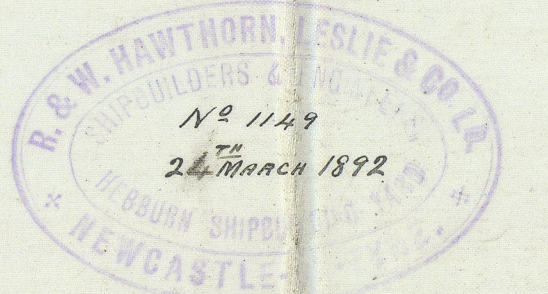

NOTE FROM OUR SPECIFICATION

TANK UNDER ENGINE ROOM TO BE ARRANGED SO THAT IT MAY BE USED AS A FRESH WATER TANK FOR BOILERS. DONKEY PUMP CONNECTED TO THIS TANK TO FEED DONKEY BOILER.

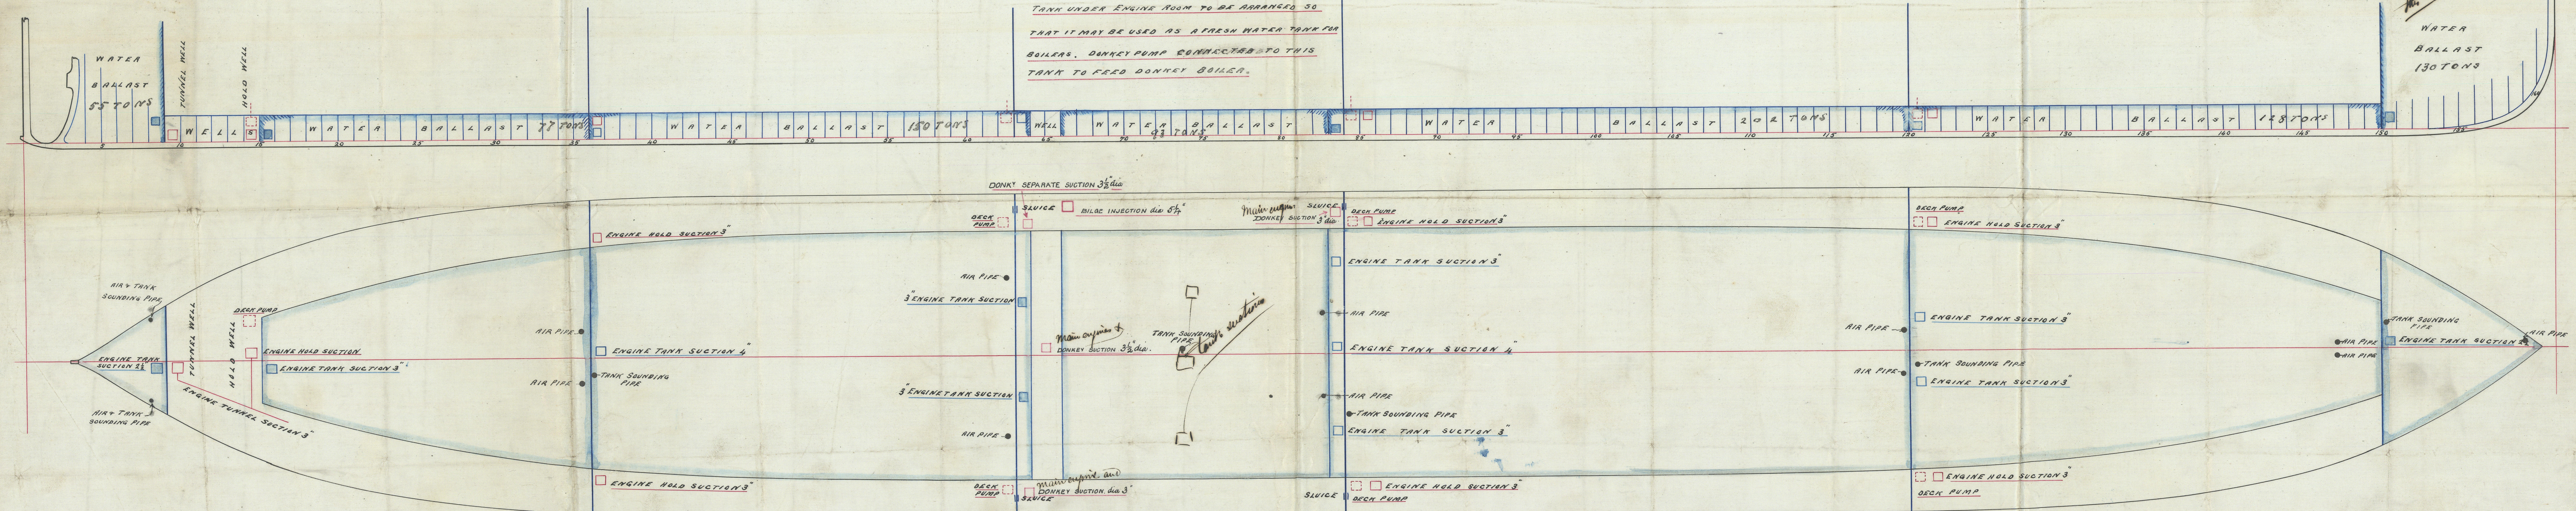


Hand pump on top of the tank

N.A. 19.4.92

M.L.G. 16/4/92


Great Northern
Nack Report No.
28091

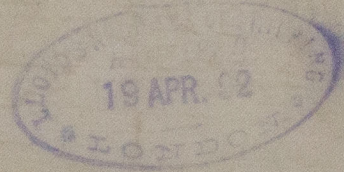

13/11/32

Wb 2

NWC829-0136

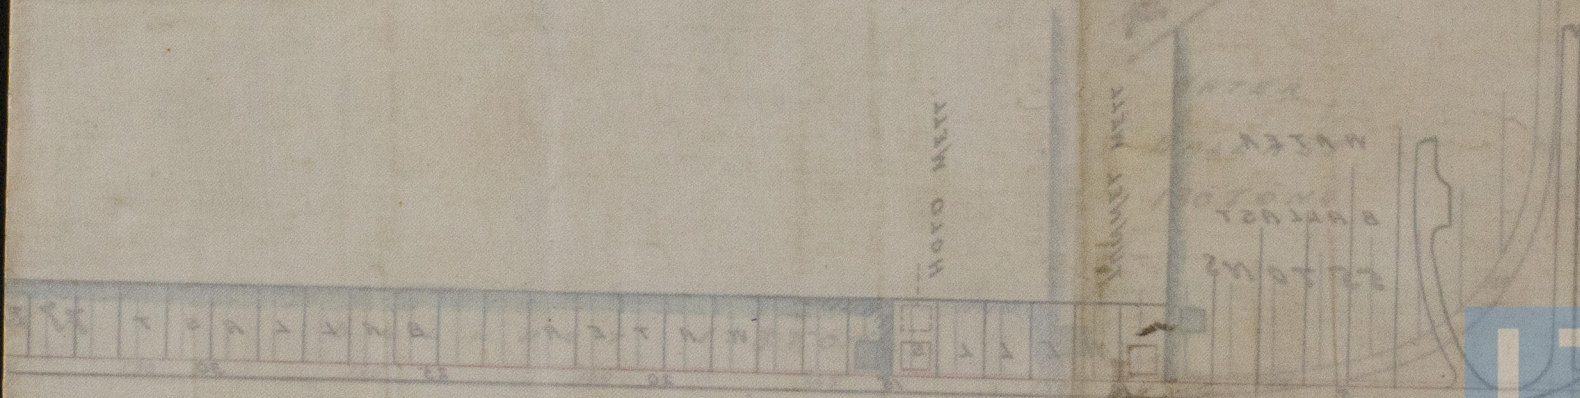

© 2020

Lloyd's Register
Foundation