

1.12.91


Midship Section of a Steel Screw Steamer To Class 100 A.I. Raised Quarter Deck

322 x 41' 6" x 24' 0"
Scale 1/2 inch = 1 Foot.

Nº 314.

11/12/91

1/4 Girth 41.83
1/4 Beam 20.45
Depth 24.83
87.41 Frame N.
320.2
27988.68 Plating N.
5 = 112.9

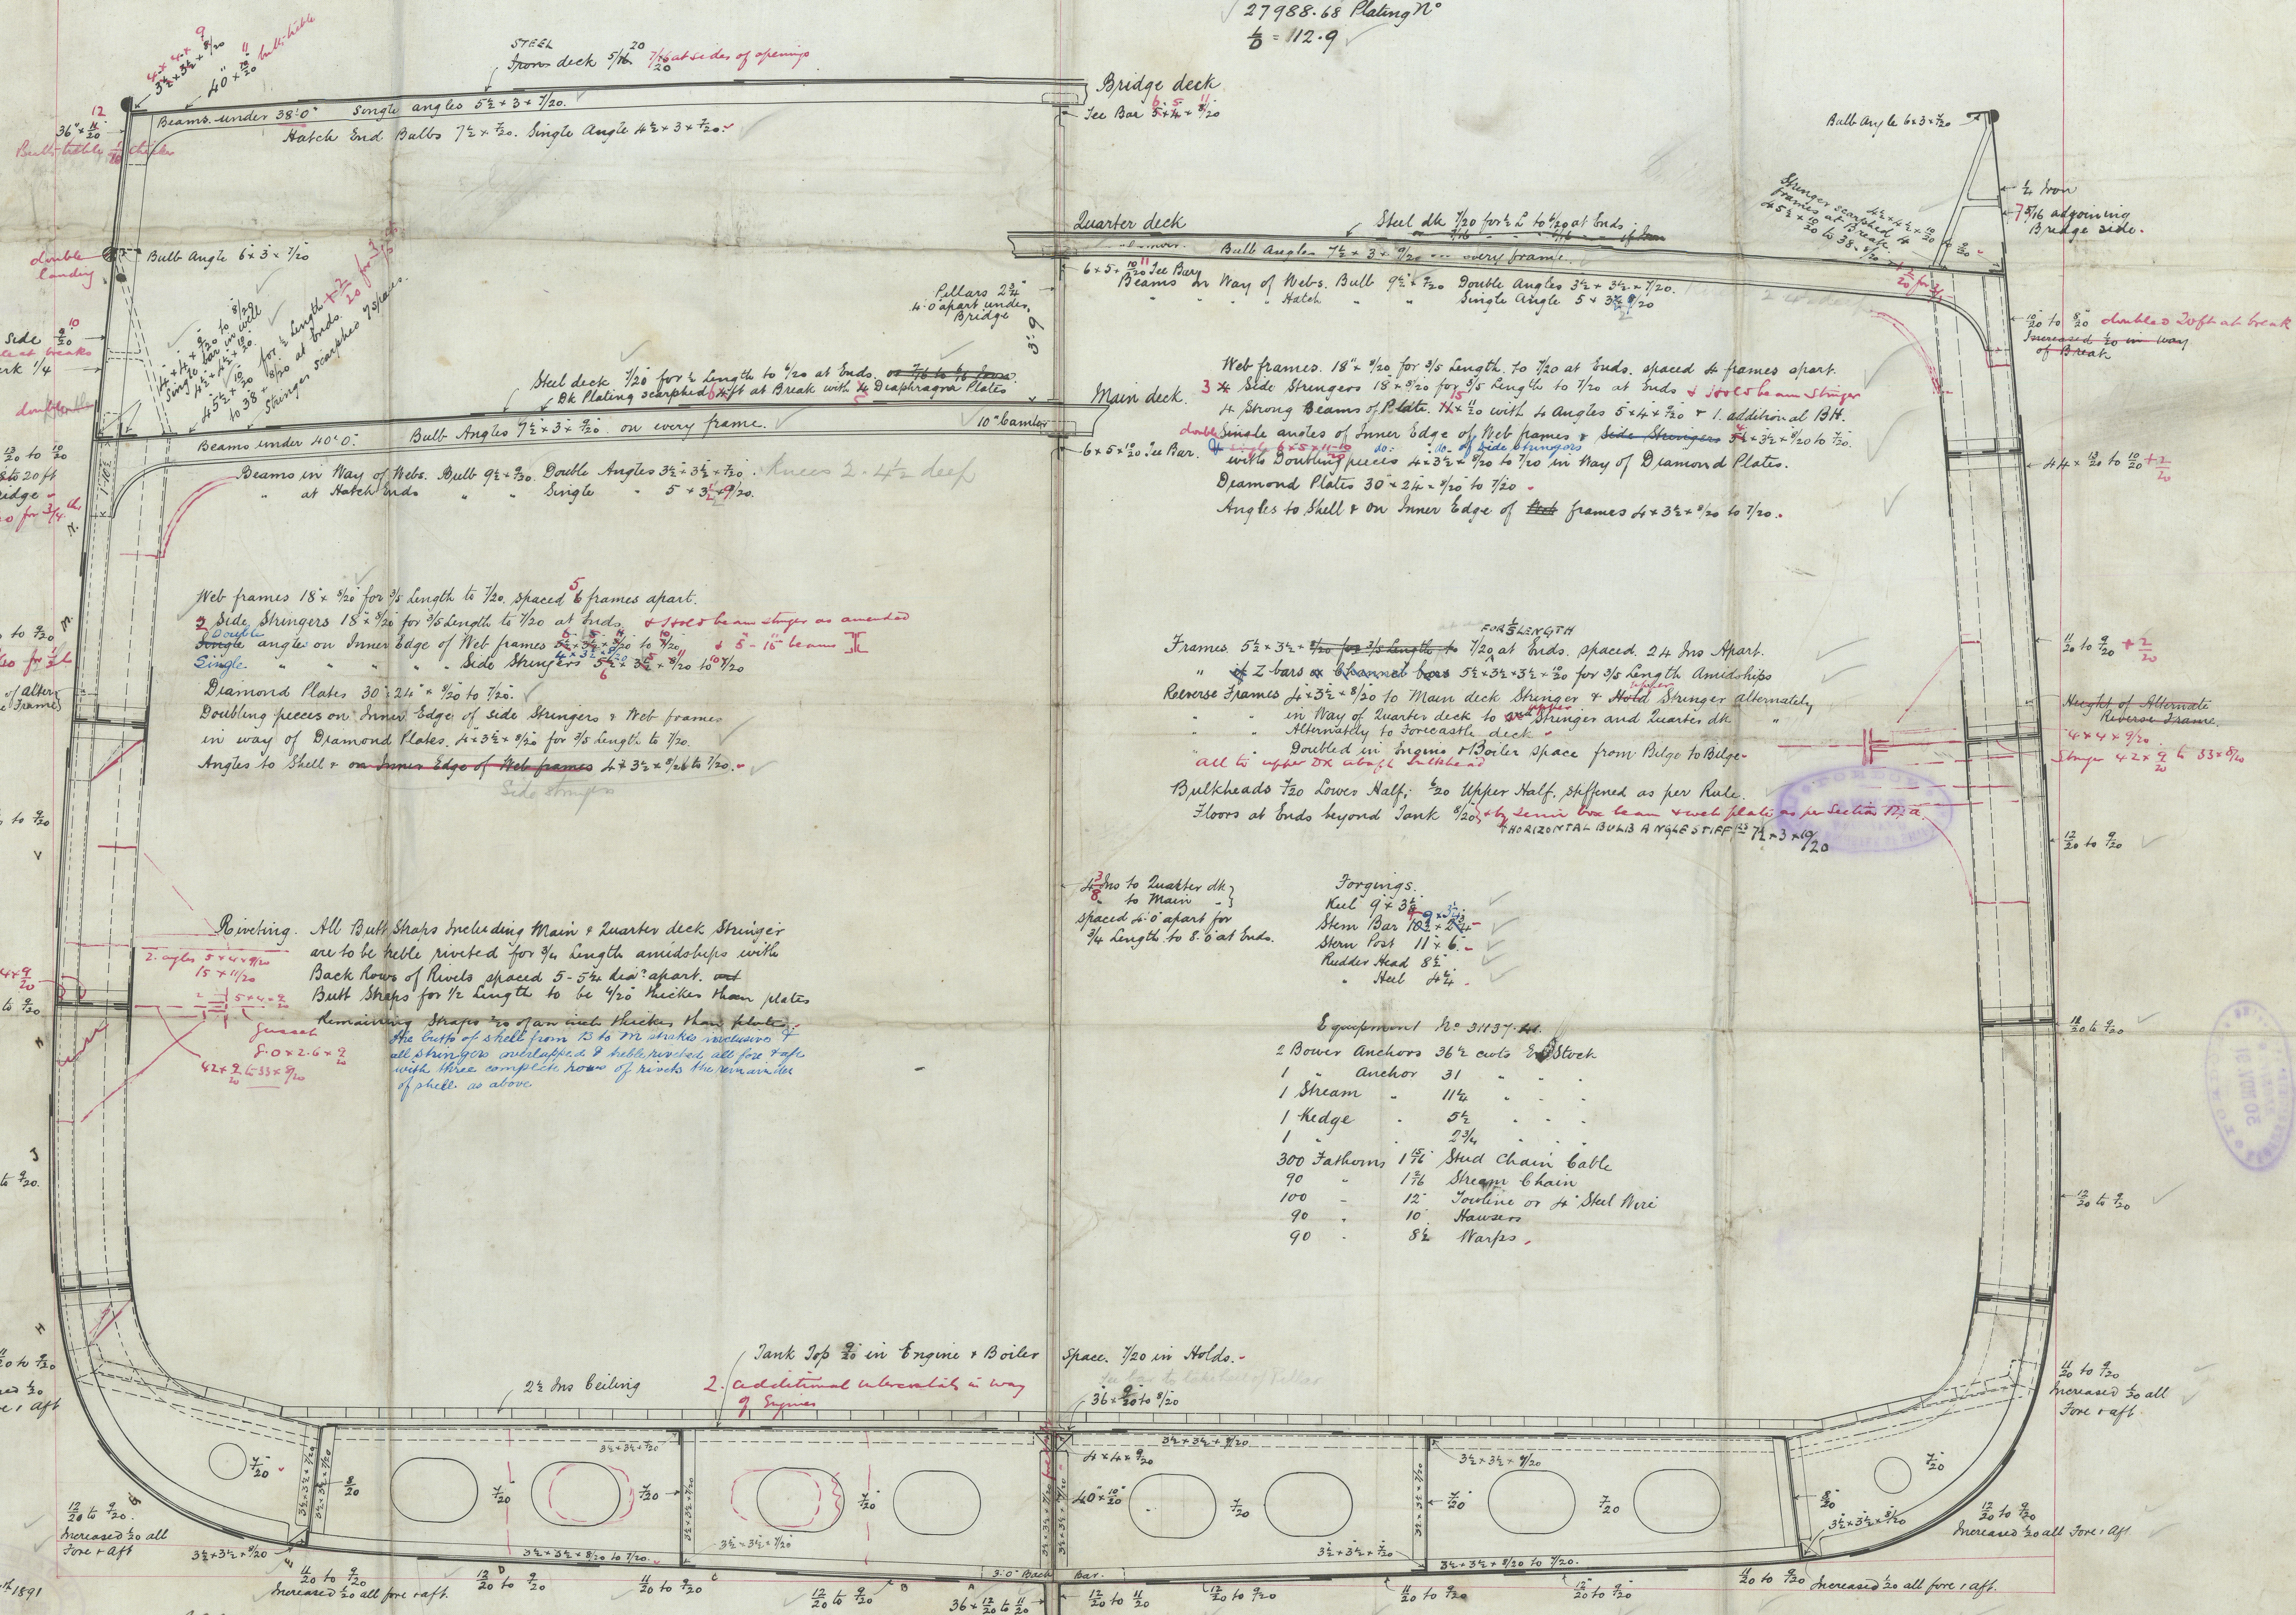

November 27th 1891
Nº 945.

1/12/91

Note. Shell Plating wholly in way of Double Bottom except Garb Strake reduced 1/20 where 1/20 and above.


RECEIVED
30 NOV. 31

 RECEIVED
 18 APR. 92
 LONDON

© 2020
Lloyd's Register
Foundation

NWC829-0137

Hawthorn, Leslie & Co.

No 314

S/S. "Great Northern"

NWC

28091

12.51.1



now named

"Cairacrag"



© 2020

Lloyd's Register
Foundation