


- No 314 S.S. -
Longitudinal Section
322' x 41.6' x 24'-0" m ²²
SCALE 1/8" = 1 FT
NOTE ^{double} SUNKLE ANGLE AT BULL

P.C. BEAMS BOLTS 1/2" x SINGLE ANGLE 3 x 3 x 1/2 ON ALTERNATE FRAMES
BOLT " x DOUBLE " " ON 14, 13 & 152 " UNDER WINDLASS
SINGLE ANGLE 6 x 3 x 1/2 ON ALTERNATE FRAMES
8 x 8" Bolt w/ 1/2" under Thrust on 6 posts

772.
28/1/91.

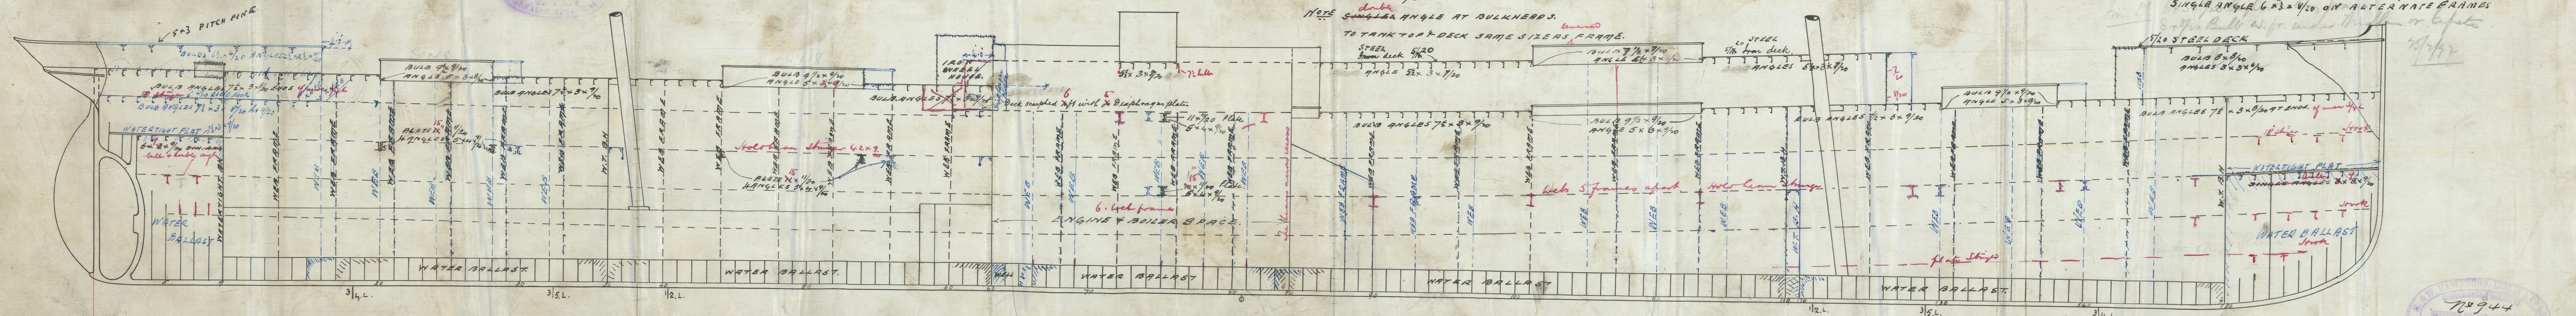

W & A HAWTHORN, LONDON
 No 944
 27/11/91



18. m
1/12/91

1892
 1893
"Great Northern"
Sweet Report No
28091

NW 6829-0138

now named
"Cairncrag"



© 2020

Lloyd's Register
Foundation