

25.7.92  
 2.8.92  
 15.8.92


Class 100 A1 "Aurora Deck"

PROFILE

S.S. No 56


SCALE  $\frac{1}{8}$ " = 1 FOOT

WILLIAM DOBSON & CO  
 IRON SHIPBUILDERS  
 DATE July 18<sup>th</sup> 1892  
 NEWCASTLE-ON-TYNE

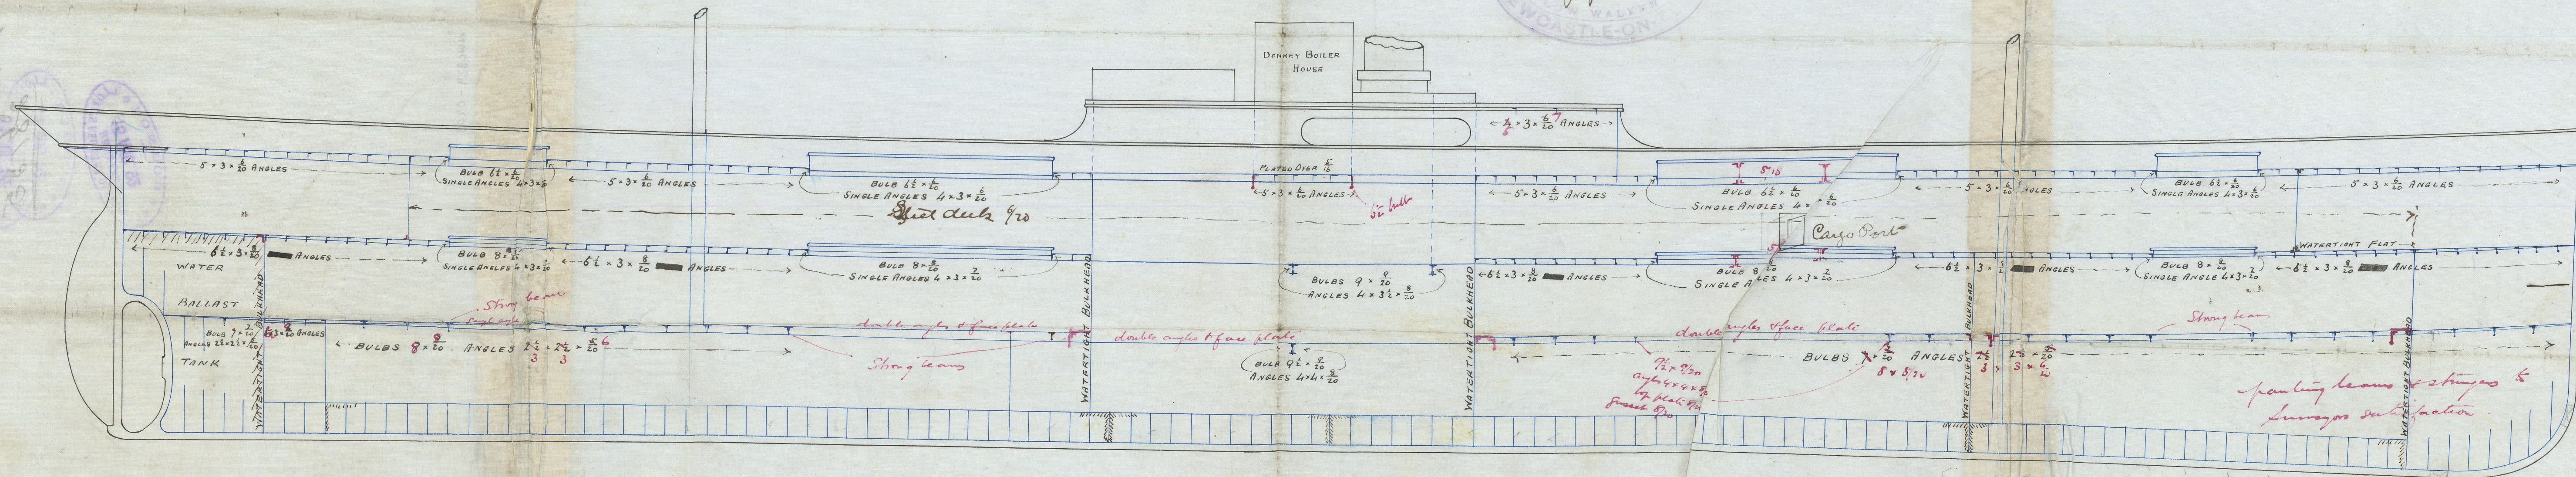

20.7.92

© 2020

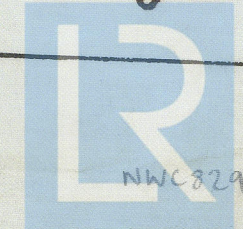

Lloyd's Register Foundation



M<sup>rs</sup> Johnson & Co  
Profile N<sup>o</sup> 56

Running Deck  
Cable Road  
New Report No

28/25



© 2020

Lloyd's Register  
Foundation

NWC829-0203