

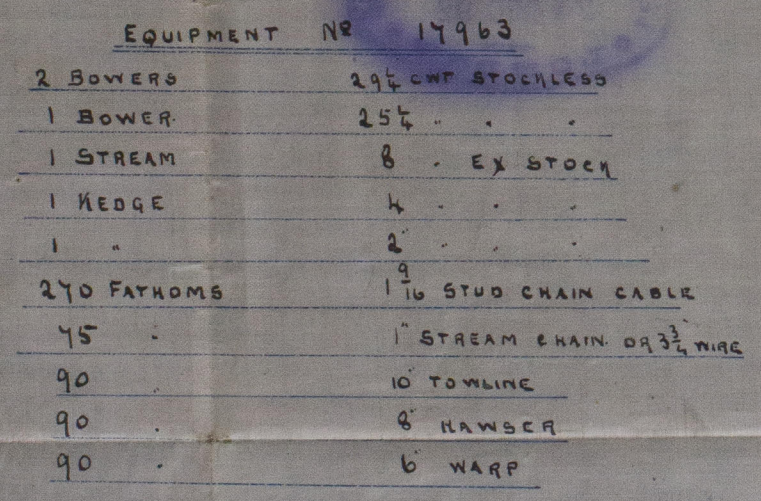
~~Lr. 28.7.92
 2.8.92
 15.8.92~~
 Class 100 A1 Auning Deck.

— N^o 56 SHIP —

WILLIAM DOBSON & CO.
IRON STRENGTHENERS
NEWCASTLE-ON-TYNE
July 18th 1892

BRIDGE BEAMS $A = 3 \times 20$
ON ALTERNATE FRAMES.

$$\frac{L}{D} = 12.8$$

$$\frac{L}{B} = 6.8$$


→ BUTT STRAPS

THE BUTTSTRAPS OF THE SHEER STRAKE
DECK STRINGER PLATE AND 3 STRAKES
ROUND THE BILGE ARE TO BE ²/₂ THICKER
THAN THE PLATES THEY CONNECT FOR
B.L. AND TREBLE RIVETED.

Midship Section
S.S. 'Cabo Roca'
Newcastle Freeboard
Report No. 28070

NWC92A-0206

56
Drawing Deck
S.S. 'Cabo Roca'

Stave Section



© 2020

Lloyd's Register
Foundation