
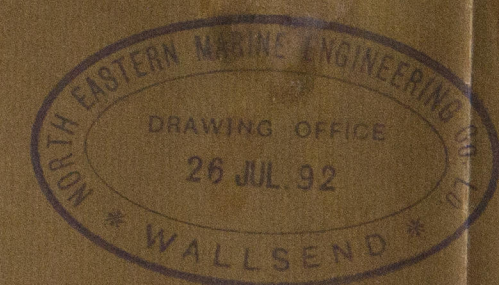


# NORTHUMBERLAND ENGINE WORKS

## STEAM BOILER

TRACING 2197

SCALE 1 INCH = ONE FOOT



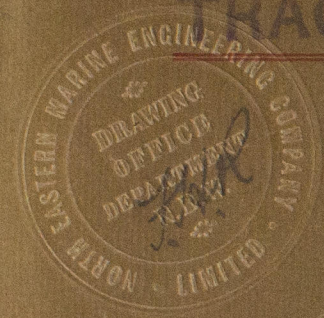


3892

WORKING PRESSURE 160 LBS PER SQ IN

TEST 320

NOTE ALL PLATED, STAYS & TUBES OF STEEL EXCEPT WHERE OTHERWISE SHOWN

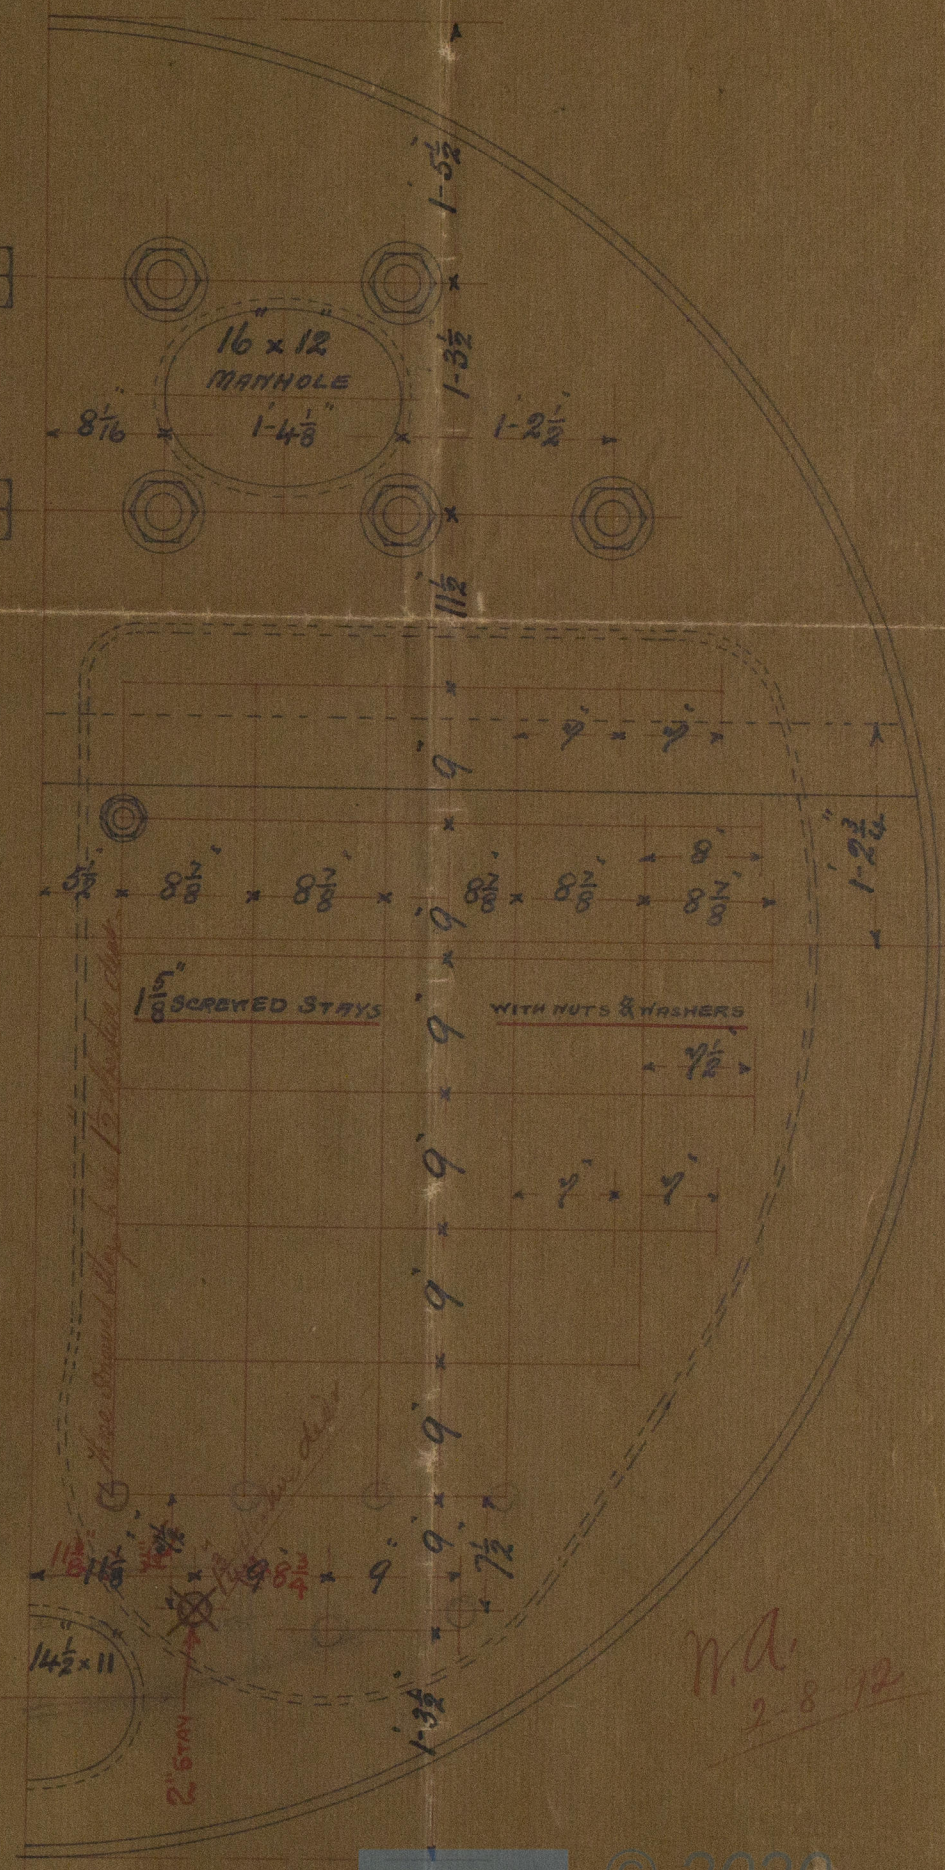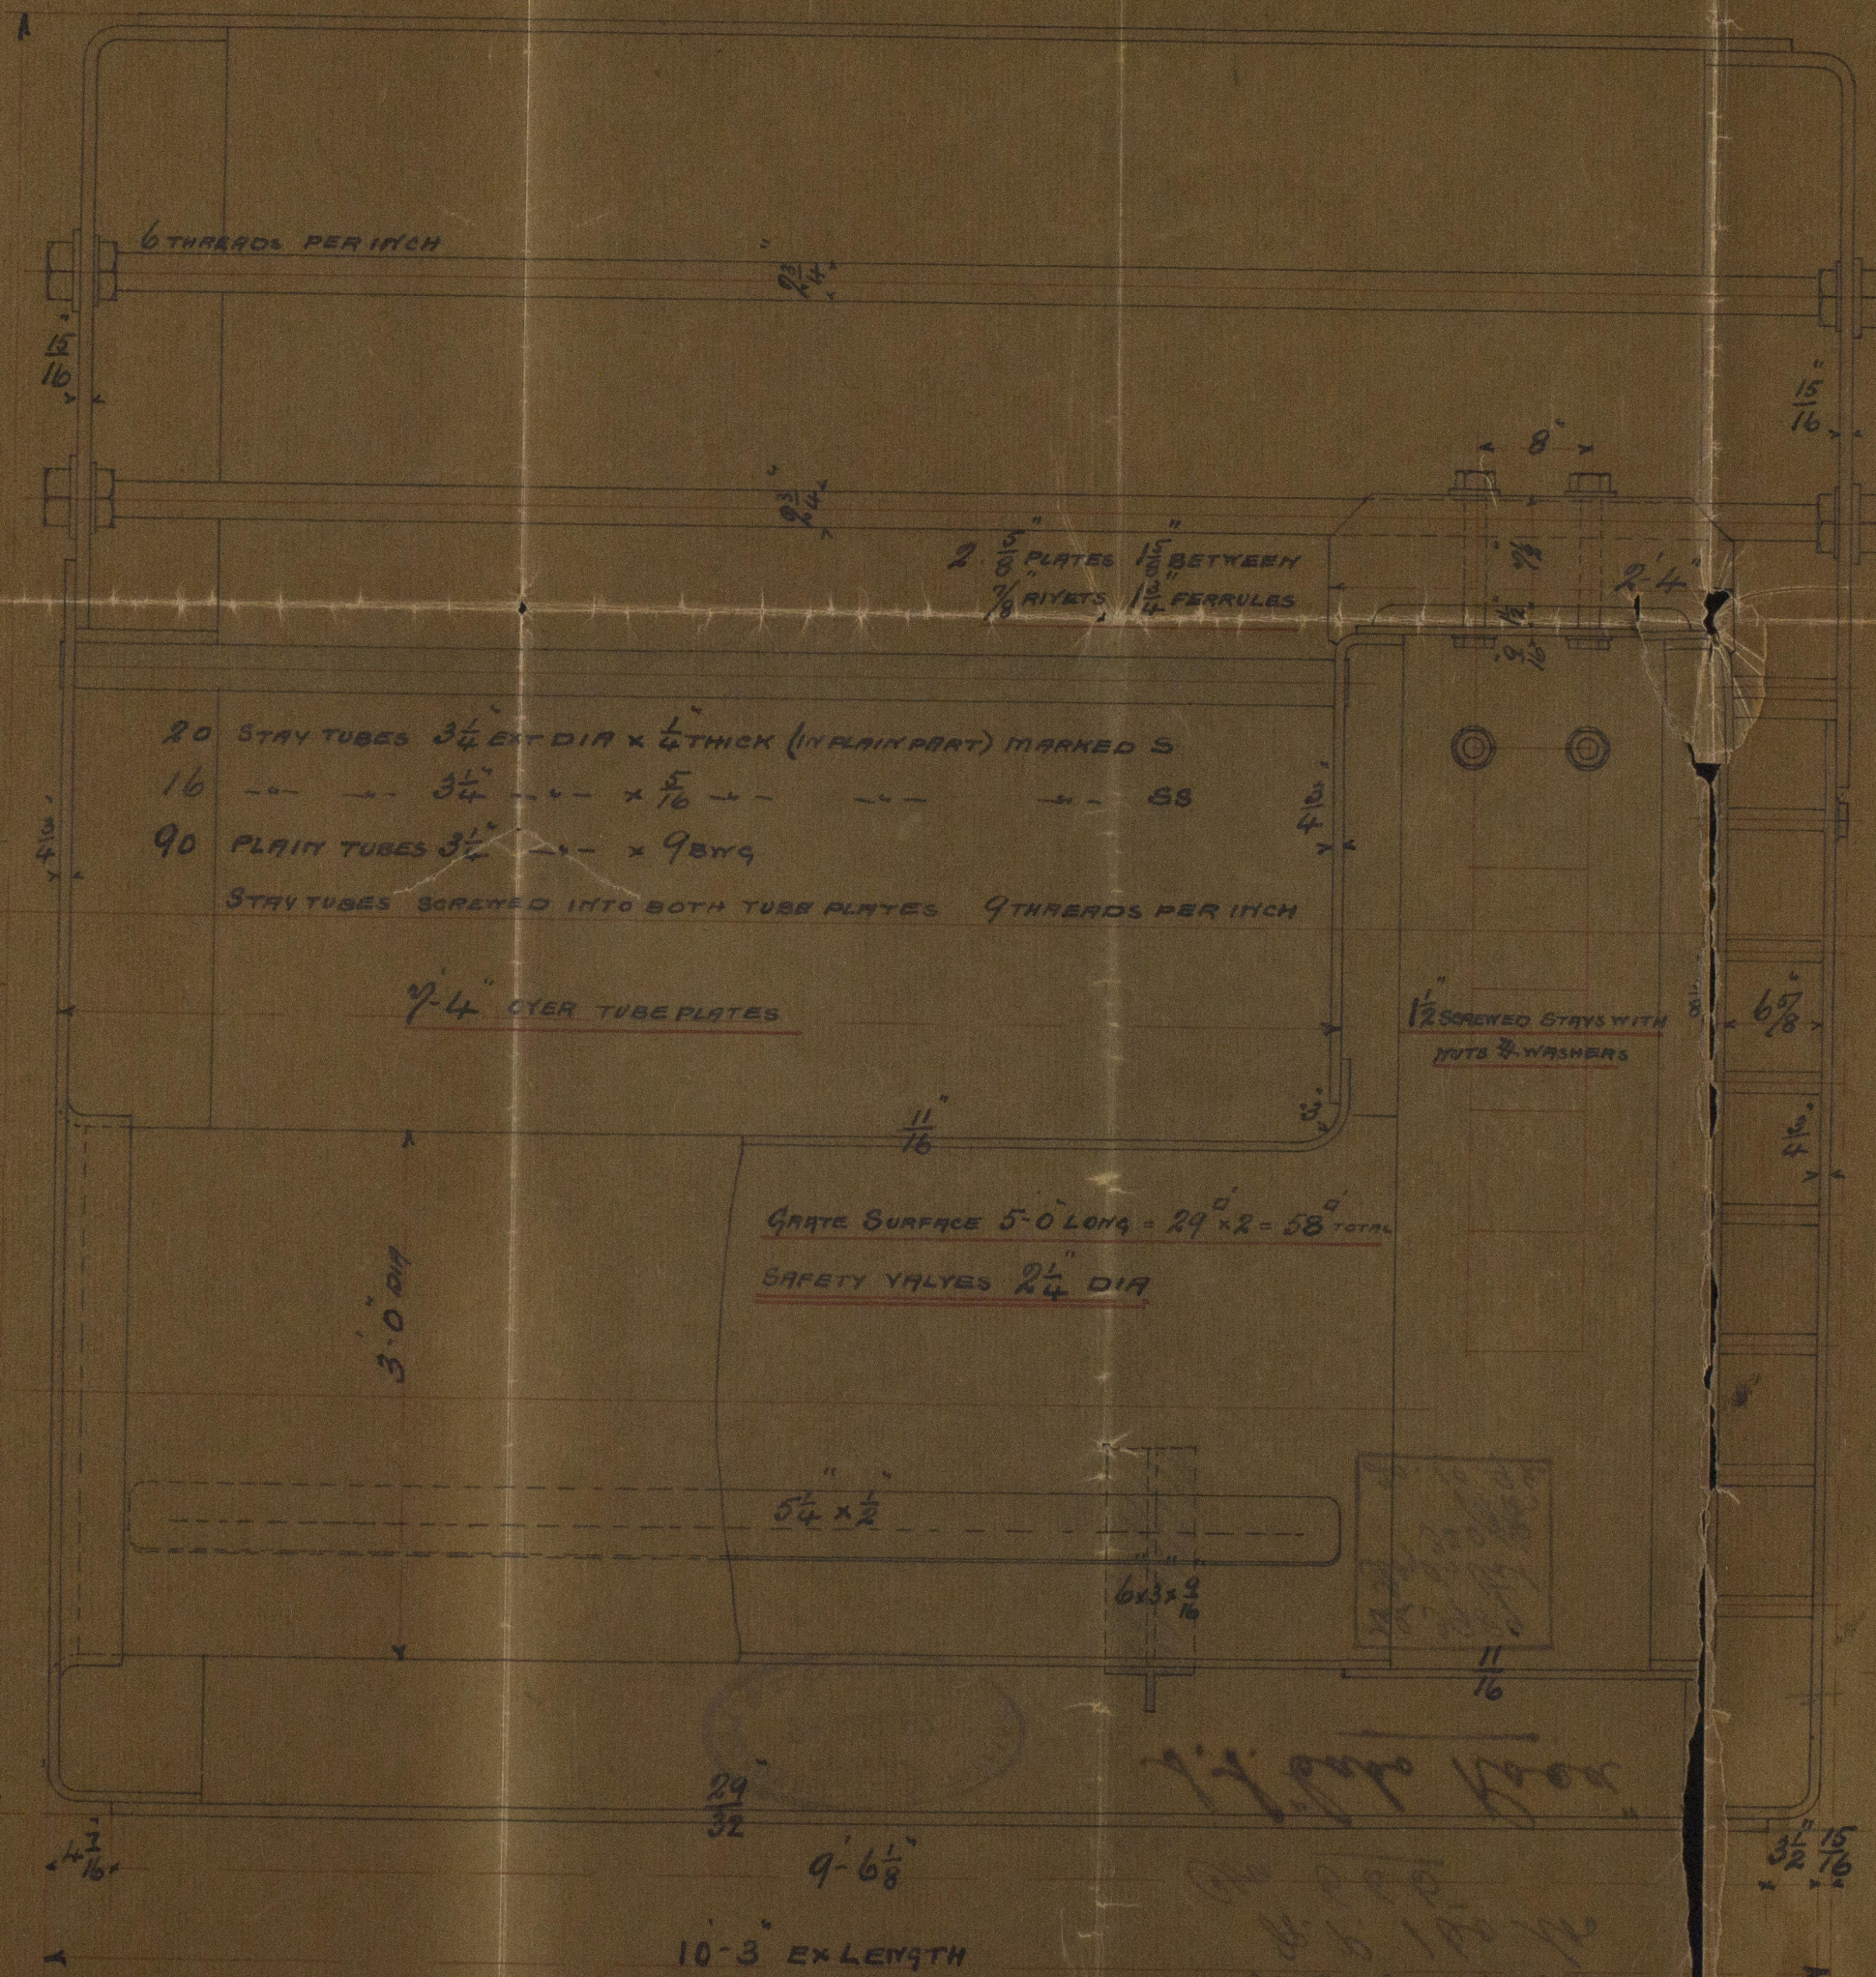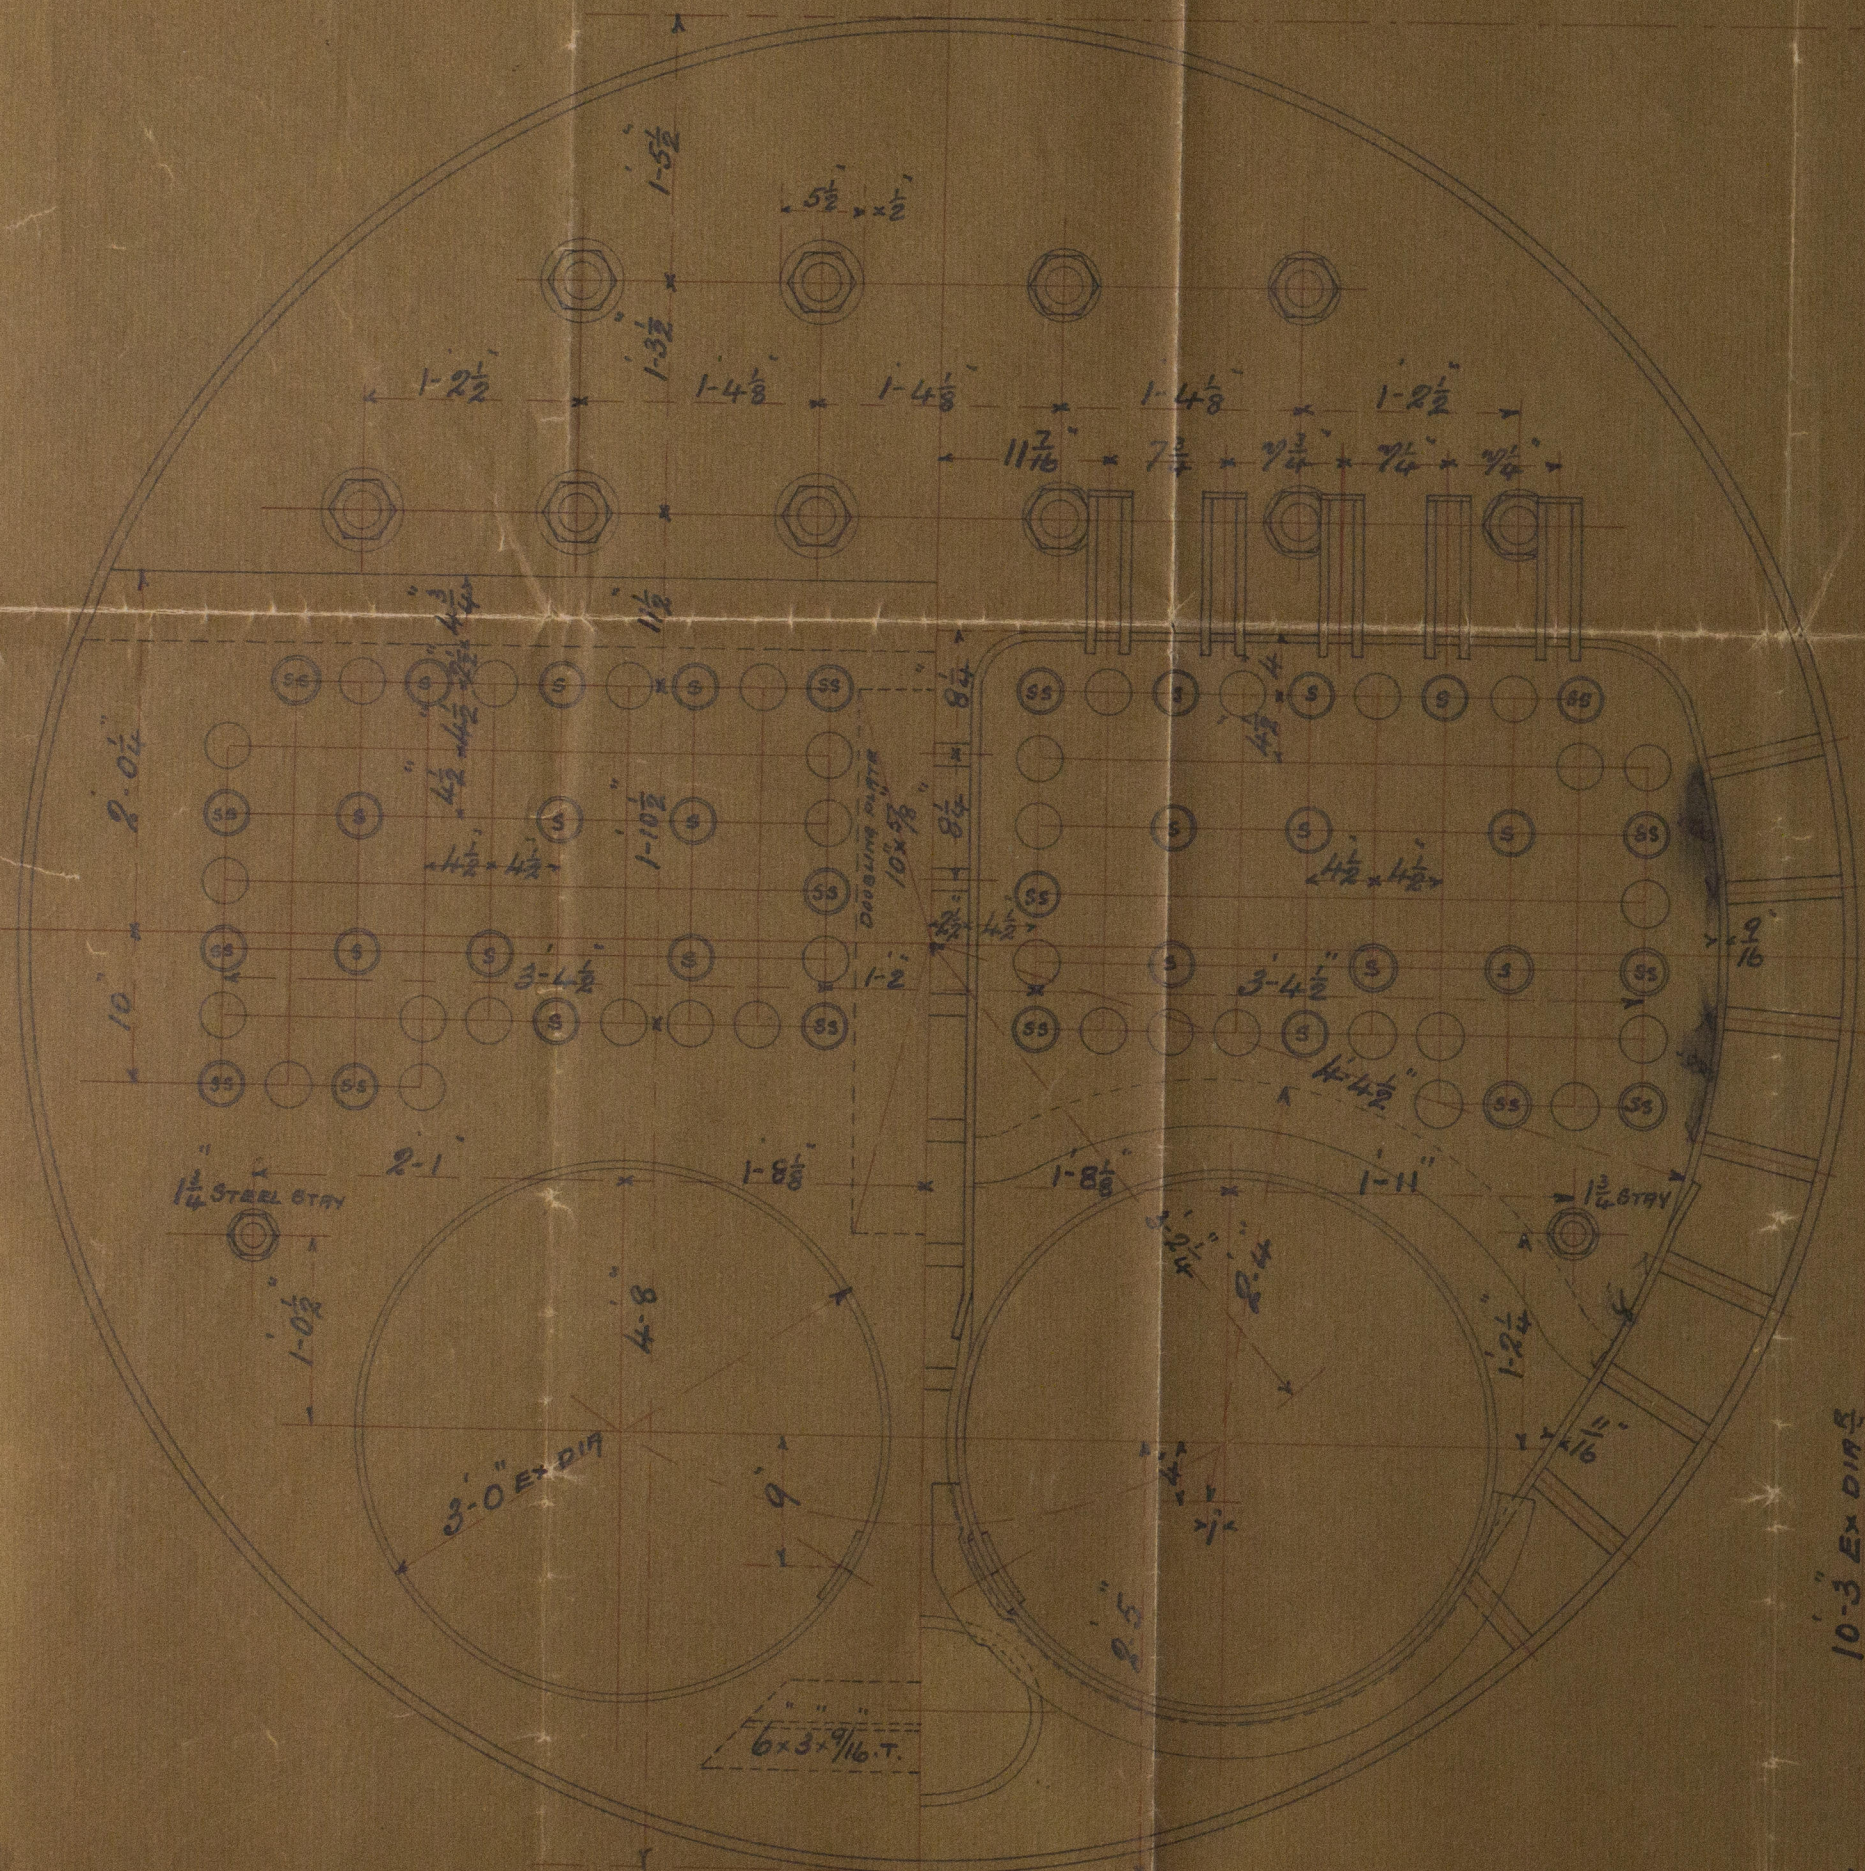

© 2020 Lloyd's Register Foundation


2 OFF CONTRACT 665



NWC829-0213

10-3 EXTENSION

d. p. 8

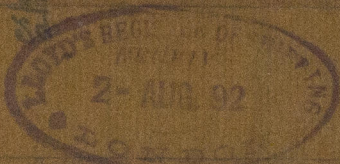

B. Dotsen 8000  
No. 56 Model  
R. P. 100 No  
Con 665

S. L. "Cabo Roed"

223989  
Hydrotal  
320/100  
20.10.92








© 2020

Lloyd's Register  
Foundation