

## Lloyd's Register of British and Foreign Shipping.

(Report on Vessel No. 28138 Port Newcastle)No. 1335 SHIP FORGINGS OR CASTINGS.

The words FORGINGS or CASTINGS, IRON or STEEL, should be struck out as may be required.

I have to report that the undermentioned Iron or Steel Forgings or Castings, manufactured by Messrs J March & Co of Dunston for the Vessel No. 56, being built by Messrs W Dobson & Co of Walker have been inspected by me as set forth below, and found to be, so far as can be seen, sound


Mark on Forgings.

Lloyd's

No 1951BJBJohn C CraigNewcastle7/10/92

	STERN FRAME.	RUDDER FRAME.	STEM.
Material* - - - -	<u>Scrap Iron</u>	<u>Scrap Iron</u>	<u>Scrap Iron</u>
How made - - - -	<u>Forged</u>	<u>Forged</u>	<u>Forged</u>
Dimensions - - - -	<u>8 - 4 3/4</u>	<u>5 1/4 - 3</u>	<u>7 - 2 3/8</u>
Progress on Inspection -	<u>Forged &amp; Smoothed</u>	<u>Forged &amp; Smoothed</u>	<u>Smoothed</u>
Dates when Inspected	<u>July 22-28 August 15-25/92</u>	<u>September 20-24 29 October 11-25/92</u>	<u>August 24/92</u>

SKETCHES OF FRAMES SHEWING POSITION AND DESCRIPTION OF WELDS OF FORGINGS, OR PARTICULARS OF TESTS APPLIED TO CASTINGS.

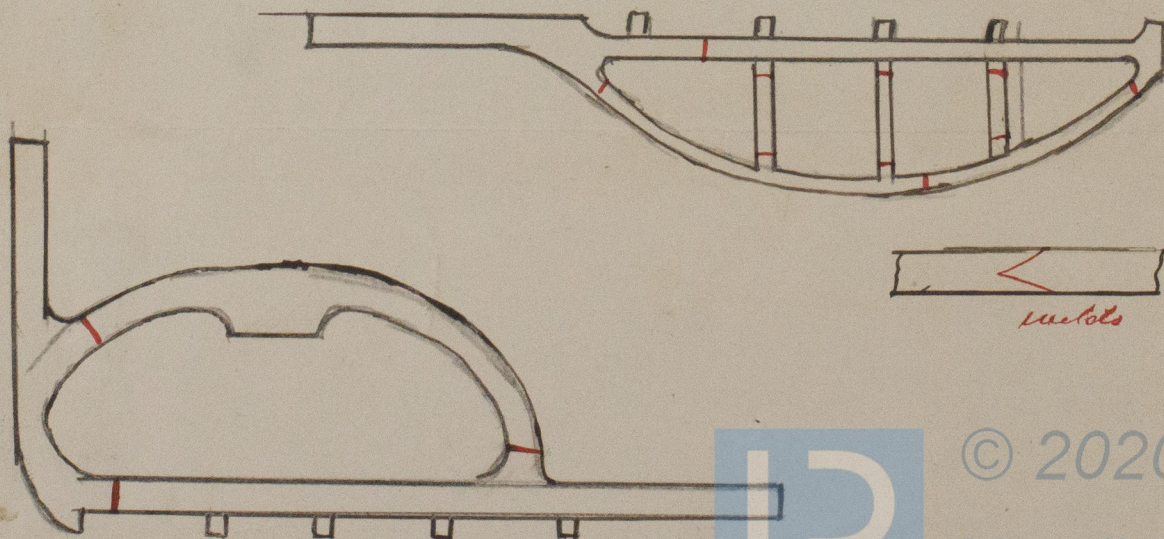



W.D. Johnson  
56

© 2020

Lloyd's Register  
Foundation

NWC829-0214