



25.3.93

# PROFILE S.S. N<sup>o</sup> 189

SCALE 1/8 INCH = ONE FOOT

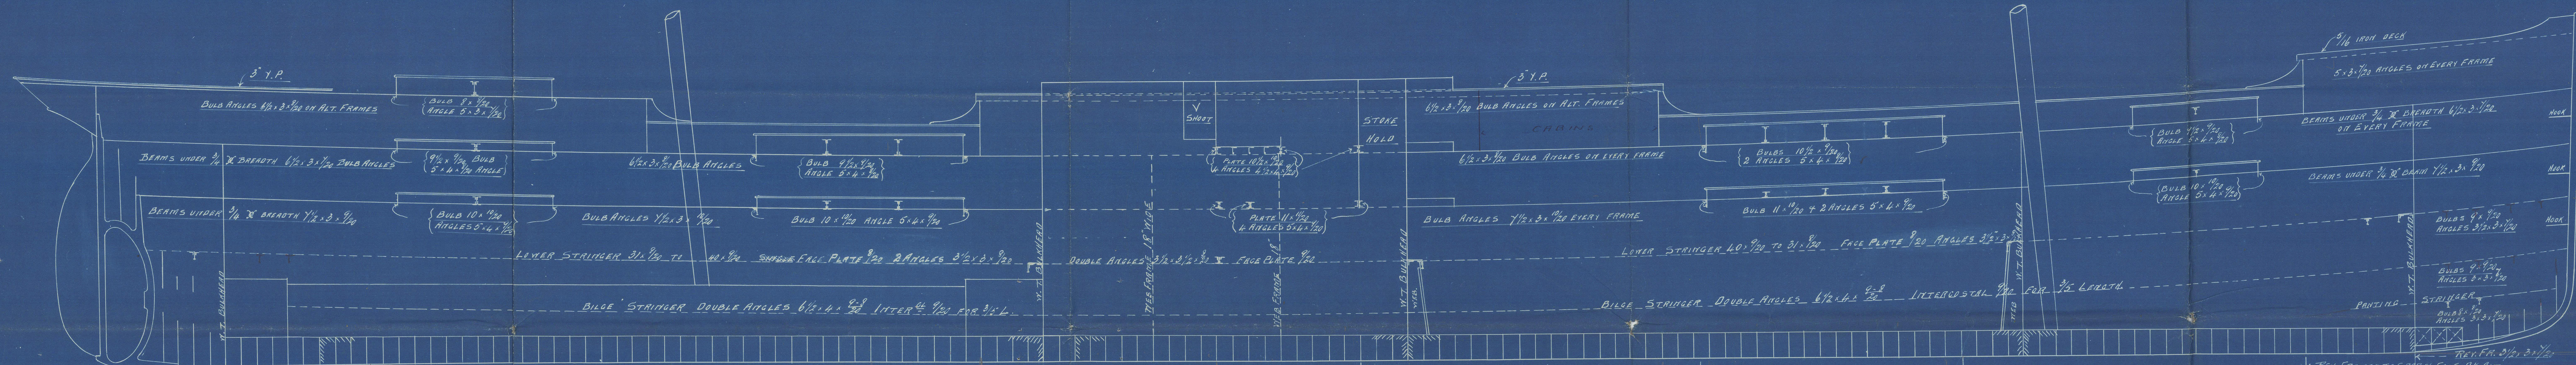

FRAMES 5 x 3 1/2 TO REV. DO. 3 1/2 x 3 1/2  
 ALT. REV. FRAMES TO SPAR + MAIN DECK  
 FRAMES 5 x 3 1/2 REV. FRAMES 5 1/2 x 3 1/2  
 ALT. REV. FRAMES TO SPAR + MAIN DECK  
 FRAMES 5 x 3 1/2 REV. FRAMES 5 1/2 x 3 1/2  
 ALL REV. FRAMES TO SPAR DECK  
 FRAMES 5 x 3 1/2 REV. FRAMES 5 1/2 x 3 1/2  
 ALT. REV. FRAMES TO SPAR + MAIN DECK  
 FRAMES 5 x 3 1/2 REV. FRAMES 5 1/2 x 3 1/2  
 FRAMES 5 x 3 1/2 REV. FRAMES 5 1/2 x 3 1/2  
 FRAMES 5 x 3 1/2 REV. FRAMES 5 1/2 x 3 1/2  
 REV. FRAMES TO SPAR + FEEL. OR ALT.

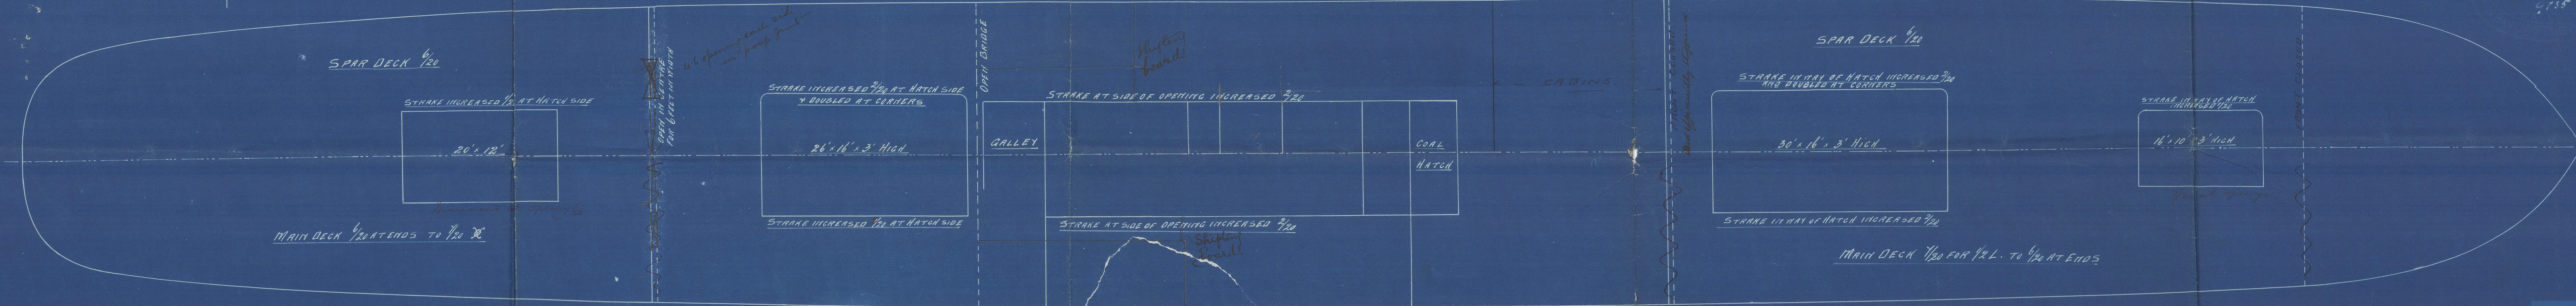


MARCH 21<sup>st</sup> 93  
 1855



S. S. No 189  
Profile

4 1/2 "Layo Mono"

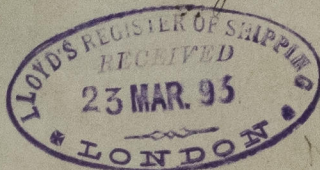

have freeboard report  
 No 29194

have report.  
 No. 29305-



© 2021

Lloyd's Register  
 Foundation



Messrs Swan & Hunter.

No 189

Fold. Report No 28705



© 2021

Lloyd's Register  
Foundation