
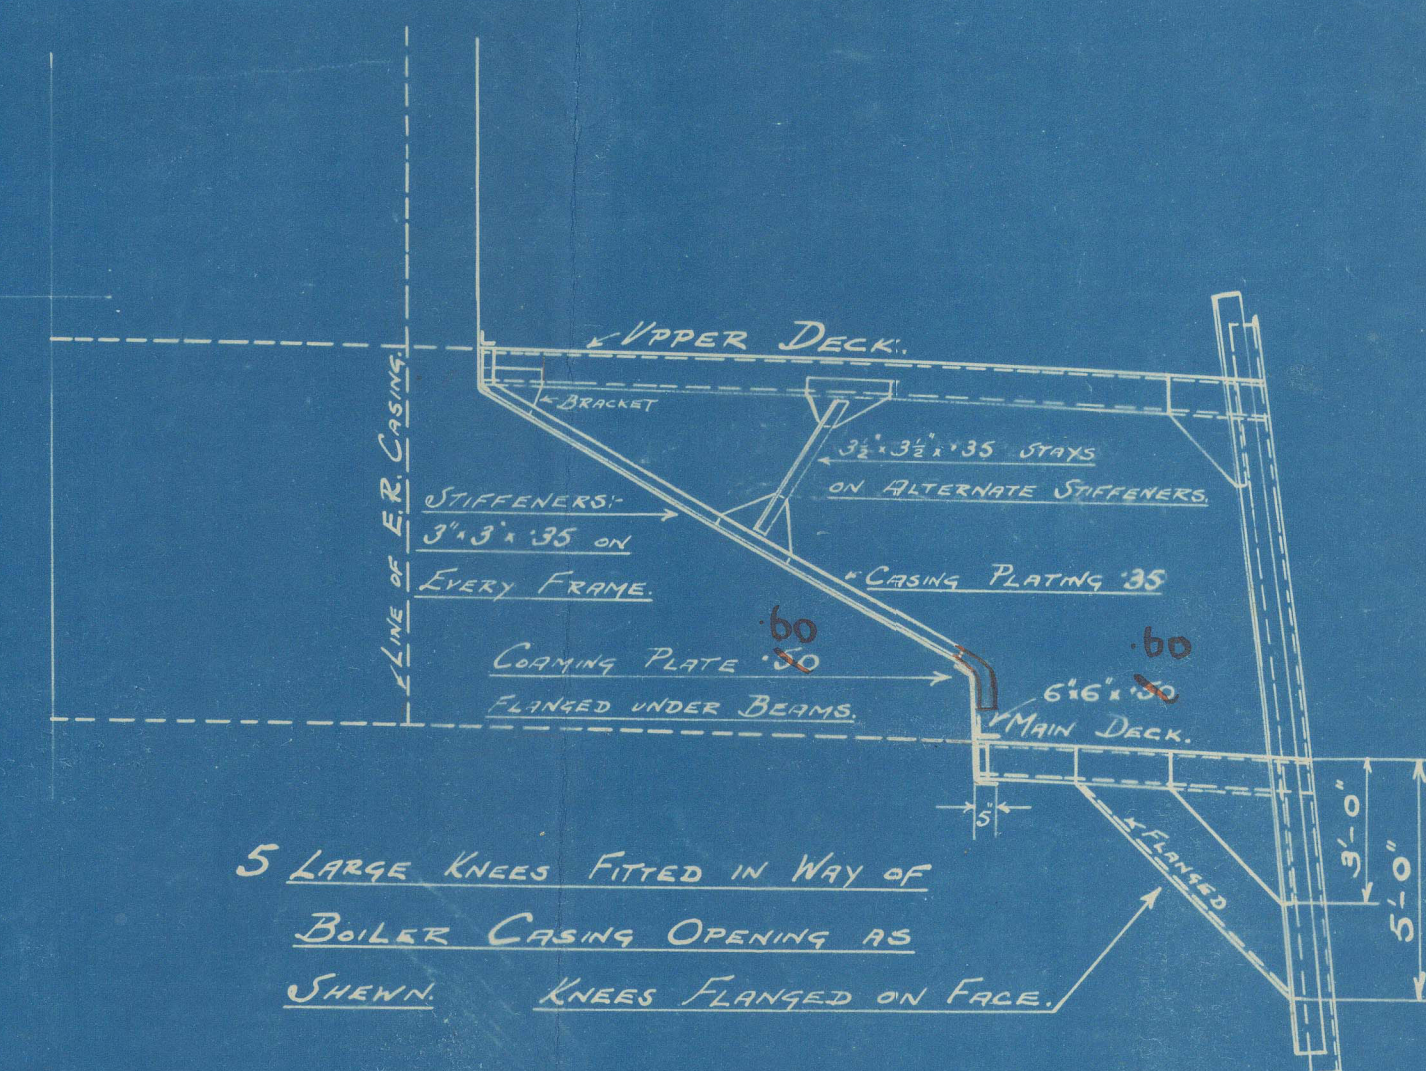
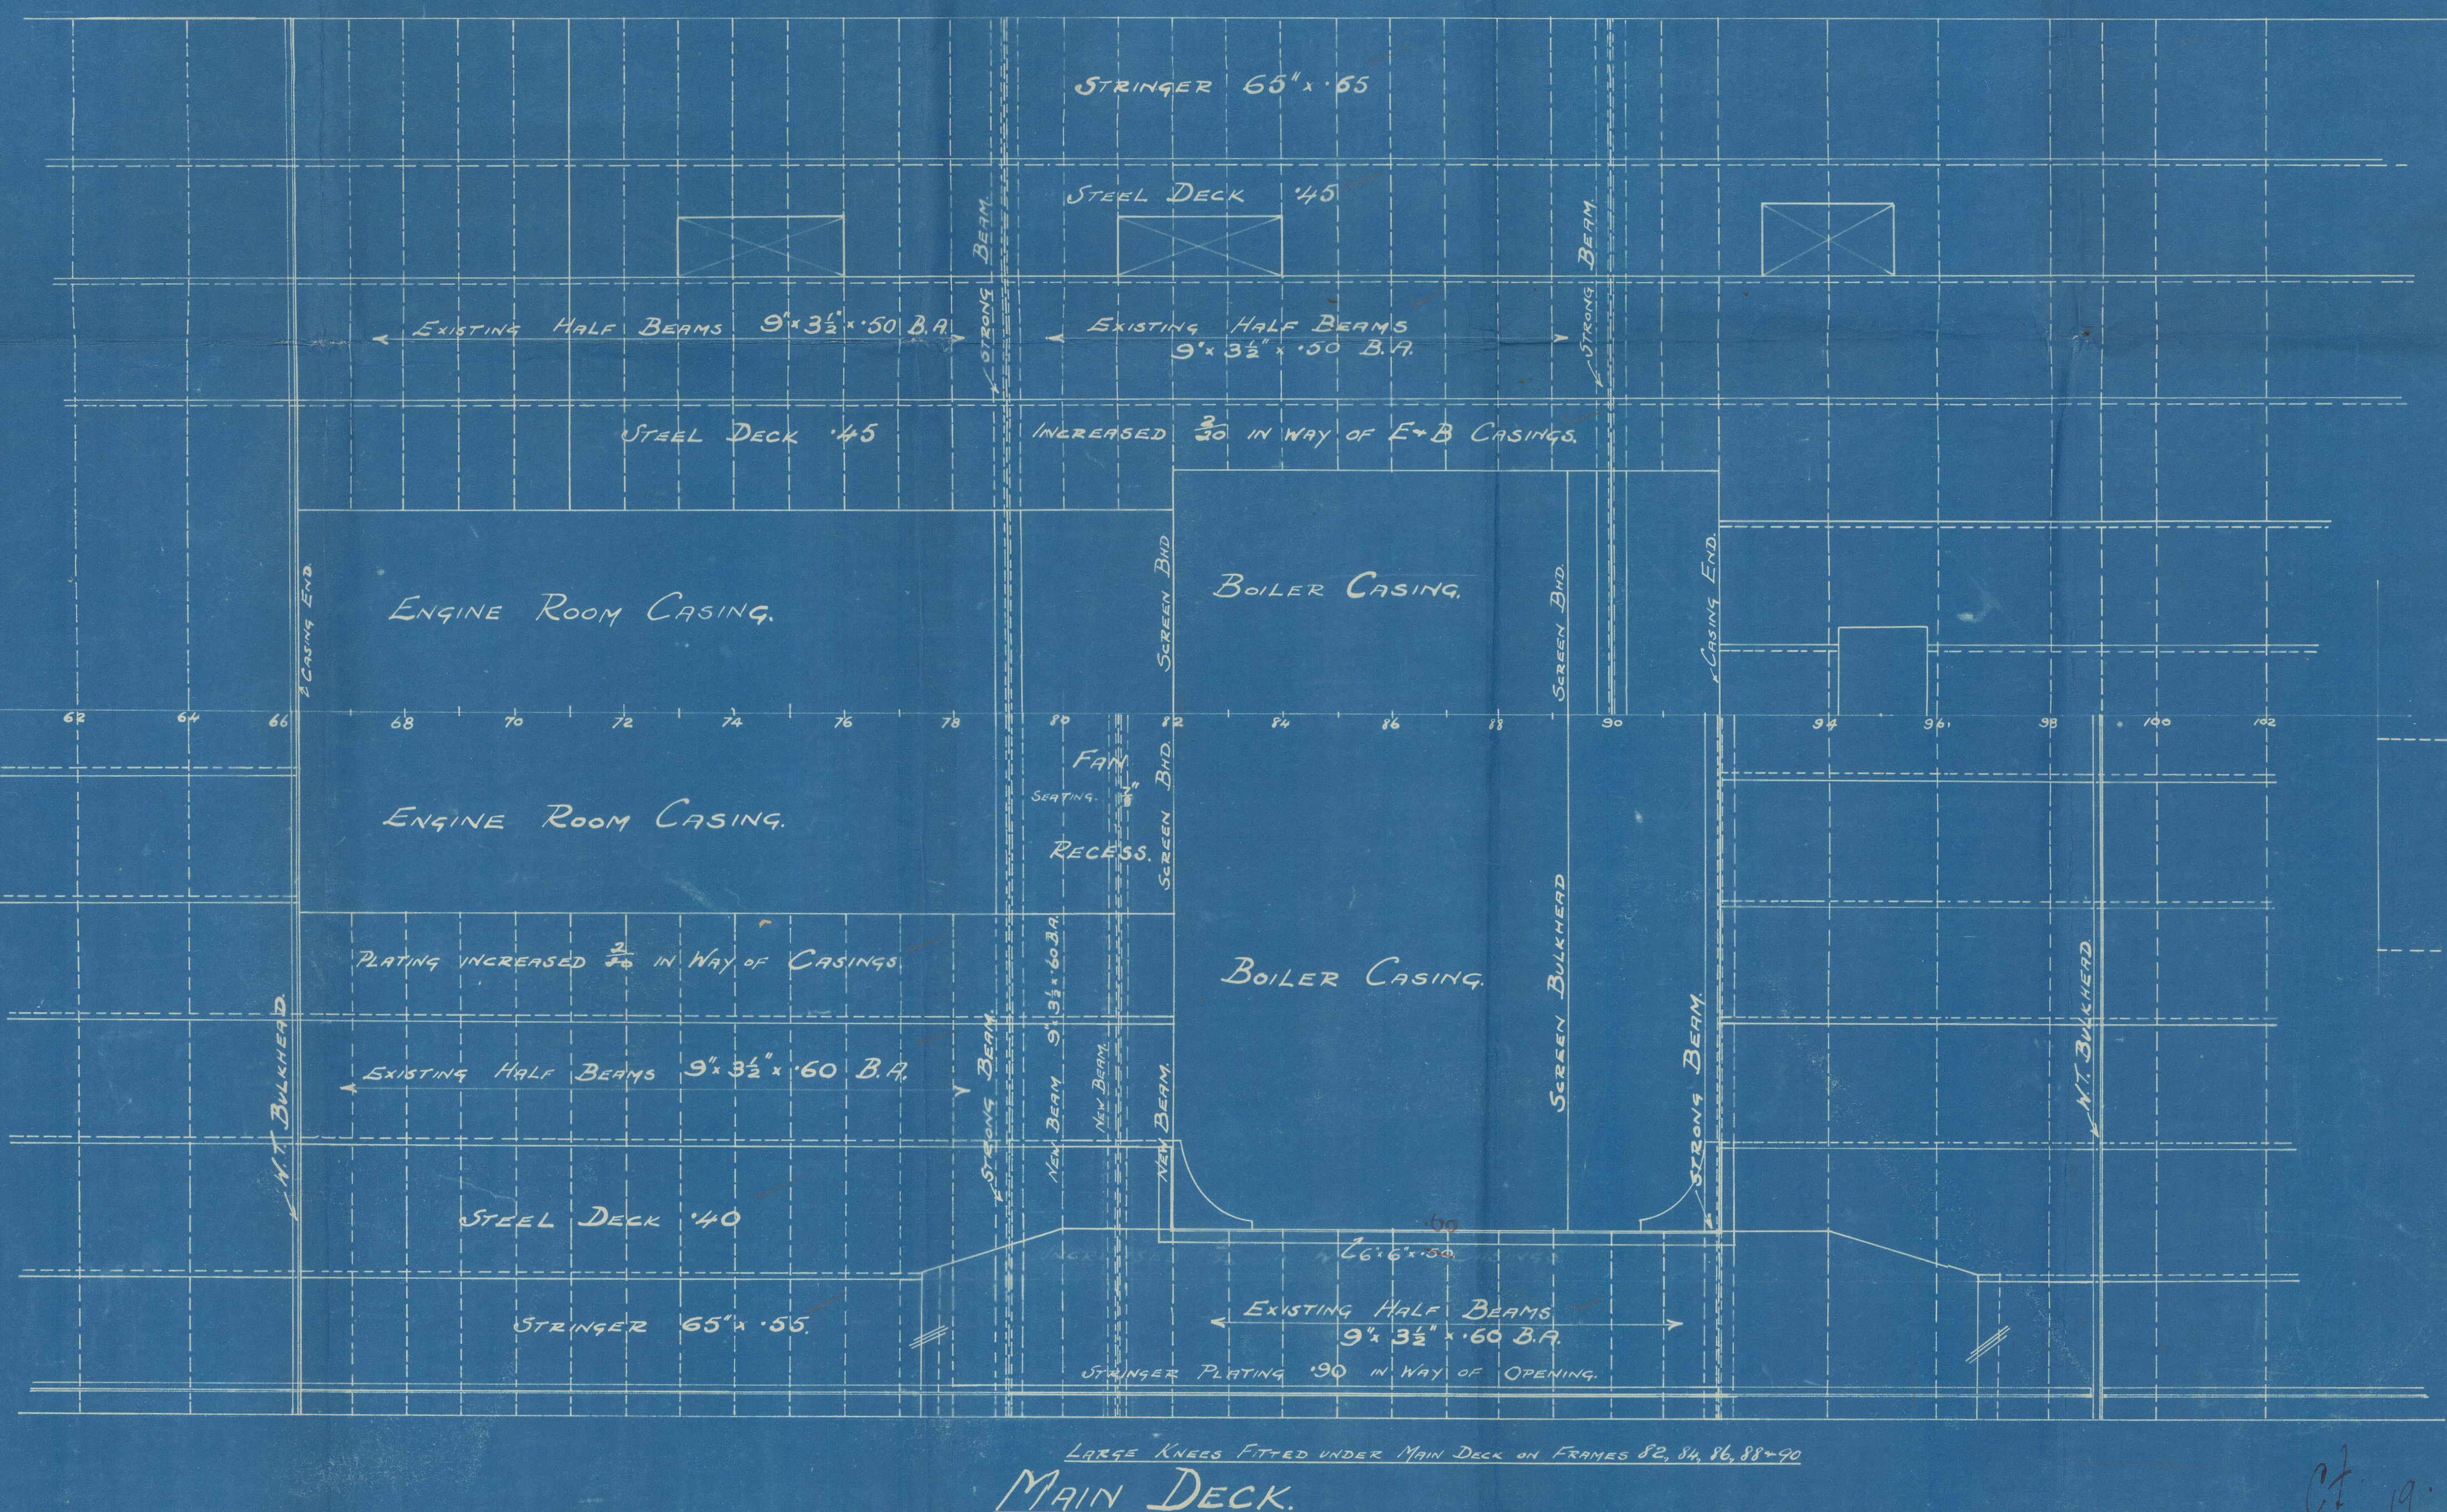


S.S. "BROADWAY" Ex "CANONESA"

PLAN SHEWING PROPOSED STRUCTURAL ALTERATIONS IN  
WAY OF ENGINE AND BOILER SPACE.

SCALE  $\frac{1}{4}" = 1 \text{ FOOT}$

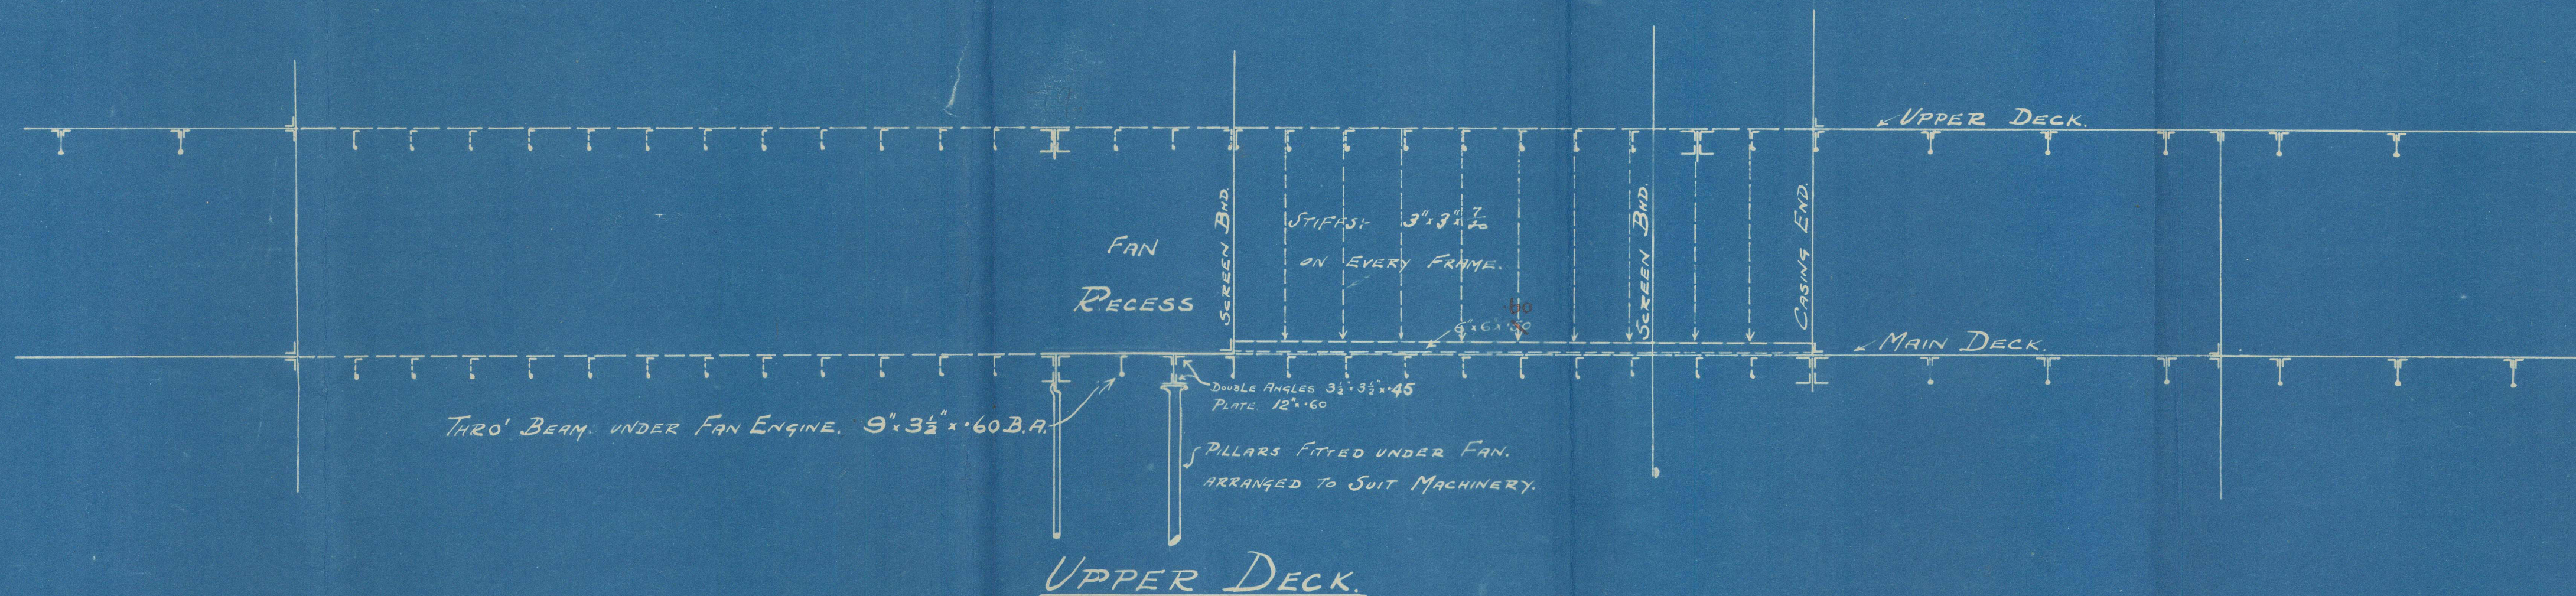

5 LARGE KNEES FITTED IN WAY OF  
BOILER CASING OPENING AS  
SHOWN. KNEES FLANGED ON FACE.

LARGE KNEES FITTED UNDER MAIN DECK ON FRAMES 82, 84, 86, 88 & 90

MAIN DECK.

13 MARCH 1919

MAB 16/19

CT. 19.  
25.3.19



L. S. "Broadway"

Ex "Canonesa"

Proposed Structural Alterations  
in way of Machinery Spaces.

Ex Rotherington pump

Ex Buteshire.

---



© 2021

Lloyd's Register  
NWC834-0064  
Foundation