
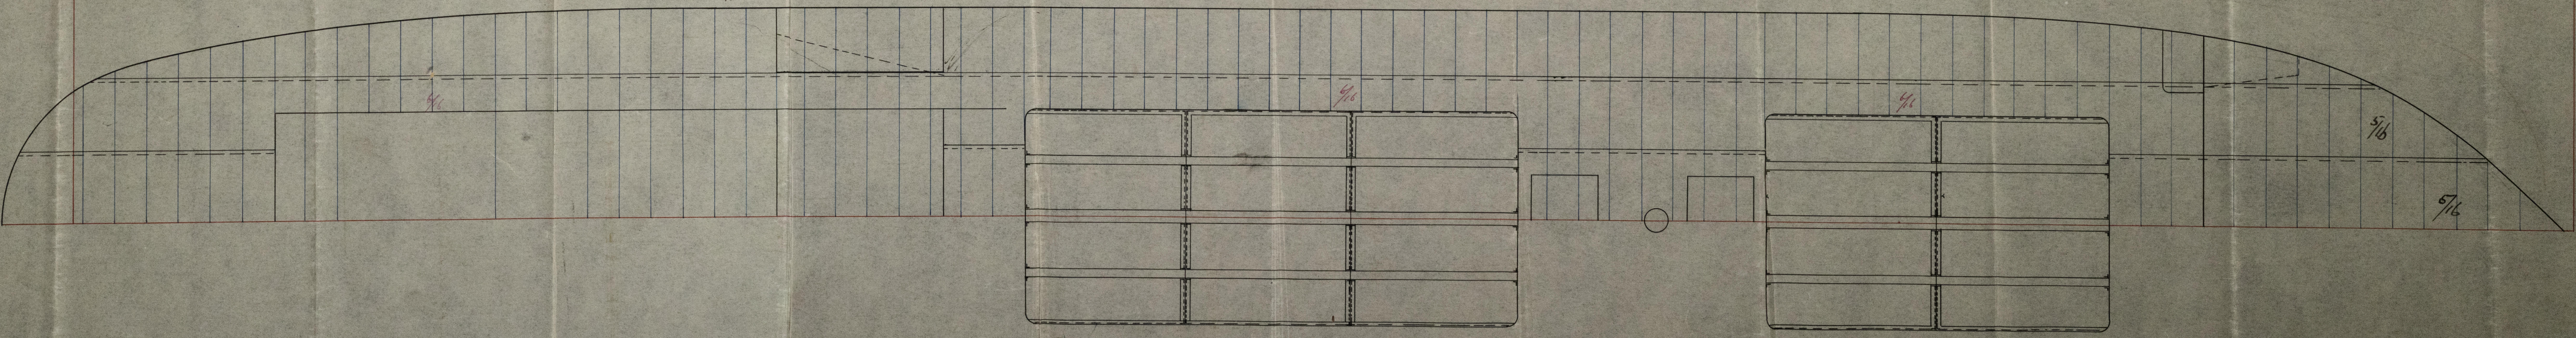
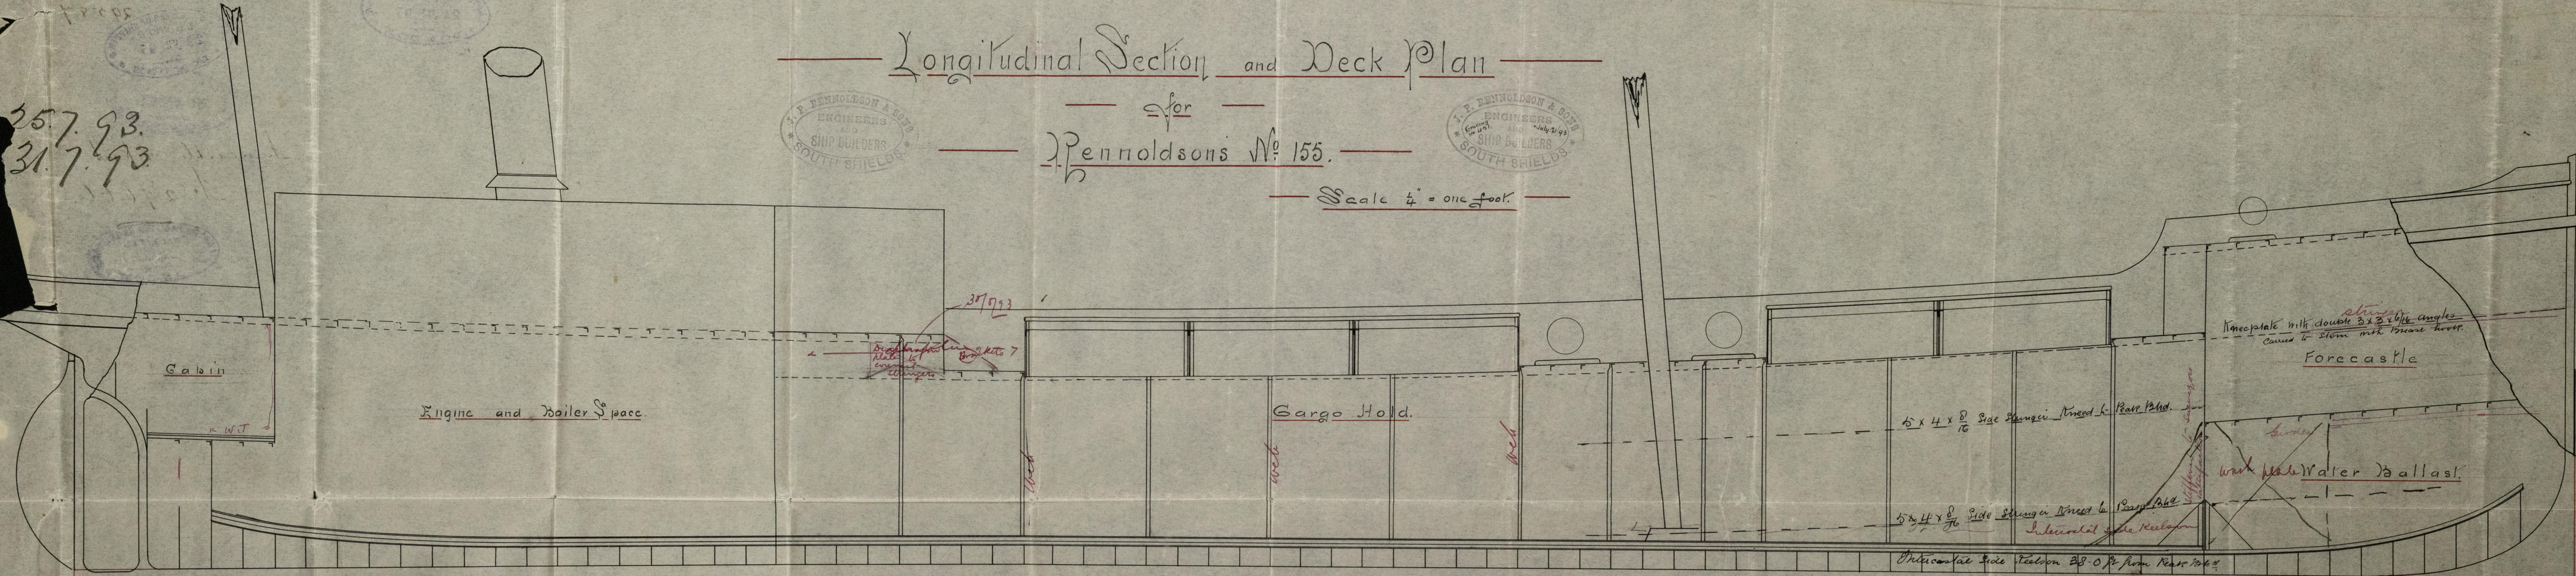



25.7.93.
31.7.93

Longitudinal Section and Deck Plan


for
Pennoldsons No 155.

Scale $\frac{1}{4}$ " = one foot.

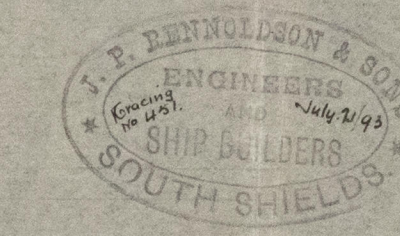


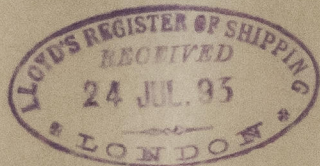


St. Treleigh
hwe. freeboard report.

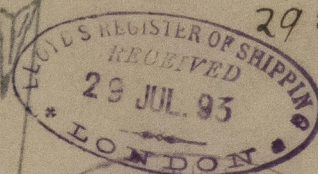

295-87

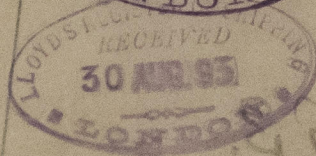

Newcastle report.
No. 29666.

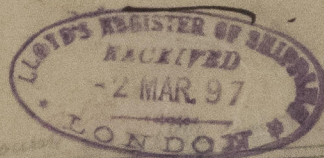

© 2021

Lloyd's Register
Foundation

NWC834 0161