


— SECTION IN WAY OF BRIDGE. —

— S.S. N^o 60. —

Scale $\frac{1}{2}'' = 1 \text{ foot.}$

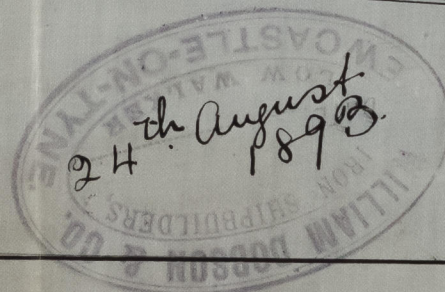

© 2021

Lloyd's Register Foundation


Handwritten notes: 44, 25-8-93

L210-5887MN

W. Dobson Esq
Bridge Deck
60.

"Port Elliot"

Report 8.85
No 29916

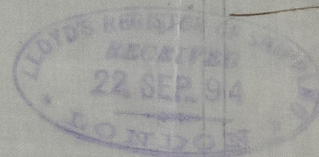

© 2021

Lloyd's Register
Foundation

NW835-0127