

PROFILE

No 60 SHIP, 62 x 64
SCALE: 1 FT.

SPAR DECK VESSEL 7.2.94

No 64 approved
AR DECK VESSEL 7.2.94

WILLIAM DOBSON & CO.
IRON SHIPBUILDERS
NEWCASTLE-ON-TYNE
LOW, WALKER & CO. LTD.
DATE June 14th 1892

© 2021
Lloyd's Register
Foundation

~~Wm. Dobson & Co~~
Profile
60, 2 x 4

Newcastle freeboard
report to 28826

^{S.S.}
"Port Elliot"



Verification report
to 29771

Report to 29916

PROF.

No 60 SH

SEAL

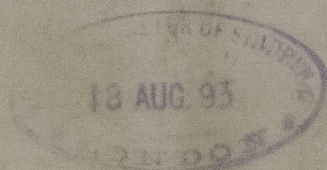 

© 2021



Lloyd's Register
Foundation