

18.8.93



— DECK PLATING. S. S. № 60. — 62 and 64

— SCALE  $\frac{1}{8}$  = 1 FOOT. —

Ho 64 approved  
 7.2.94.

SPAR DECK.

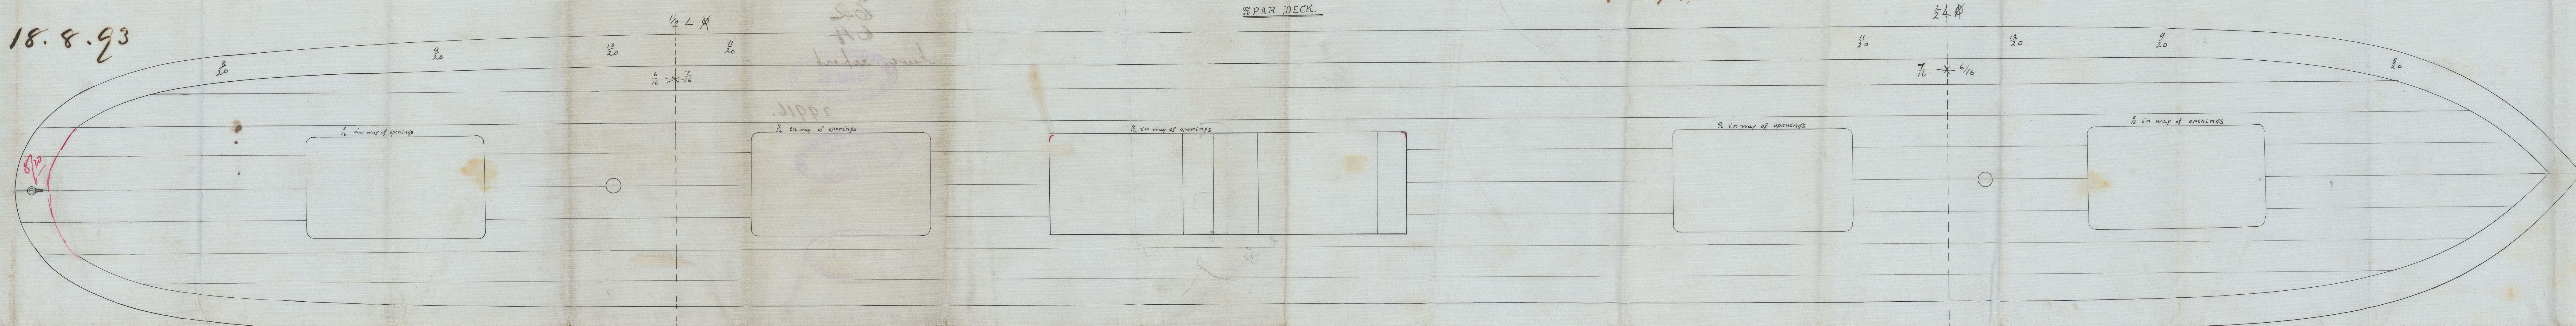



"Port Elliot

W. Dobson & Co W-60  
Seck plan

60

62

64

have report

29916.

© 2021

Lloyd's Register  
Foundation

NWL835-0130