

"Part 6 sheet"

Lloyd's Register of British and Foreign Shipping.

(Report on Vessel No. 29916 Port NEWCASTLE-ON-TYNE)

No. 1895 SHIP FORGINGS OR CASTINGS.

I have to report that the undermentioned Iron or Steel Forgings or Castings, manufactured by *The Jarrow Forge & Co* of *Jarrow* for the Vessel No. *60*, being built by *Messrs W Dobson & Co* of *Walker* have been inspected by me as set forth below, and found to be, so far as can be seen, *sound*

The words FORGINGS or CASTINGS, IRON or STEEL, should be struck out as may be required.

Mark on Forgings.


Lloyd's
No. 26950
J6

John C Craig
Newcastle

9/11/93

	STERN FRAME.	RUDDER FRAME.	STEM.
Material*	<i>Scrap Iron</i>	<i>Scrap Iron</i>	
How made	<i>Forged</i>	<i>Forged</i>	
Dimensions	<i>11-6</i>	<i>8 1/2 - 4 1/4</i>	
Progress on Inspection	<i>Forged & Smithed</i>	<i>Forged & Smithed</i>	<i>Not seen</i>
Date when Inspected	<i>July 11-18-27 August 2-8-10/93</i>	<i>October 17-19-27 Nov 8-15-21-27 December 6/93</i>	

SKETCHES OF FRAMES SHOWING POSITION AND DESCRIPTION OF WELDS OF FORGINGS, OR PARTICULARS OF TESTS APPLIED TO CASTINGS.

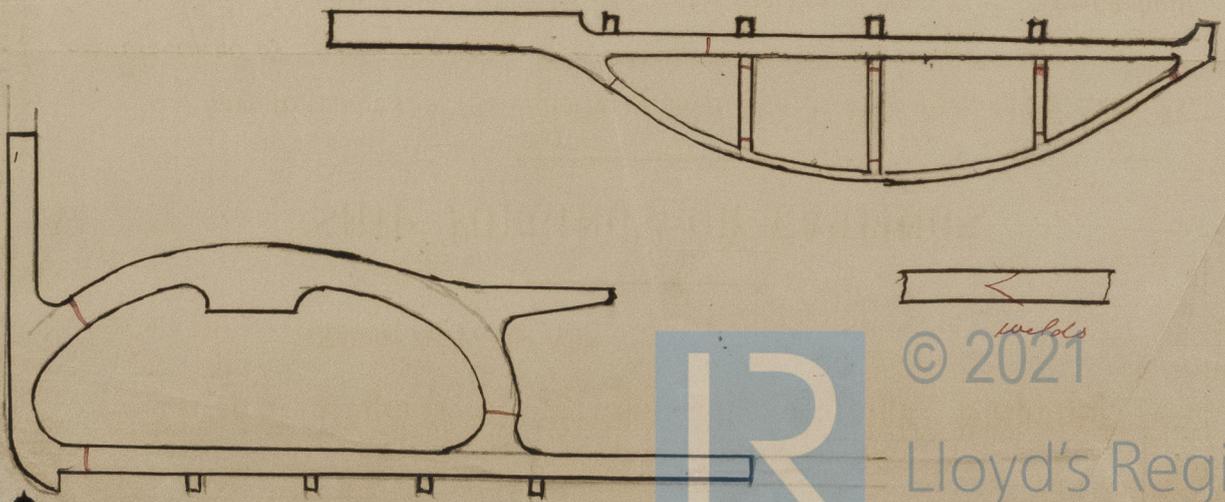

© 2021



Lloyd's Register Foundation

* If of Iron, state whether scrap or puddled Iron.

Dobson

60



© 2021

Lloyd's Register
Foundation