

P.A. 11.12.93

To pass Lloyds & Hamburg Law requirements

Tubes	305	¢
Furnaces	46	"
Com ^{by} Chambers	66	"
Tube Plates	<u>26</u>	
Total	443	\$9 ft





Test do 320 " " " 224 "

Materials

<i>Plates</i>	<i>~</i>	<i>Steel</i>
<i>Tubes</i>	<i>~</i>	<i>Iron</i>
<i>Rivets</i>	<i>~</i>	<i>Steel</i>
<i>Stays</i>	<i>~</i>	<i>Iron</i>

THE WALLSEND
SLIPWAY & ENGINEERING CO., LTD.
NEWCASTLE-UPON-TYNE.
25714 DATE Dec-7-93

Strength of Plate = 83.7%
Rivet = 84.1%

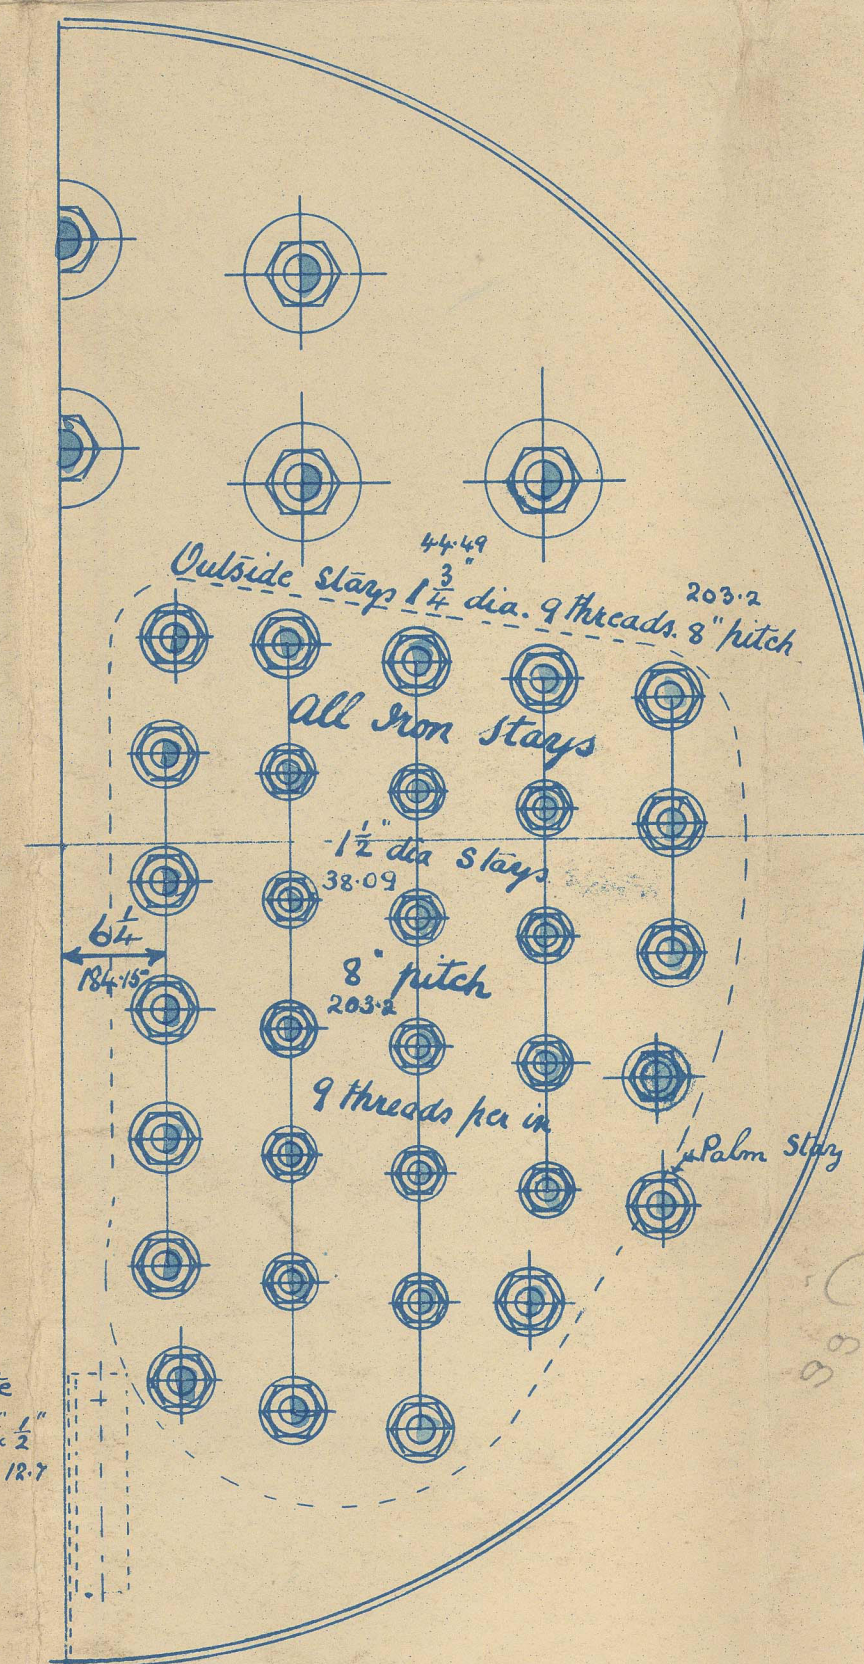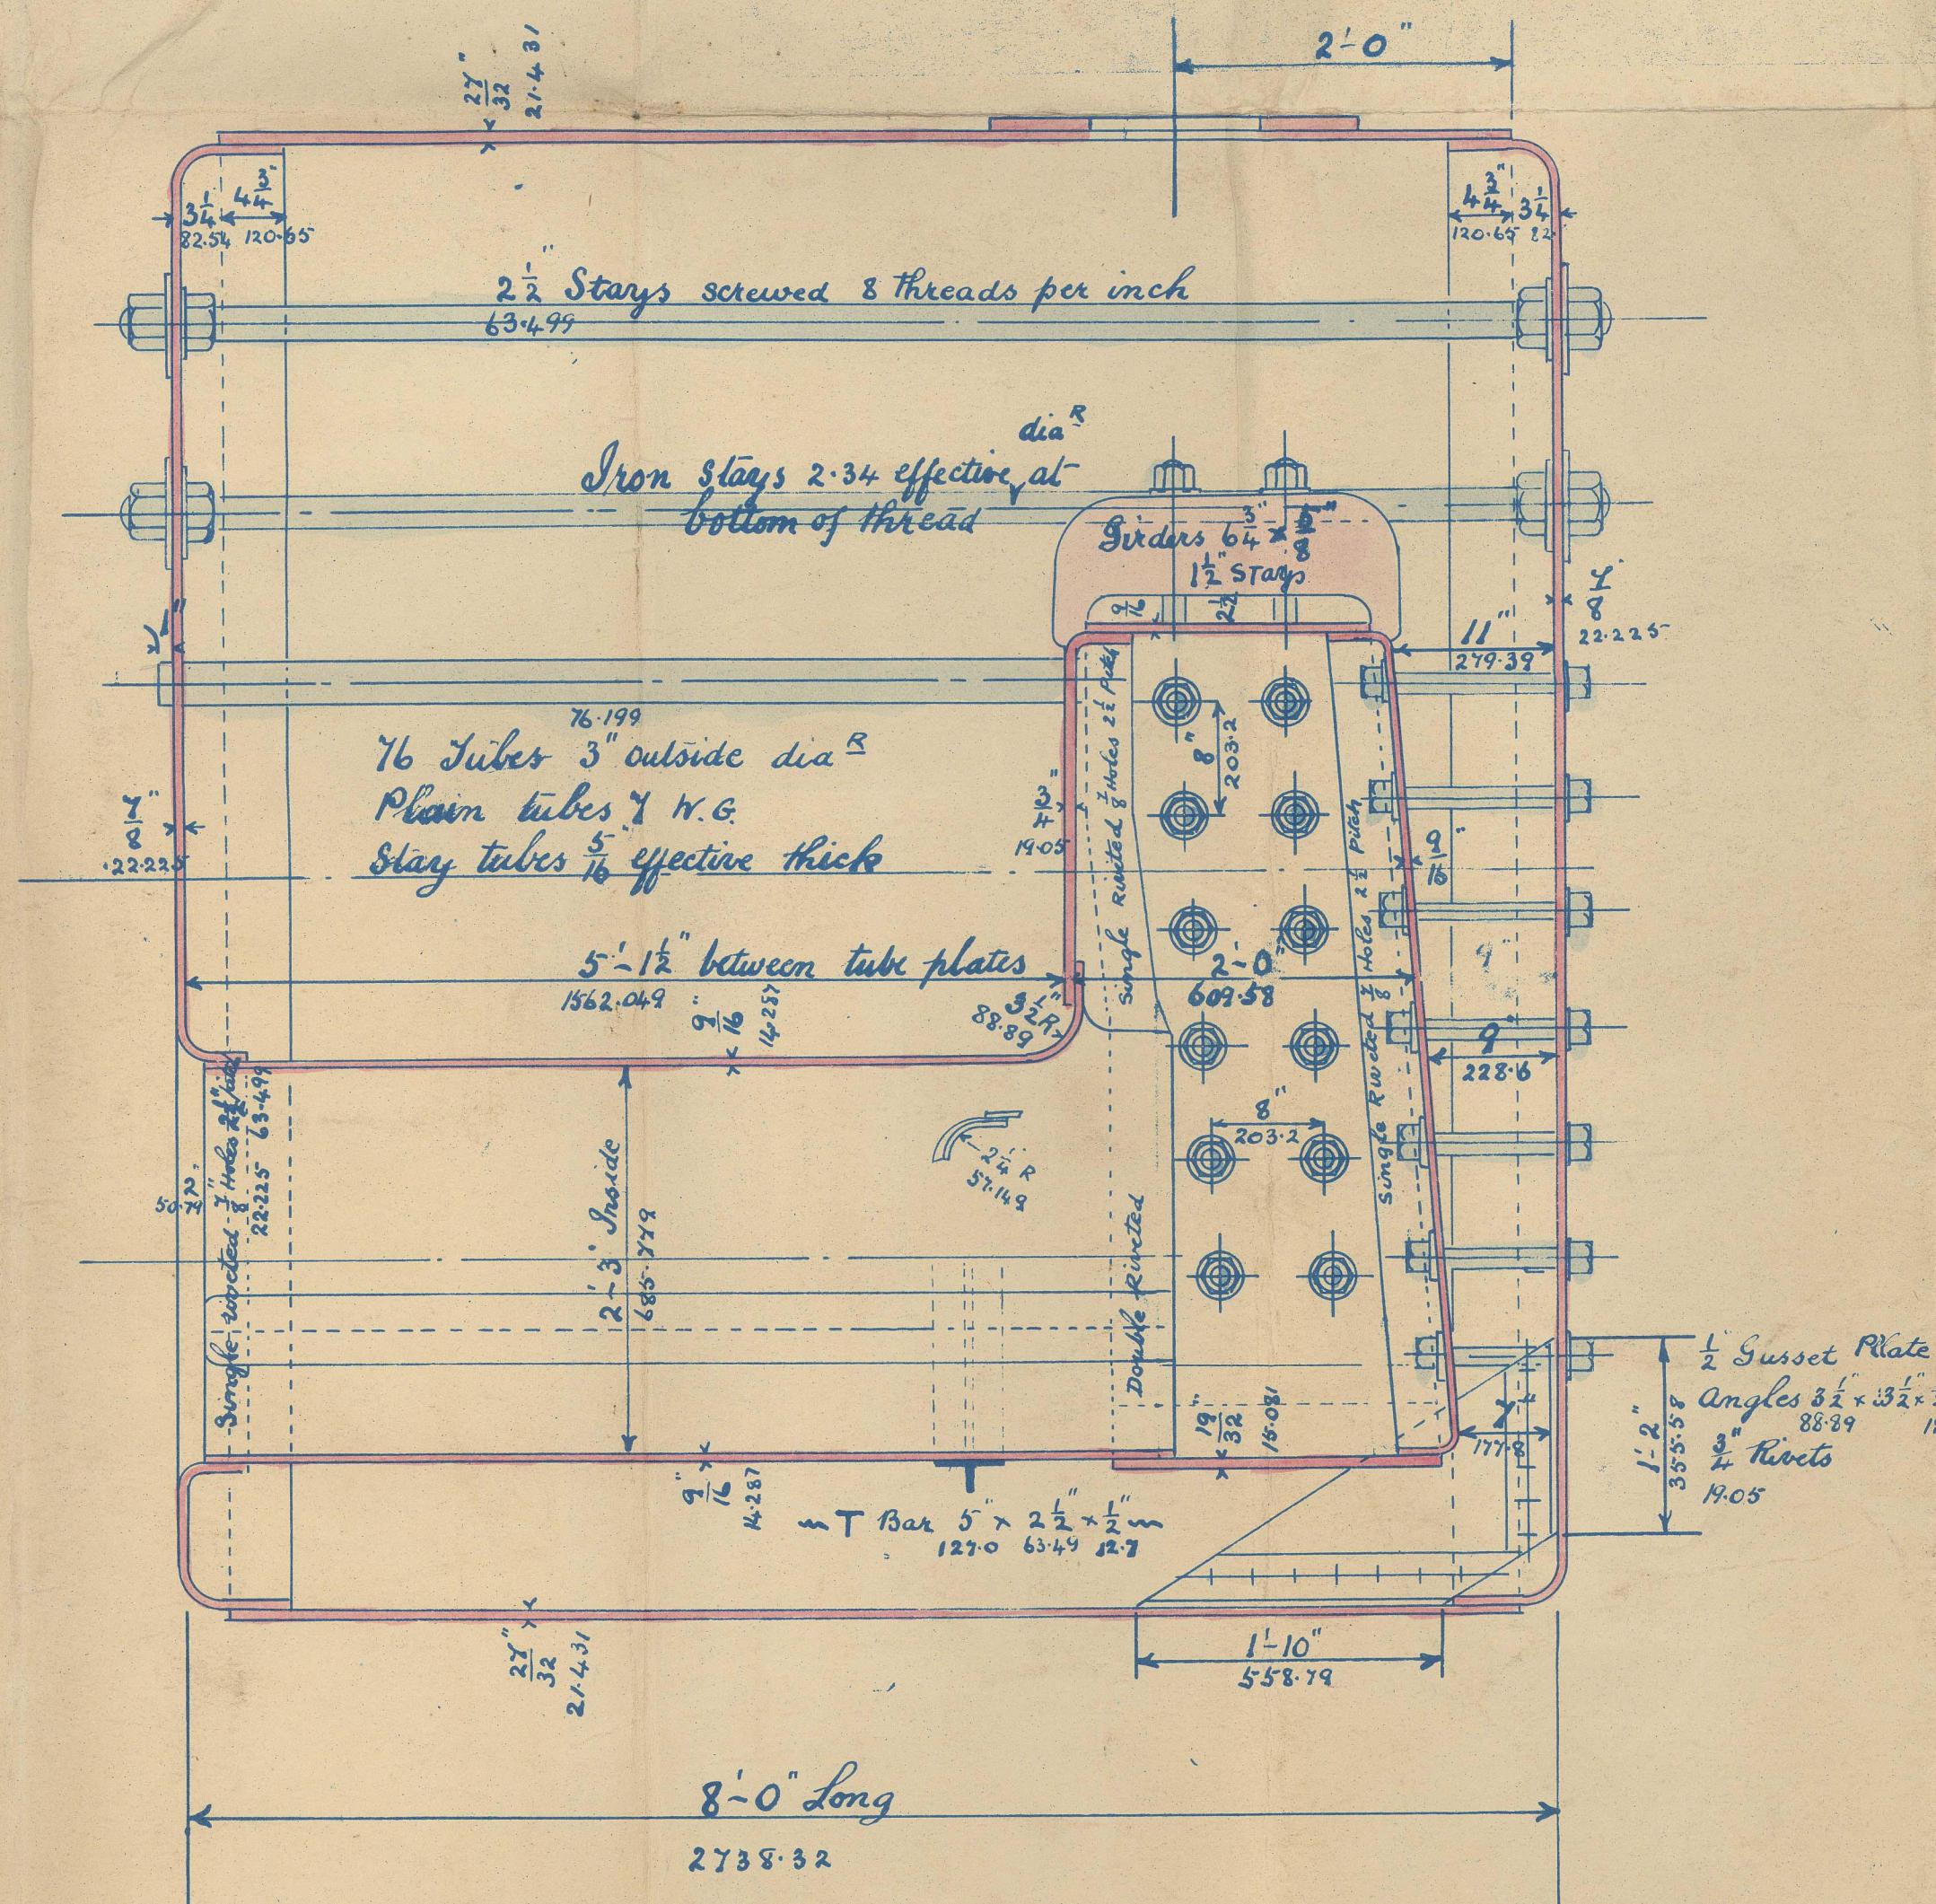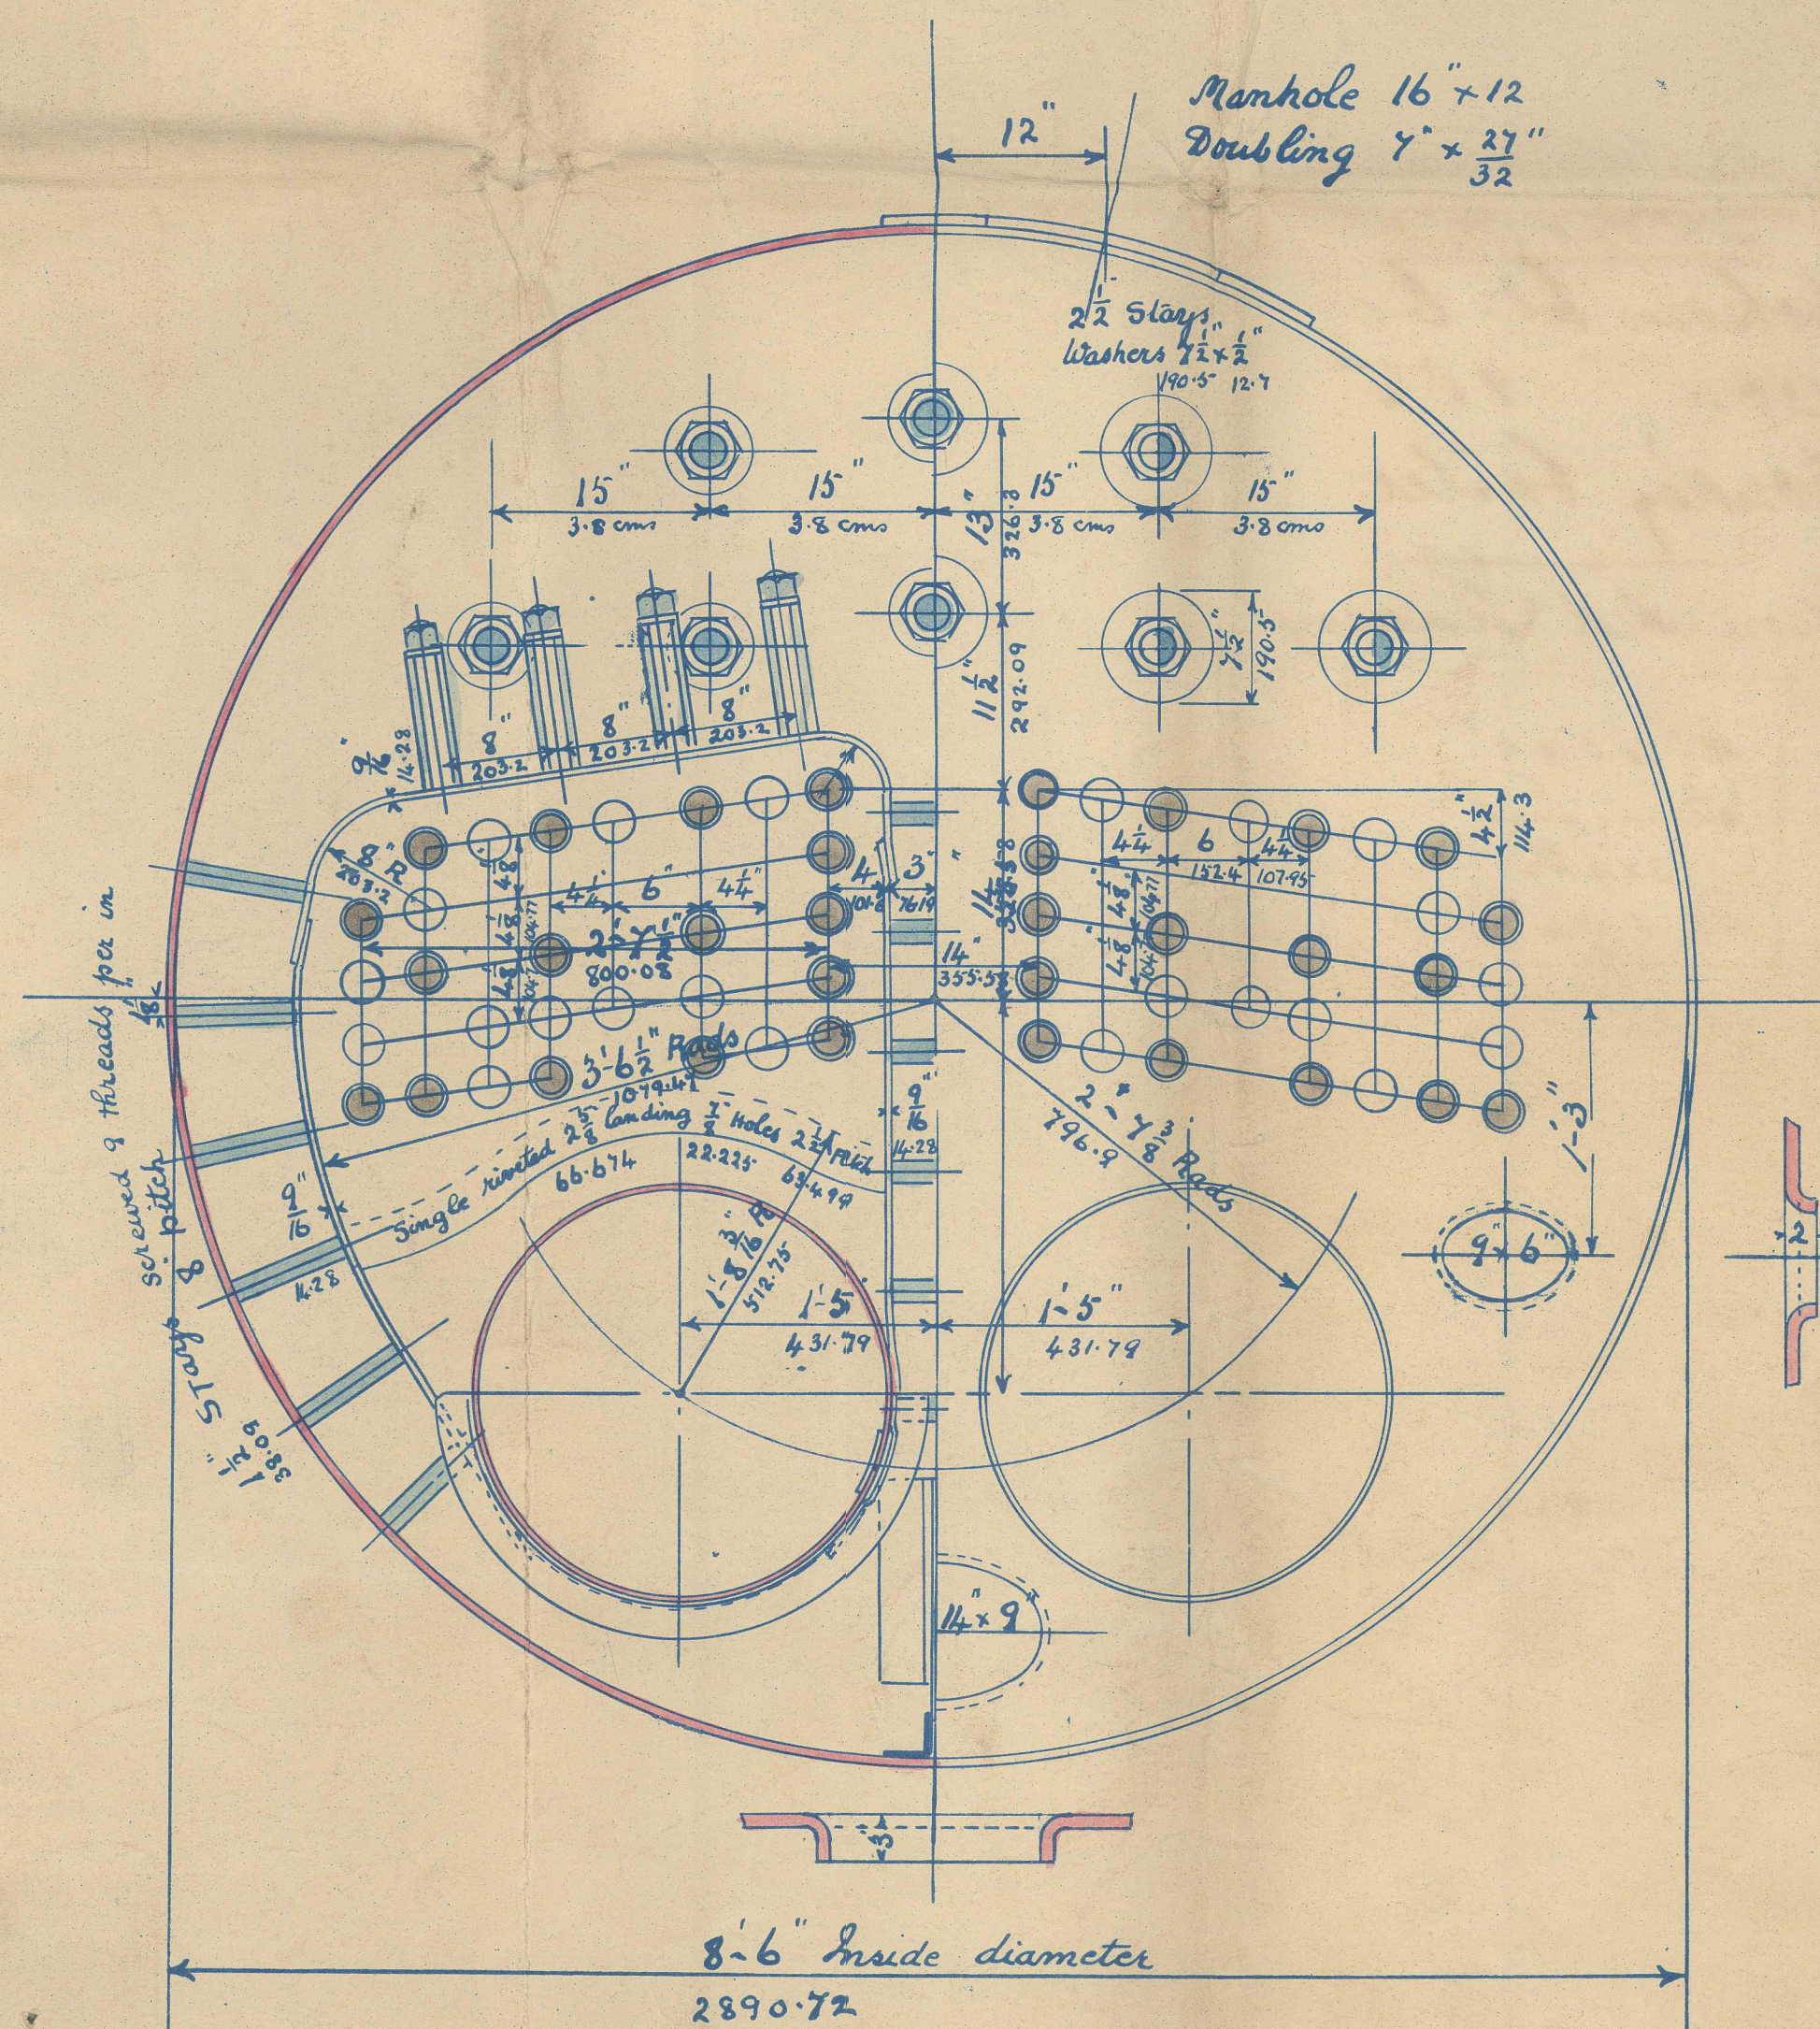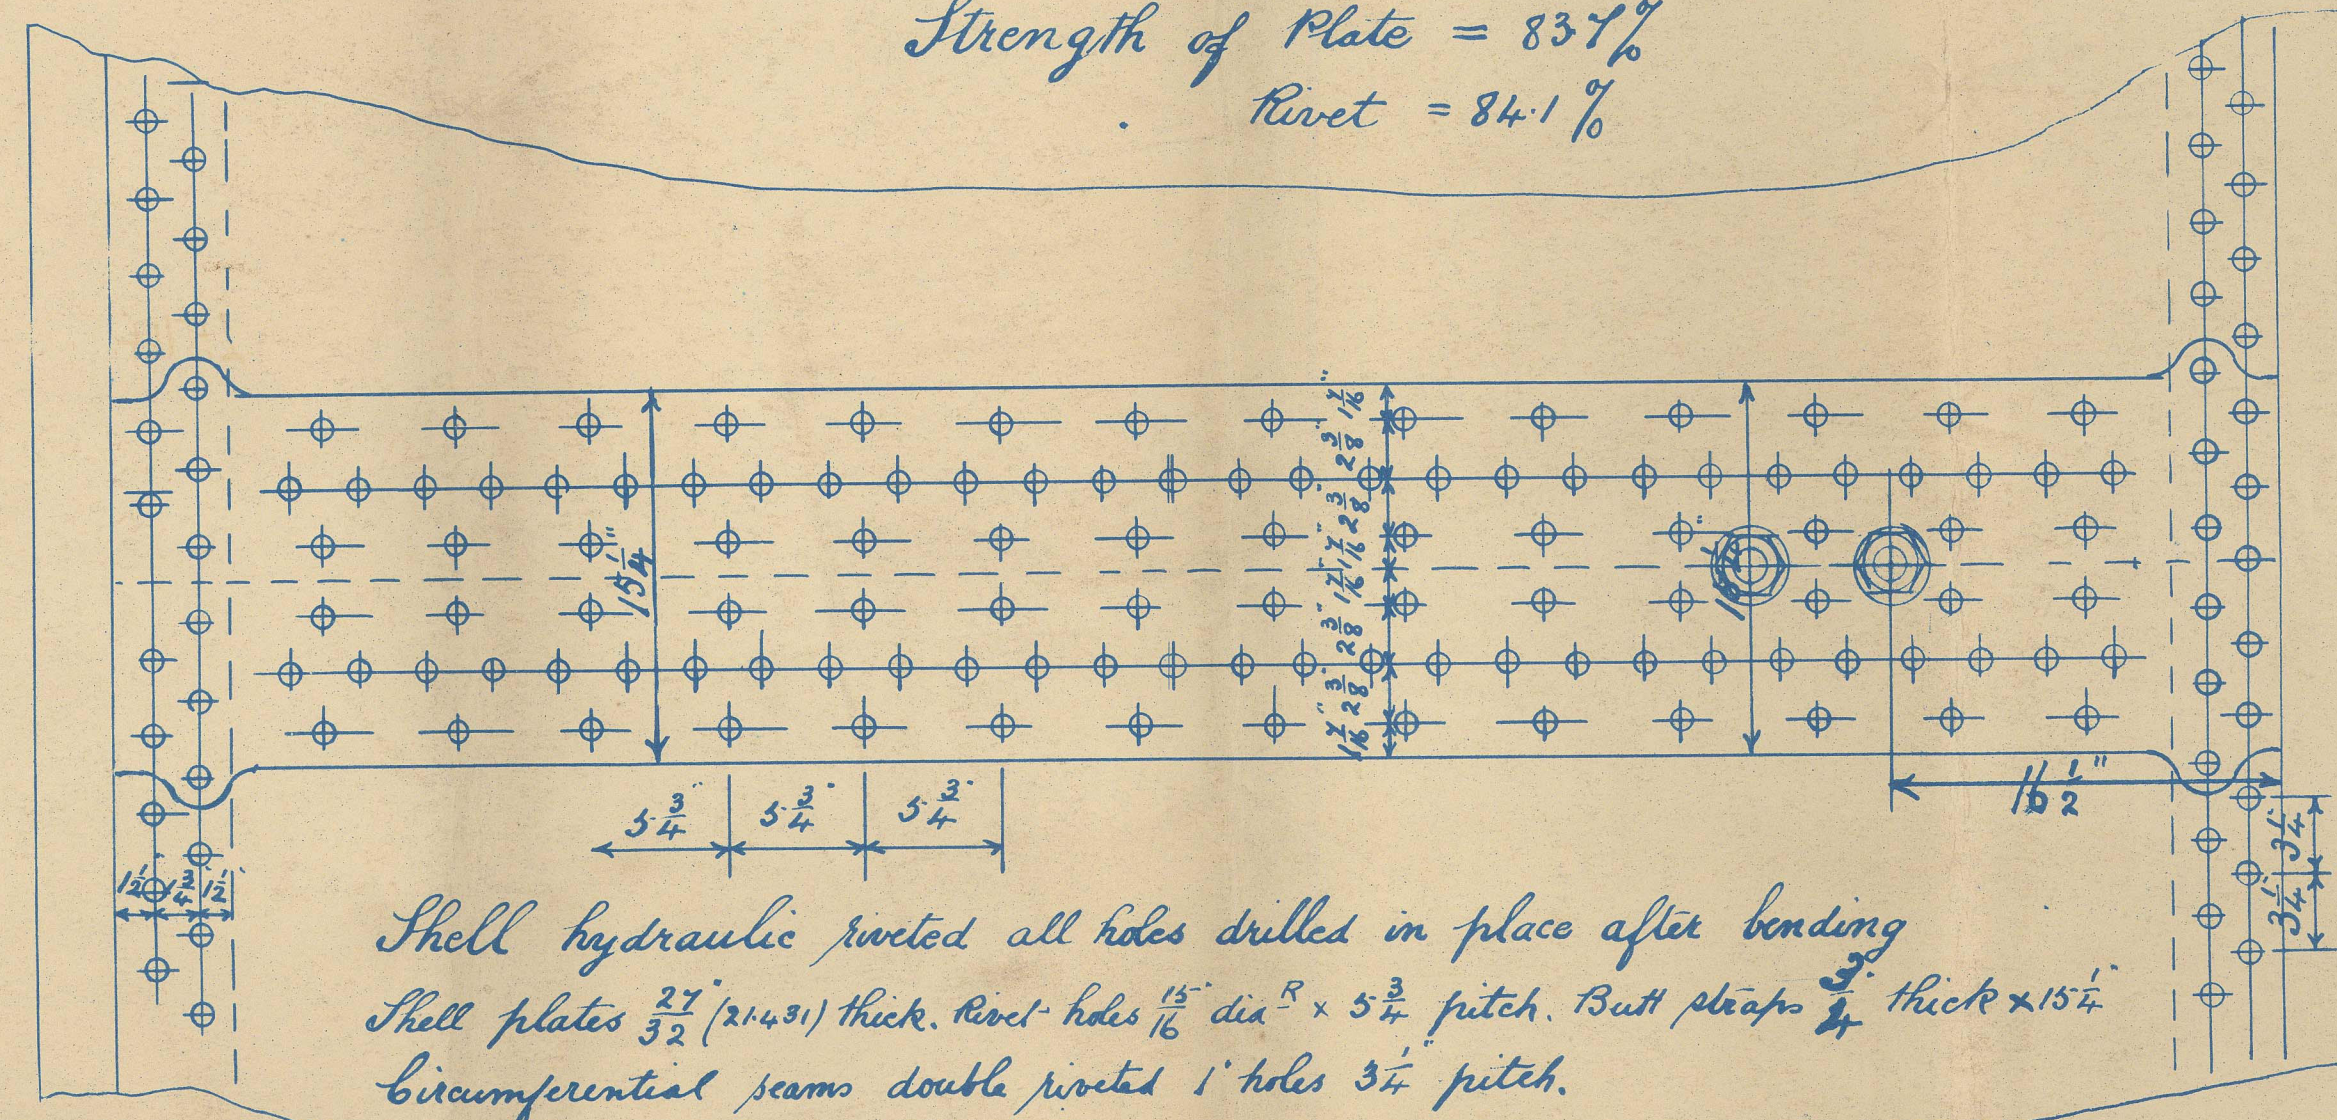

S. S. "Port Elliot"
Robson & Co
Coa No 5
Donkey Boiler
Amended Tracing


N^o 4240

Lloyds Test
320 lbs.

22.1.94. J.E.β

Spec. report

No 29916

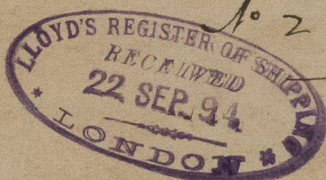

© 2021

Lloyd's Register
Foundation

NW6835-0140