






31.8.93.

2.2
"berth"
upper breast and
lower breast
upper breast
lower breast

Longitudinal Section and Plan Pennoldsons No 156

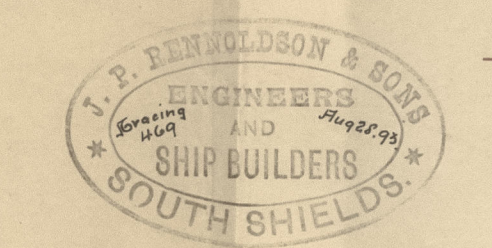


Scale 1/4 one foot.

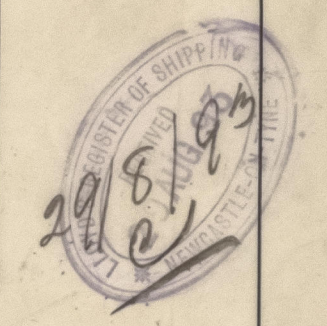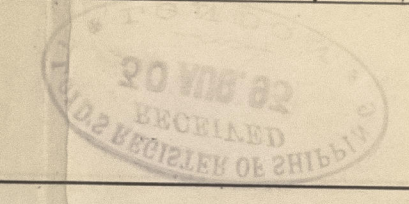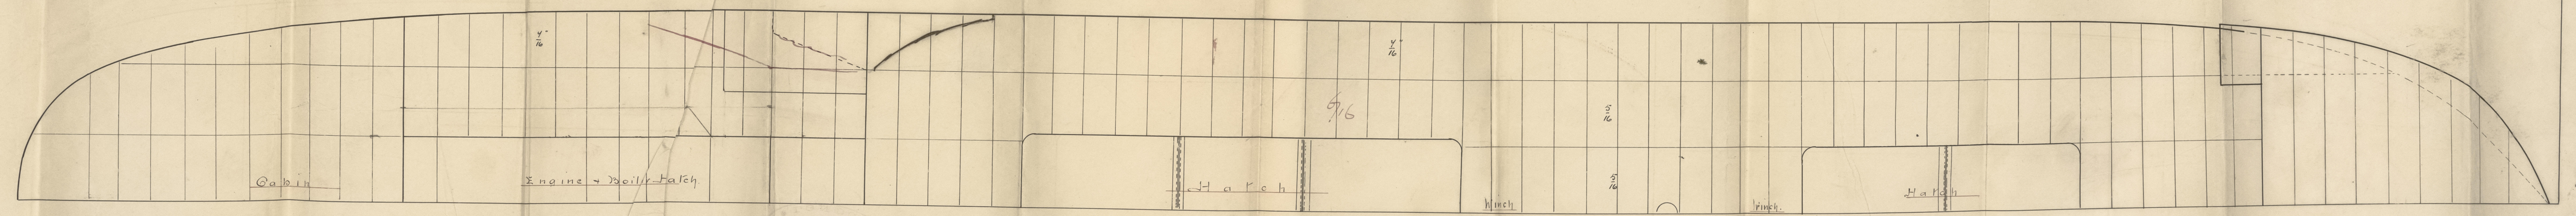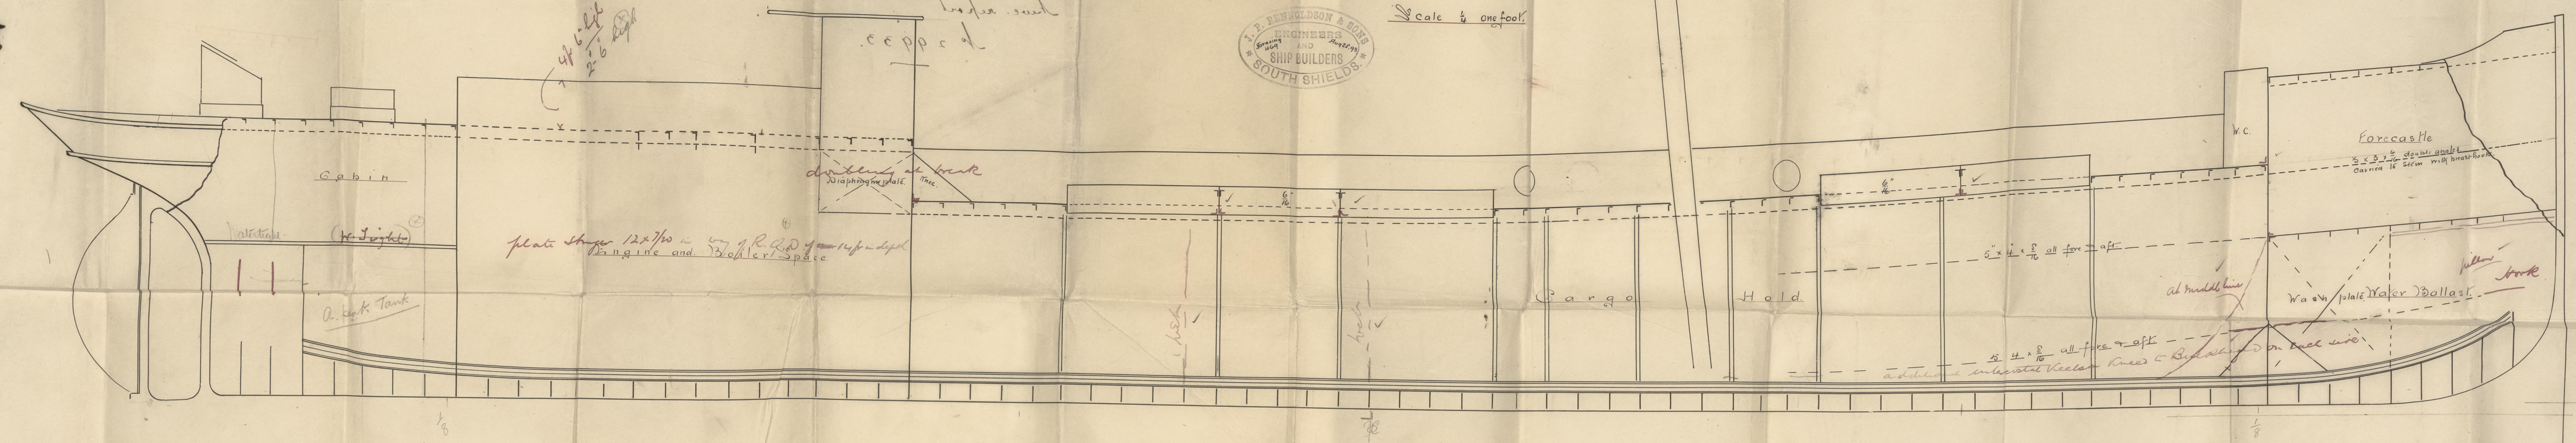

NW 835-0191

S. S.

"Minifred"

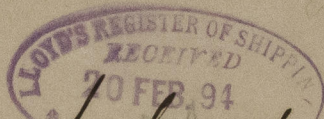

have. freeboard report

No 29830

have. report

No 29933.



© 2021

Lloyd's Register
Foundation