


5.3.94.


77<sup>00</sup> 6194620.

Alternative Arrangement of Steel plate butt straps.


Scale 3" = 1 Foot

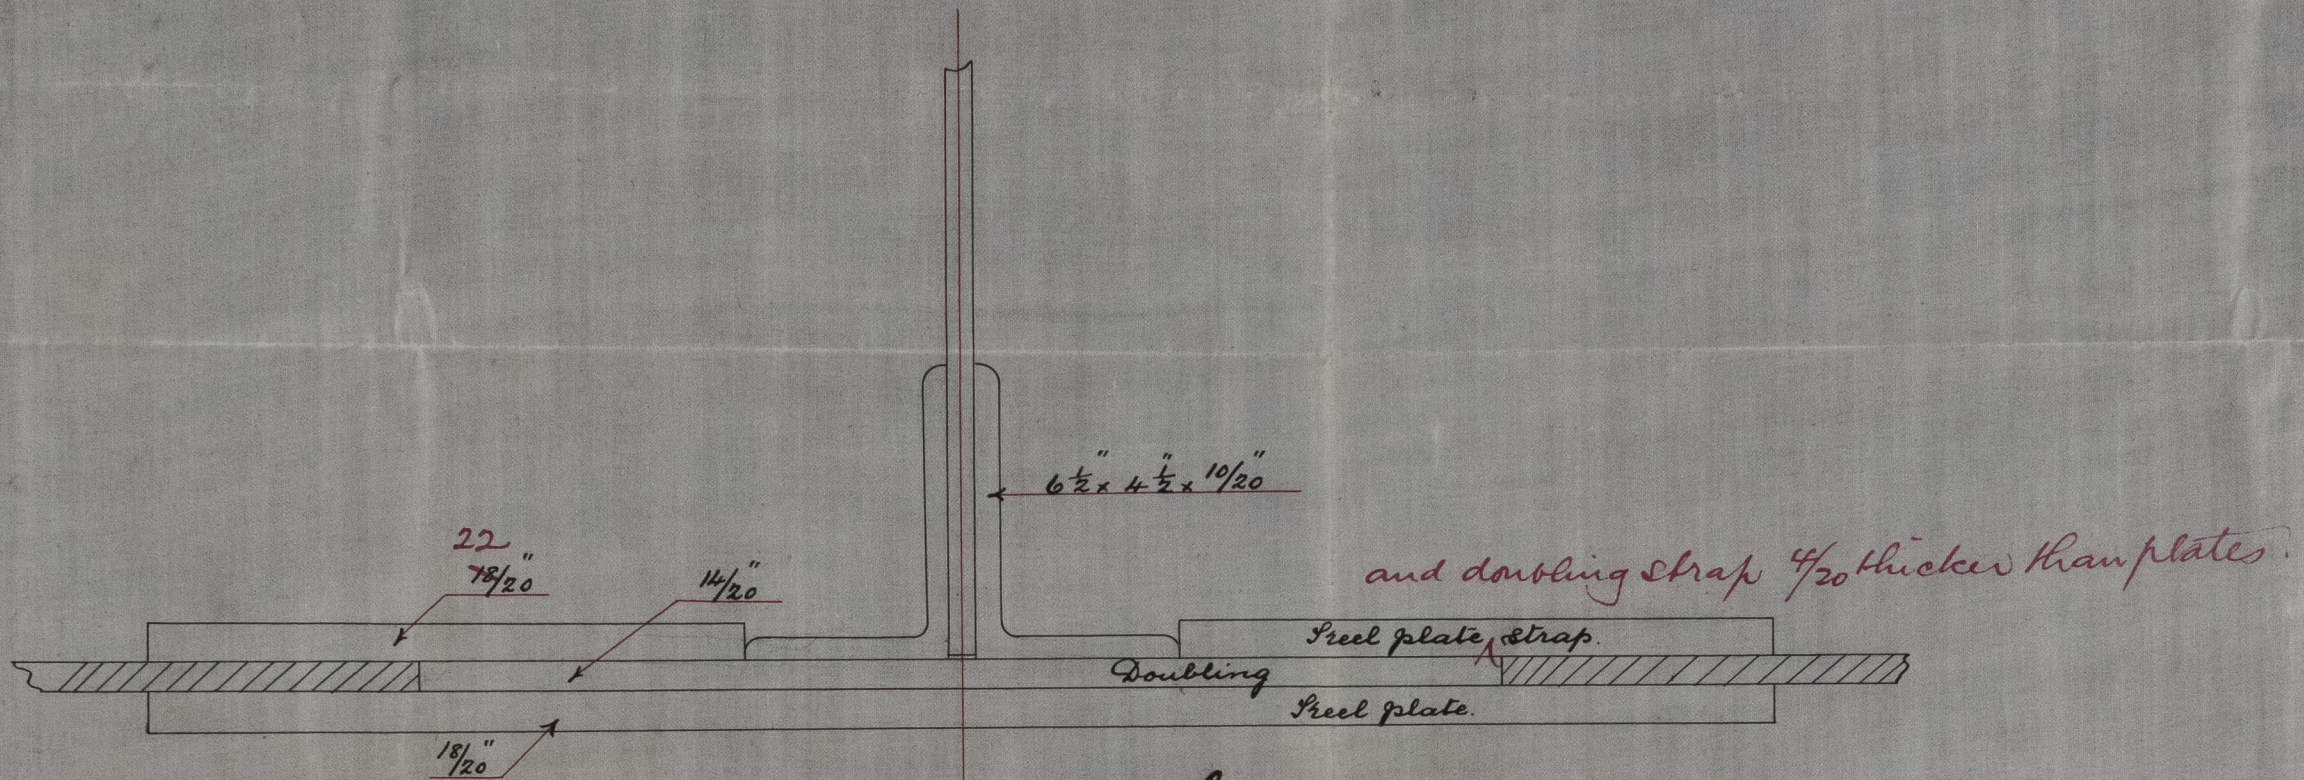

A Sketch. Section thro Steel plate & doubling  
in way of Butt Strap.

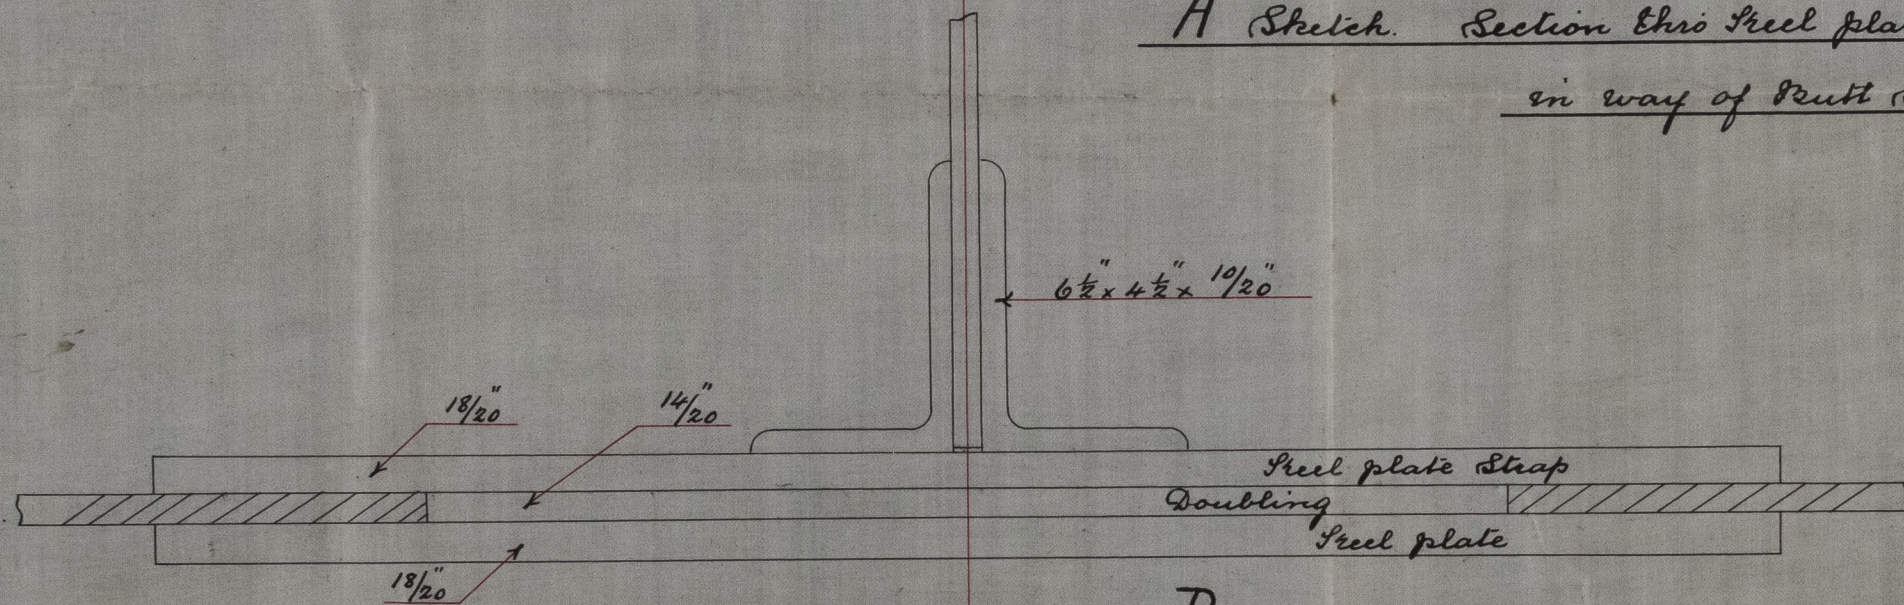

B Sketch. Section thro Steel plate & doubling  
in way of Butt Straps.

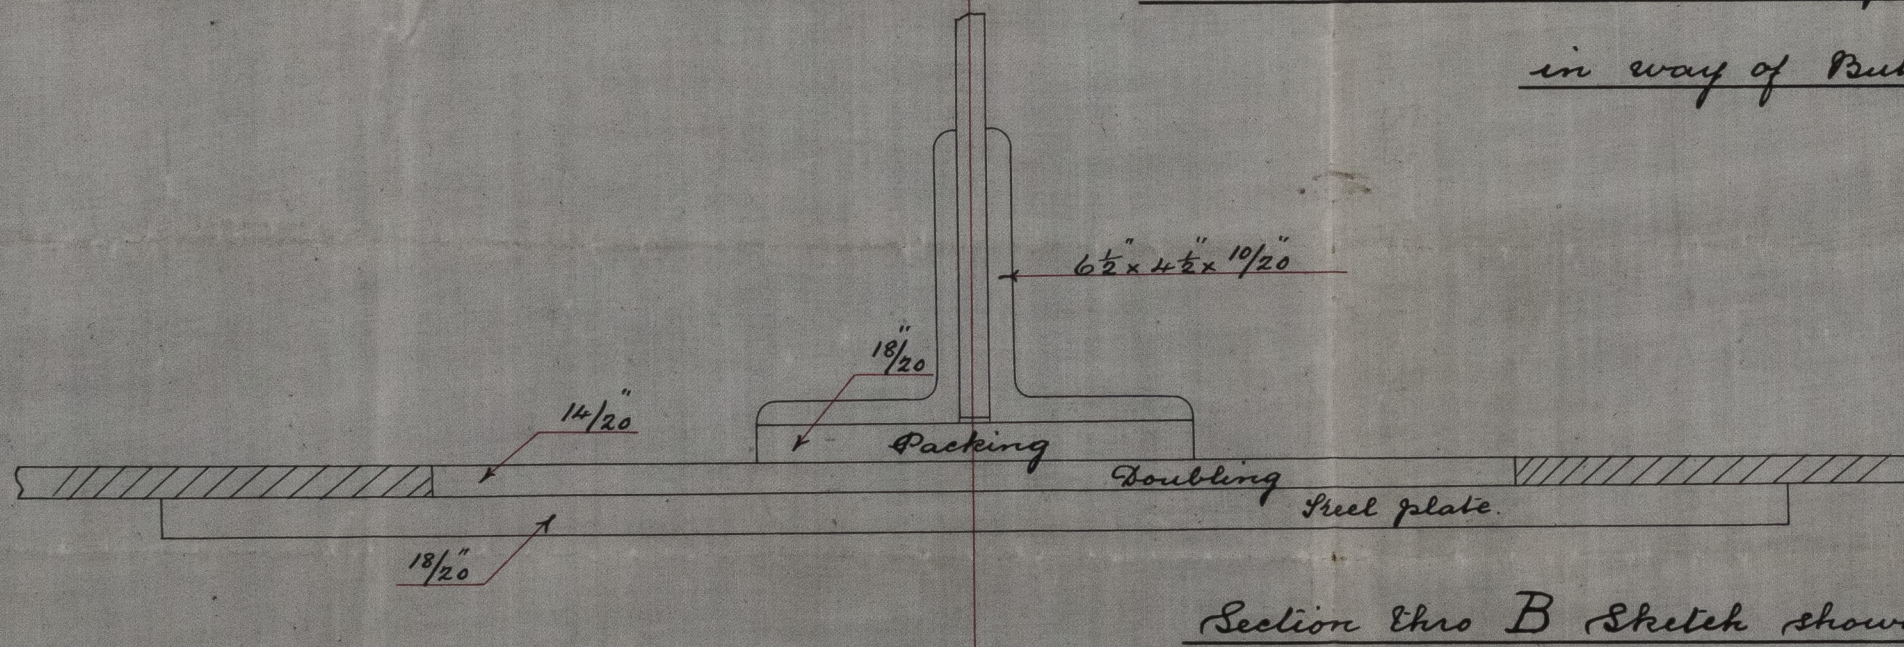

Section thro B Sketch showing packing  
between Butt Straps.

3rd W. G. ARMSTRONG, MITCHELL & CO LIMITED.  
NEWCASTLE-UPON-TYNE  
No 8657 DATE 2.3.94  
WALKER SHIPYARD  
Foundation

3/3.94  
L.S.

NWC839 -0122



Sir W. G. Armstrong  
 Sutcliffe & Co.  
 Reel Bolt Straps  
 619 & 620

"Johannesburg"

Nov. report  
 No 31201

510-982W

12.10.01  
 E

NOV 28 1901  
 DATE 8.3.01  
 NEWCASTLE-ON-TYNE  
 800 W. G. ARMSTRONG'S PATENT CO LIMITED







NWC839 - 0122



© 2021

Lloyd's Register  
 Foundation