

ARMSTRONG & CO. LTD.
NEWCASTLE-UPON-TYNE
ENGLAND


Dr: 6:9:94

10516 d

nos 619-620.

Proposed substitution of Stone's Pump in lieu of Hand Deck Pumps.

Scale 1/8" = 1 Foot.

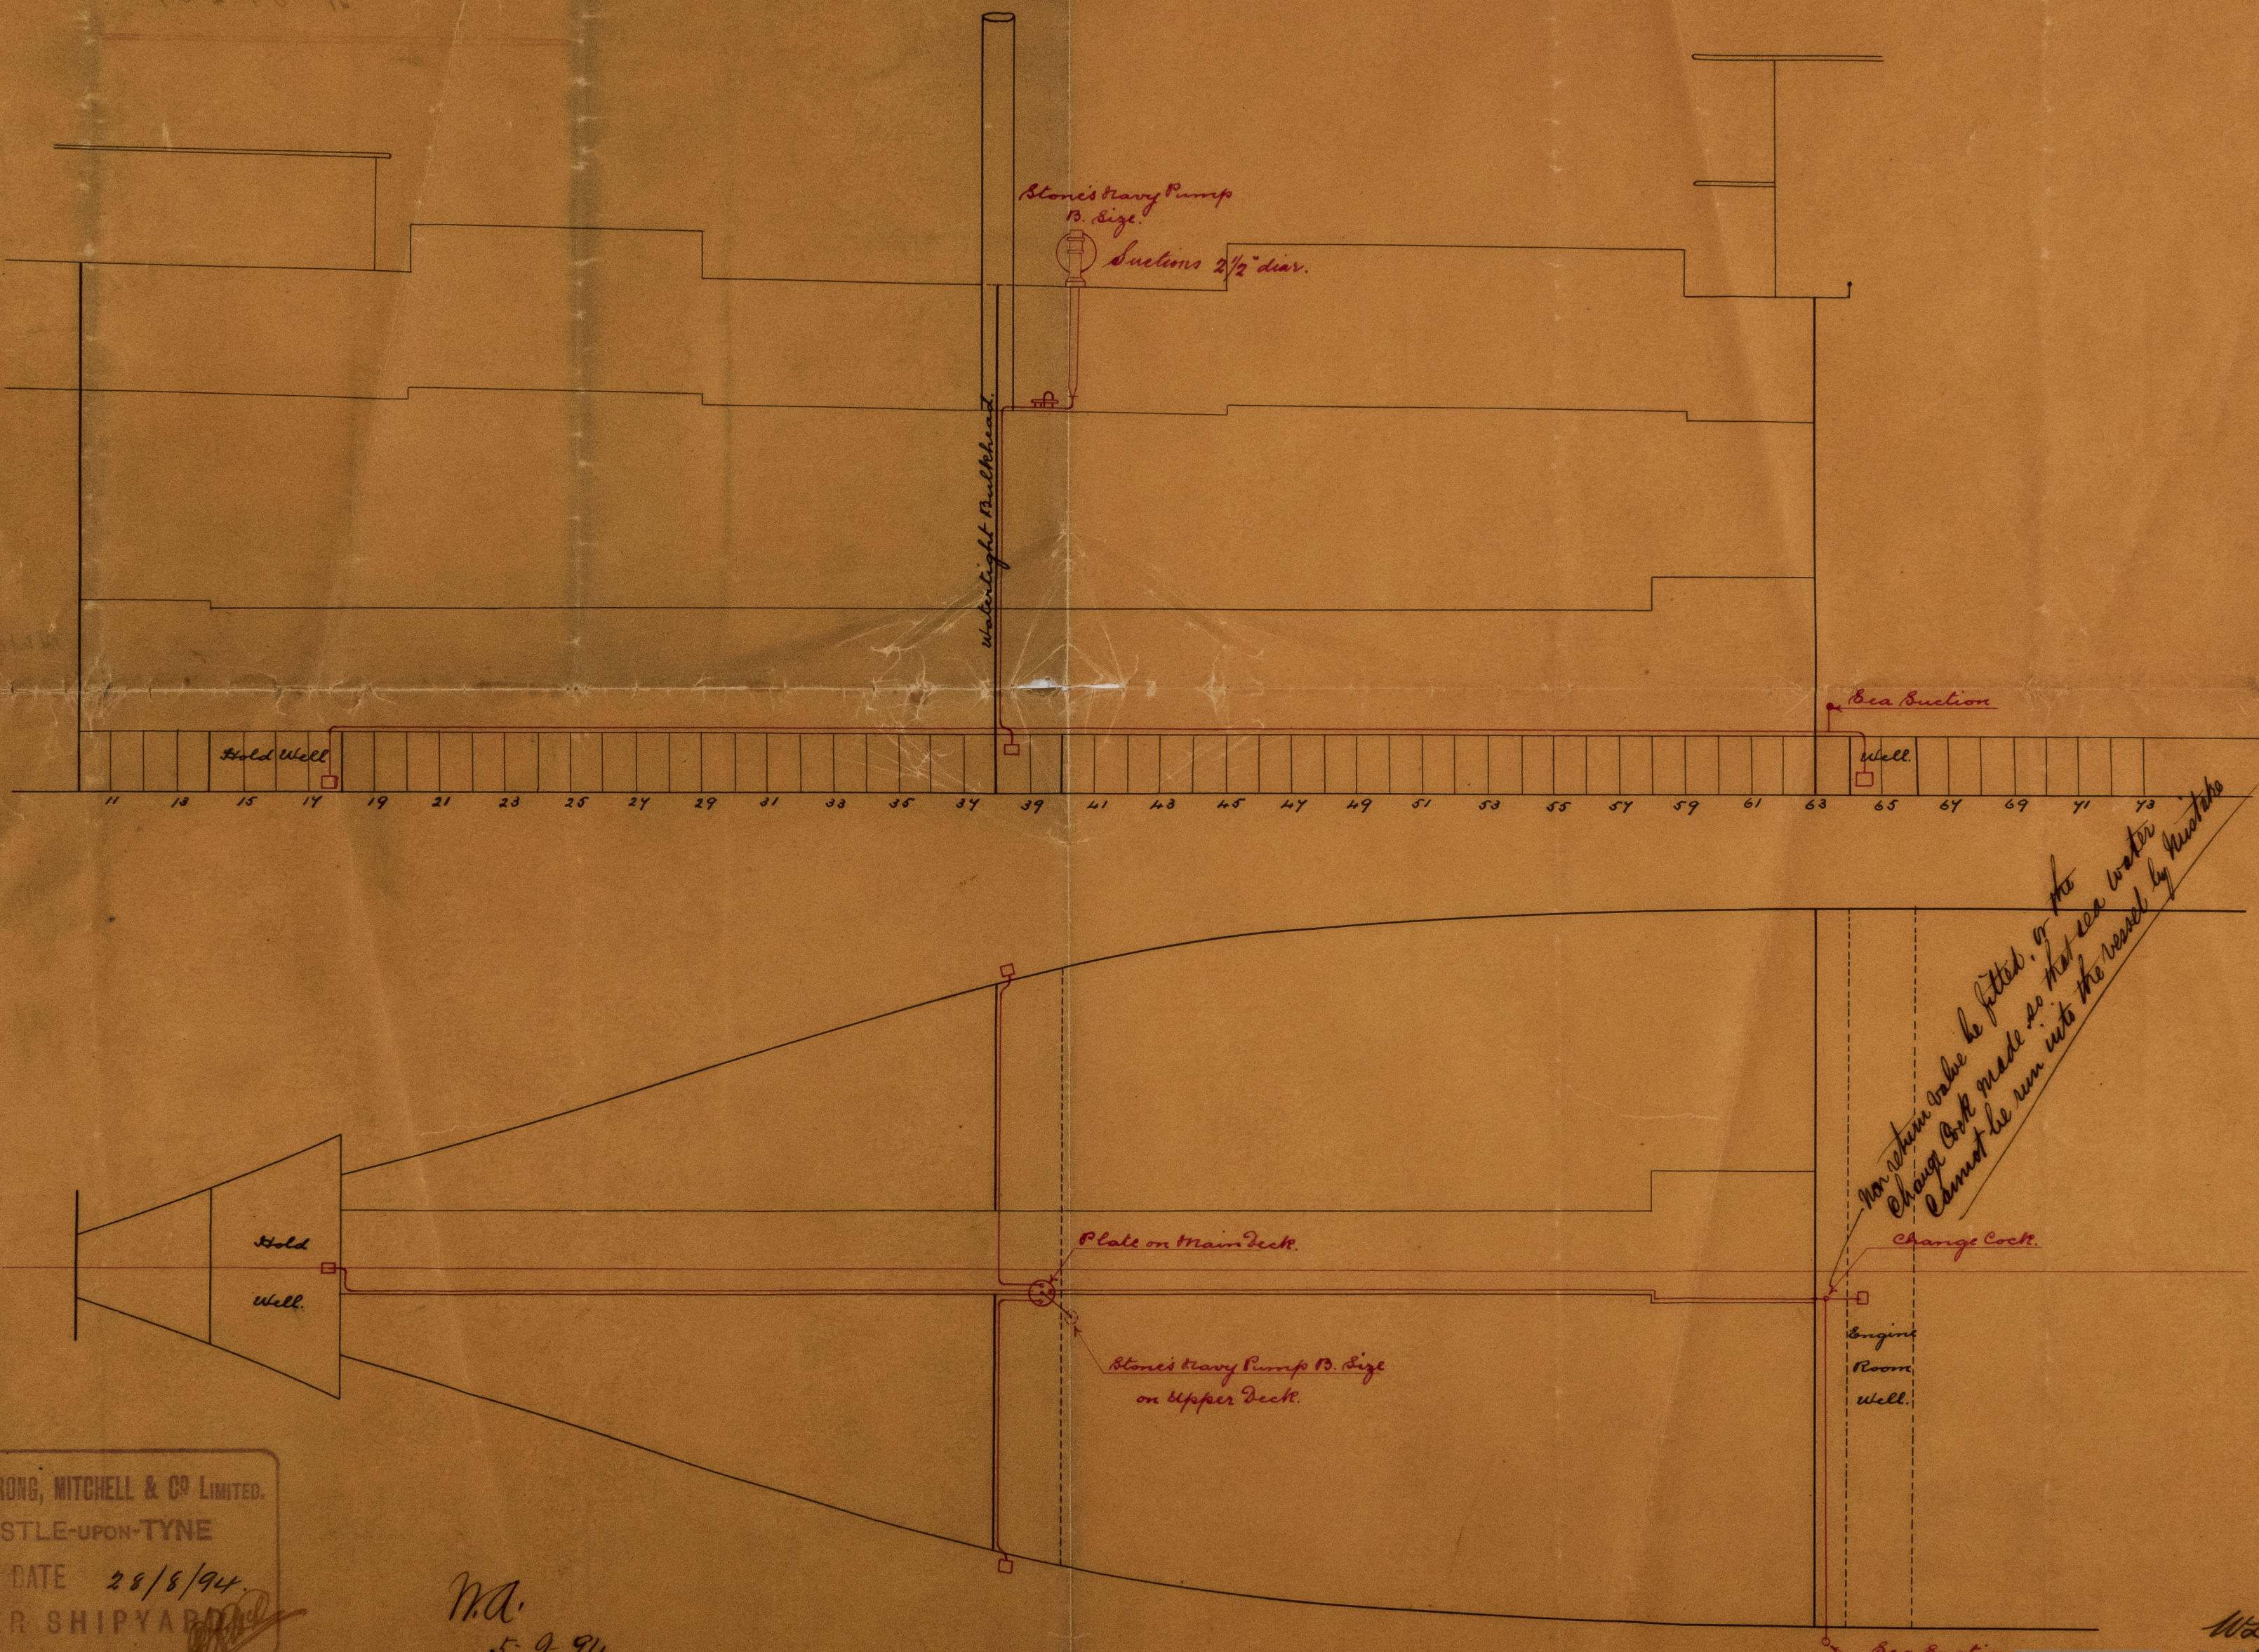

Sir W. G. ARMSTRONG, MITCHELL & CO LIMITED.
NEWCASTLE-UPON-TYNE
NO 9001. DATE 28/8/94.
WALKER SHIPYARD

M.A.
5-9-94

Stone's Pump
arrangements

Sir W. G. Armstrong Mitchell
 & Co 619, 20 & 622

Johannesburg

Spec. report.

Sp 31201

ALLOYD'S REGISTER OF SHIPPING
RECEIVED
5 SEP. 94

NWC 839 - D/23

WALKER SHIPYARD
NO. 2001. DATE 28/8/04
NEWCASTLE-UPON-TYNE
SIR W. G. ARMSTRONG, MITCHELL & CO LIMITED.

Lloyd's Register
Foundation