


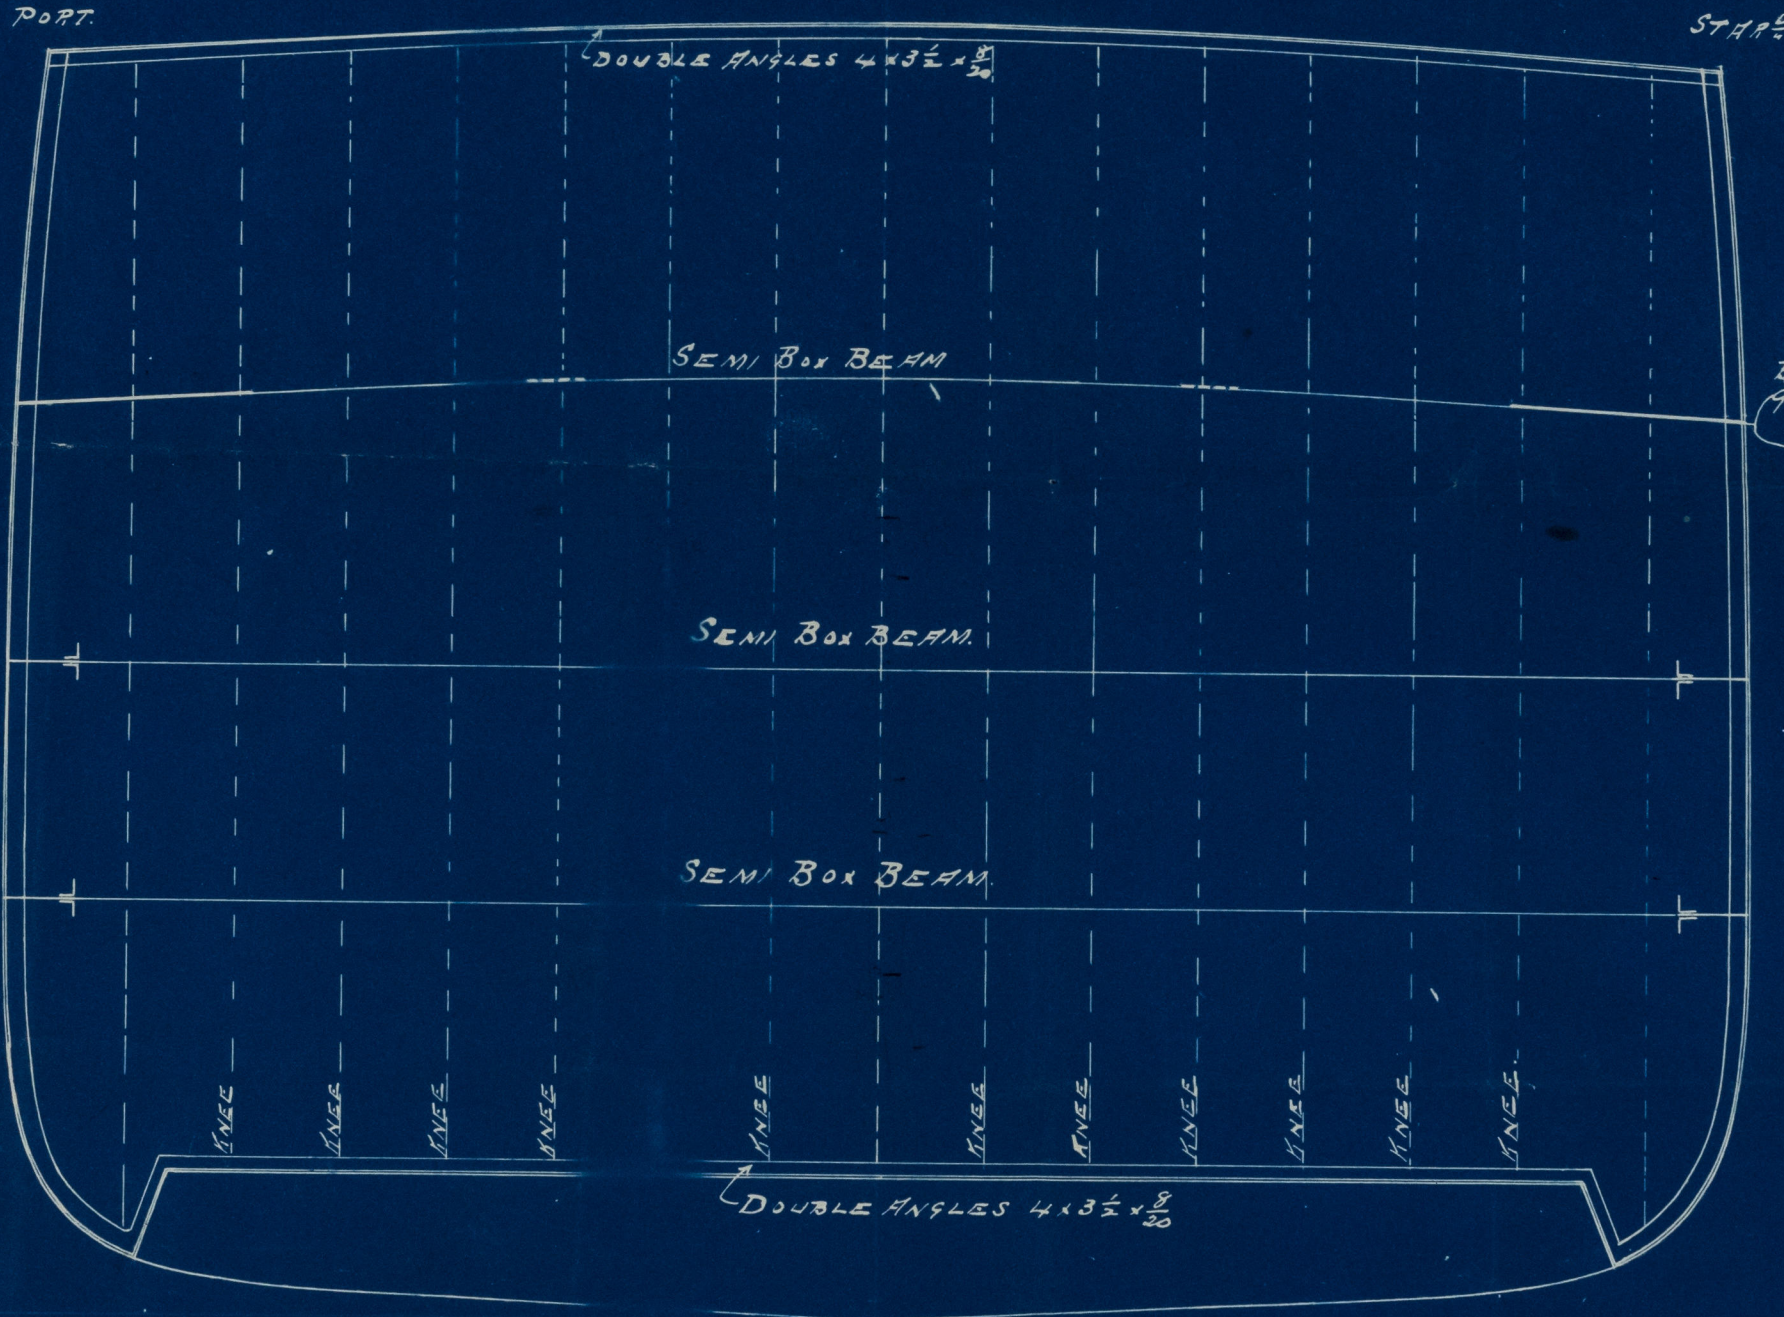


6. 4. 94

SKETCH OF BULKHEAD STIFFENING S.S. 196.

SCALE $\frac{1}{4}$ INCH = 1 FOOT.



steel plate mast, no yards.
only 7th hatched by rail -

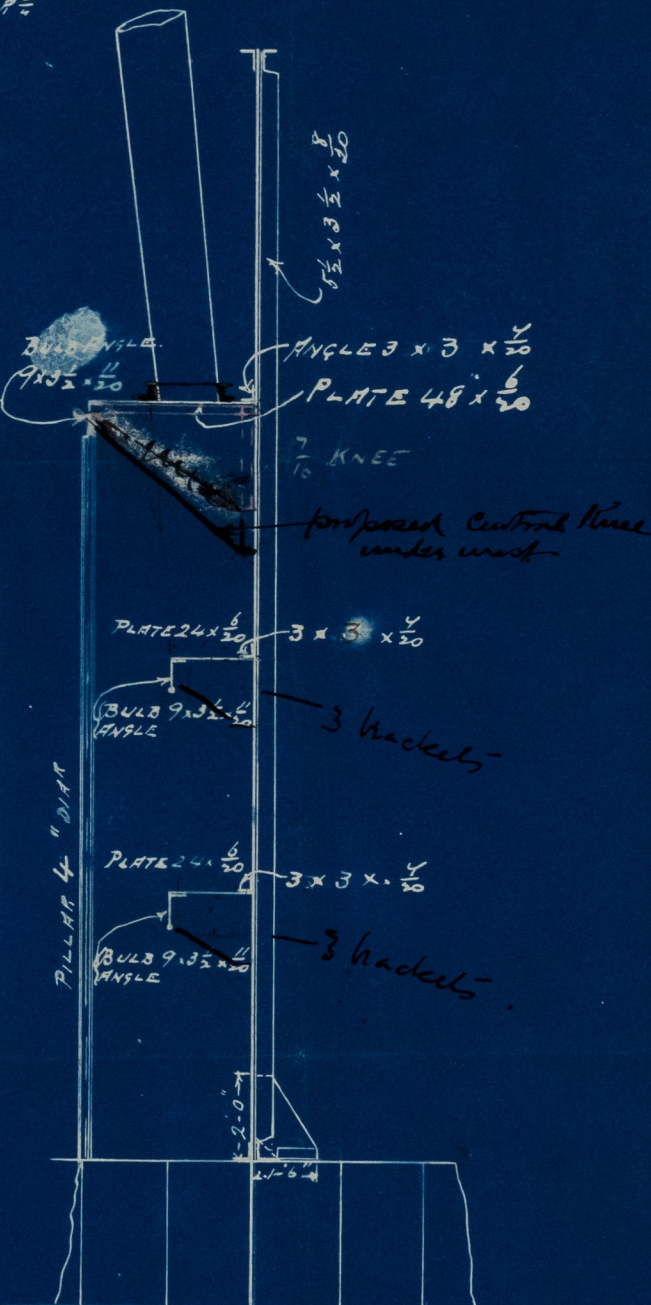

No. 113.


VERTICAL STIFFENERS $5\frac{1}{2} \times 3\frac{1}{2} \times \frac{8}{20}$ SPACED 30" APART.

J.P.L.
5/4/94



© 2021
Lloyd's Register
Foundation

NVIC840-0081

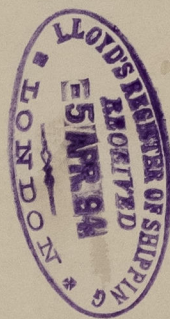

"Dowgate"

have. report

N^o 31254.

NWC 840-0081



© 2021

Lloyd's Register
Foundation