




LLOYD'S REGISTER OF SHIPPING

5. 4. 94
13. 4. 94

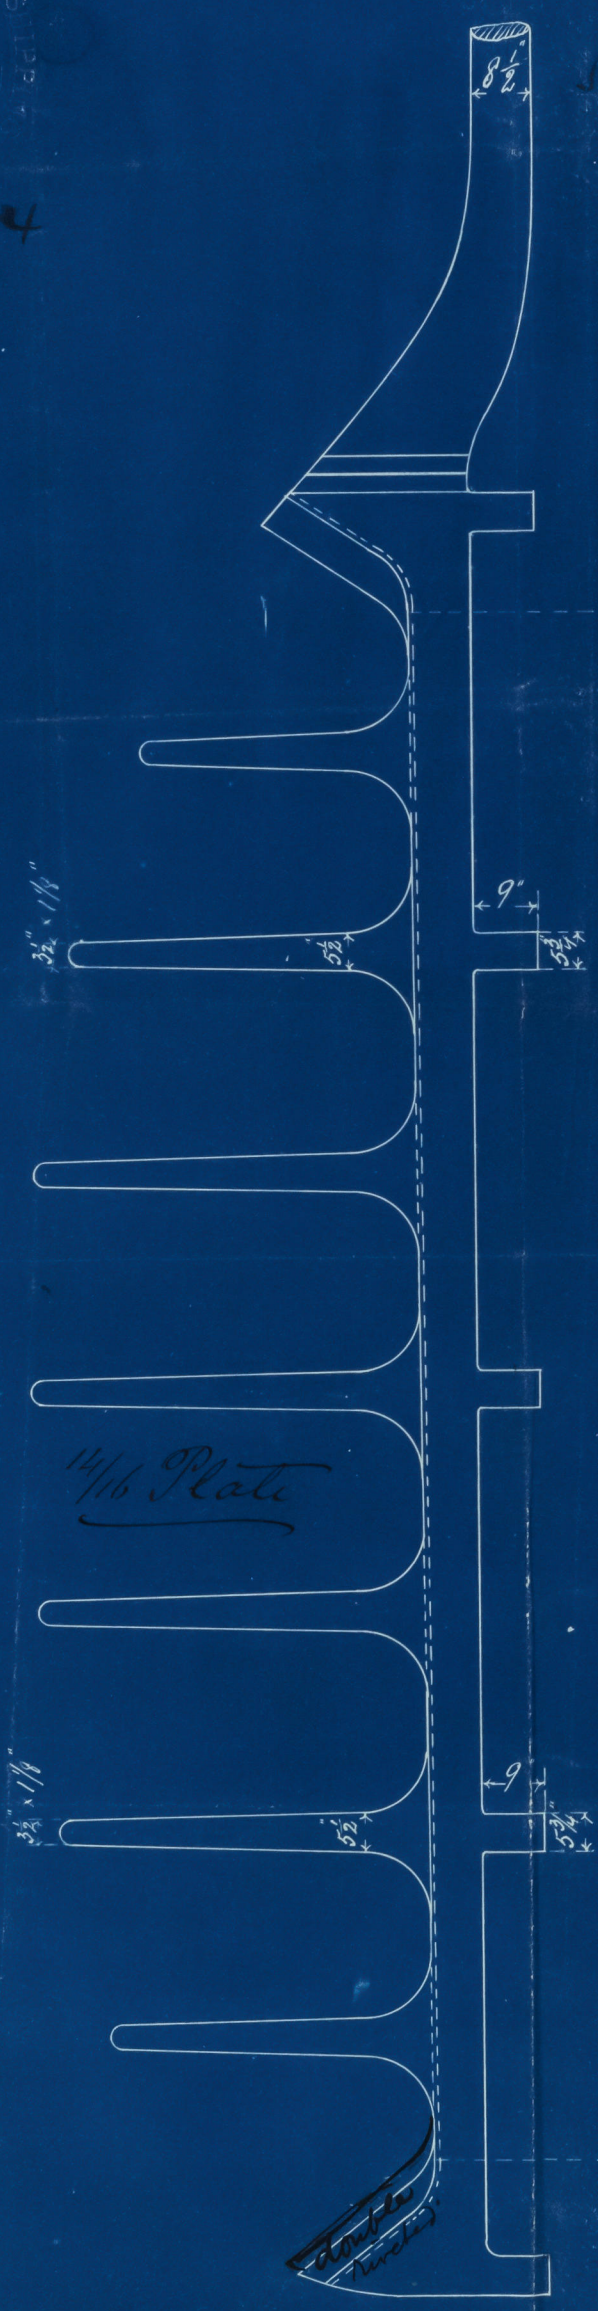


N^{OS} 196-198.

SCALE 1/2" = 1 FOOT.

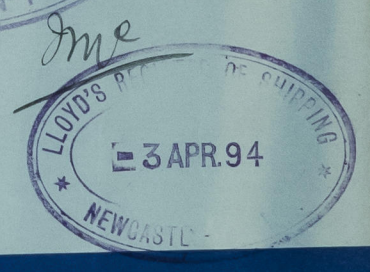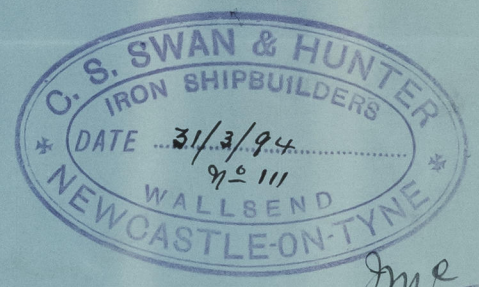

See letter 13/4/94

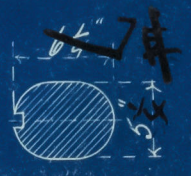


J.H.B.
4/4/94



Lloyd's Register Foundation

NWC 840-0082

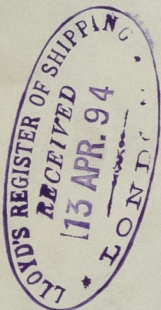

Flores
Sumatra

sp.
"Dowgate"

Shew. 1st Entry report
No 31254

NWC840-0082



© 2021

Lloyd's Register
Foundation