
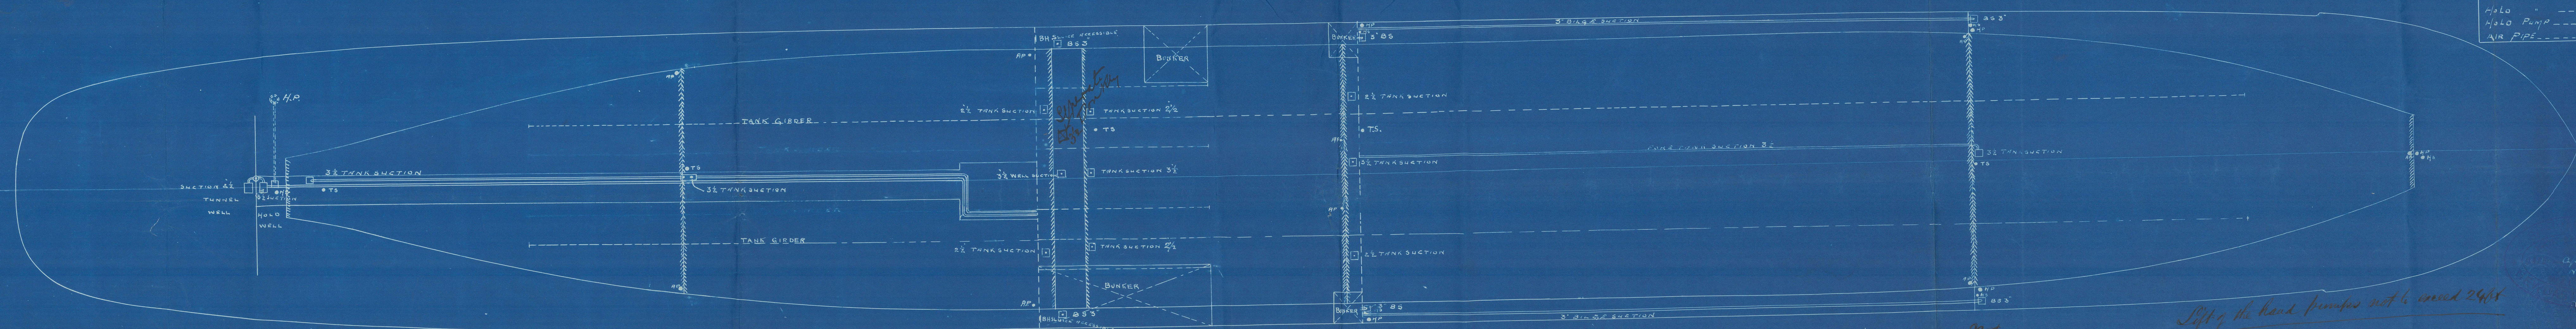


Oct. 15. 94

— PUMPING ARRANGEMENT —
— S.S. N° 196 —

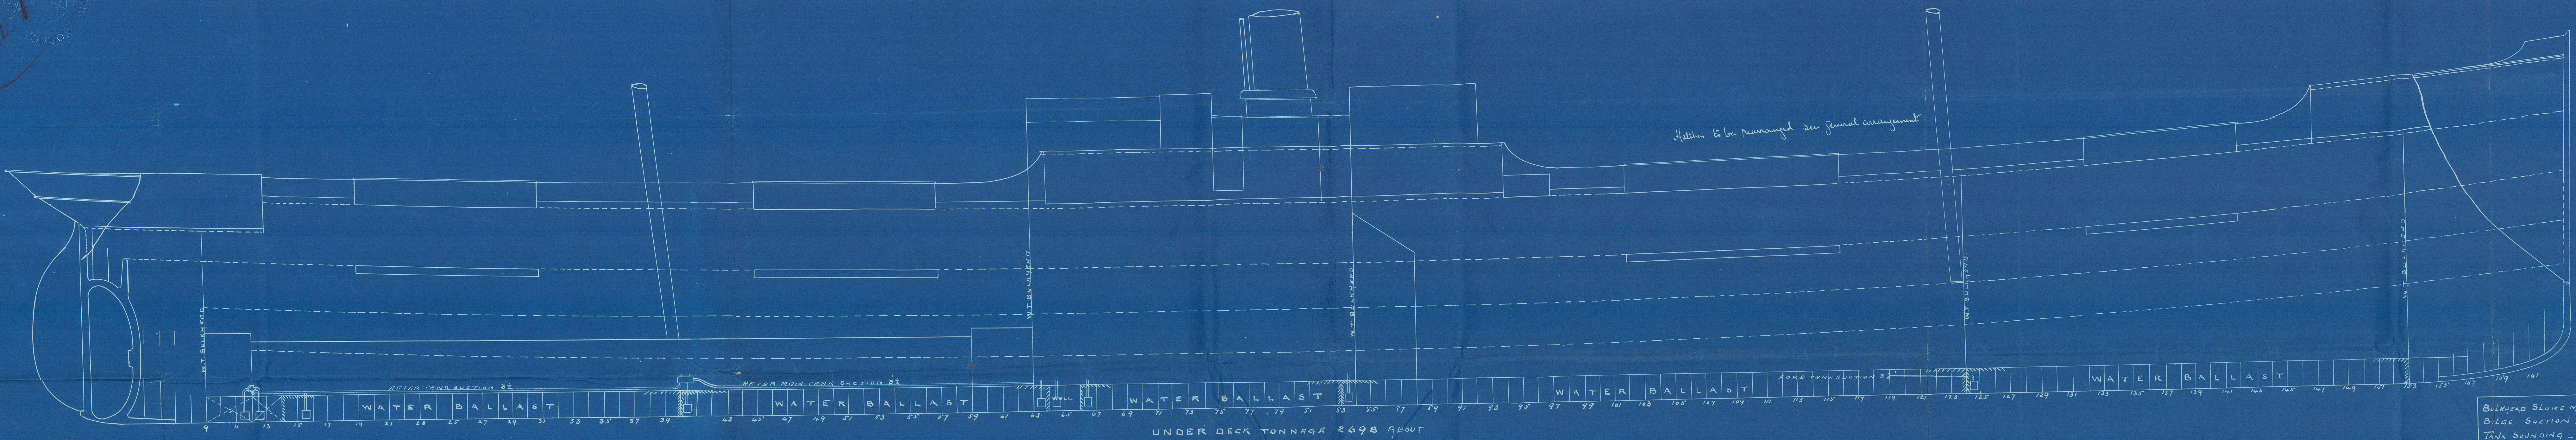

BULKHEAD SLUICE MARK Q... B.H.S.
BILGE SUCTON... B.S.
TANK SOUNDING... T.S.
HOLD " " " " H.S.
HOLD PUMP... H.P.
AIR PIPE... A.P.

nd.
15-94

Left of the head pumps not to exceed 24ft


NWC840-0083

196 Lloyd's Pumping Plan

^{2/3}
"Dowgate"

Shwe. 1st Embury report

No 31254.

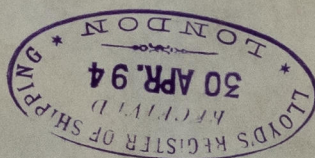

NWC840-0083



© 2021

Lloyd's Register
Foundation