


Screening "Warrior"

2. 8. 94

Scale  $\frac{3}{4}$  = one foot.

Material from

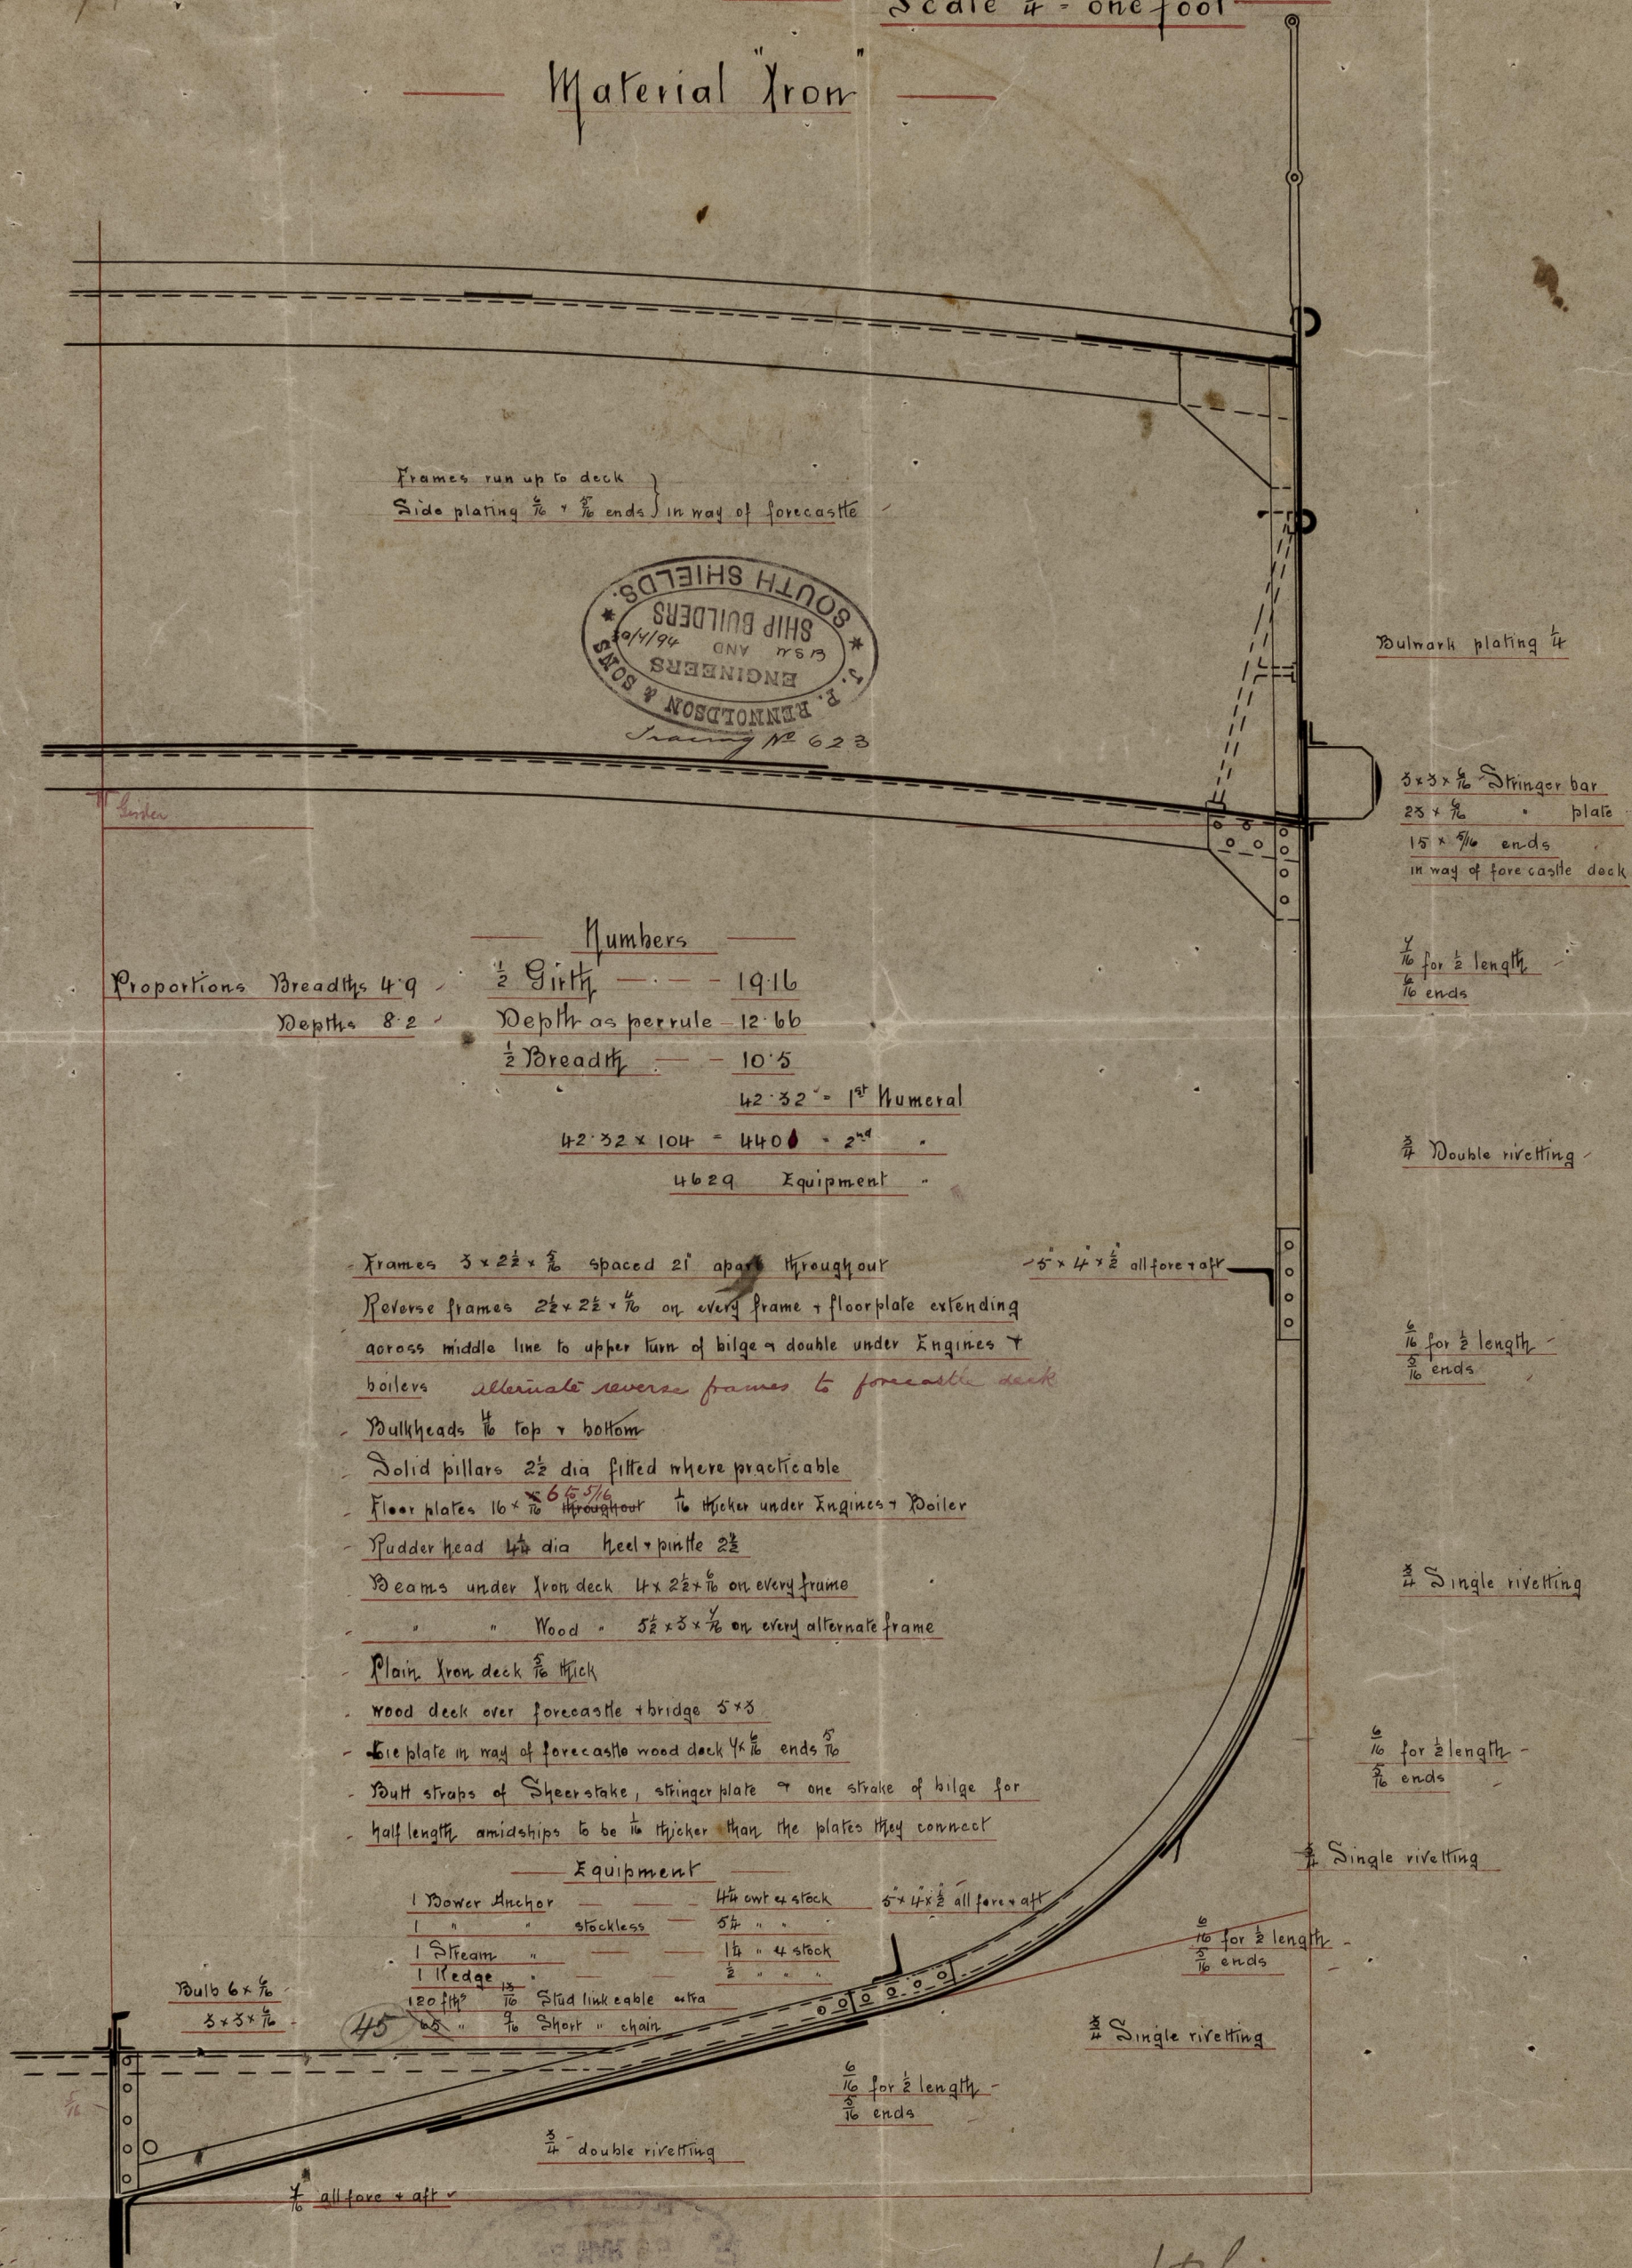

Keel  $6\frac{3}{4} \times 1\frac{1}{4}$  -  
Stem  $6 \times 1\frac{1}{4}$  -  
 Sternframe  $6 \times 2\frac{1}{2}$  -

1-8-94


© 2021  
Lloyd's Register  
Foundation

NWC840-0163



*S.S. Warrior*  
*hwc. 31432.*

Registered  
 21st Feb 1894  
 11st Feb 1894

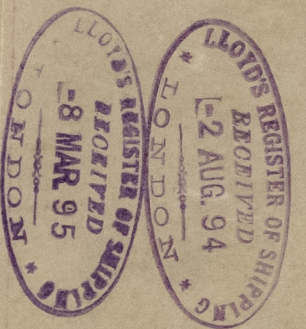

NWC840-0163

MS. 25 x 10H - RHO 0 - S.A.  
 MS. 25 - L.A. N.W. 10.9

