



2.8.94

Longitudinal Section

Screw Bug N° 163

Class 100 A1 for Bug purposes

Scale  $\frac{1}{4}$  - one foot

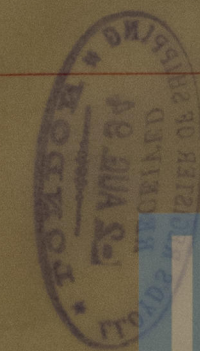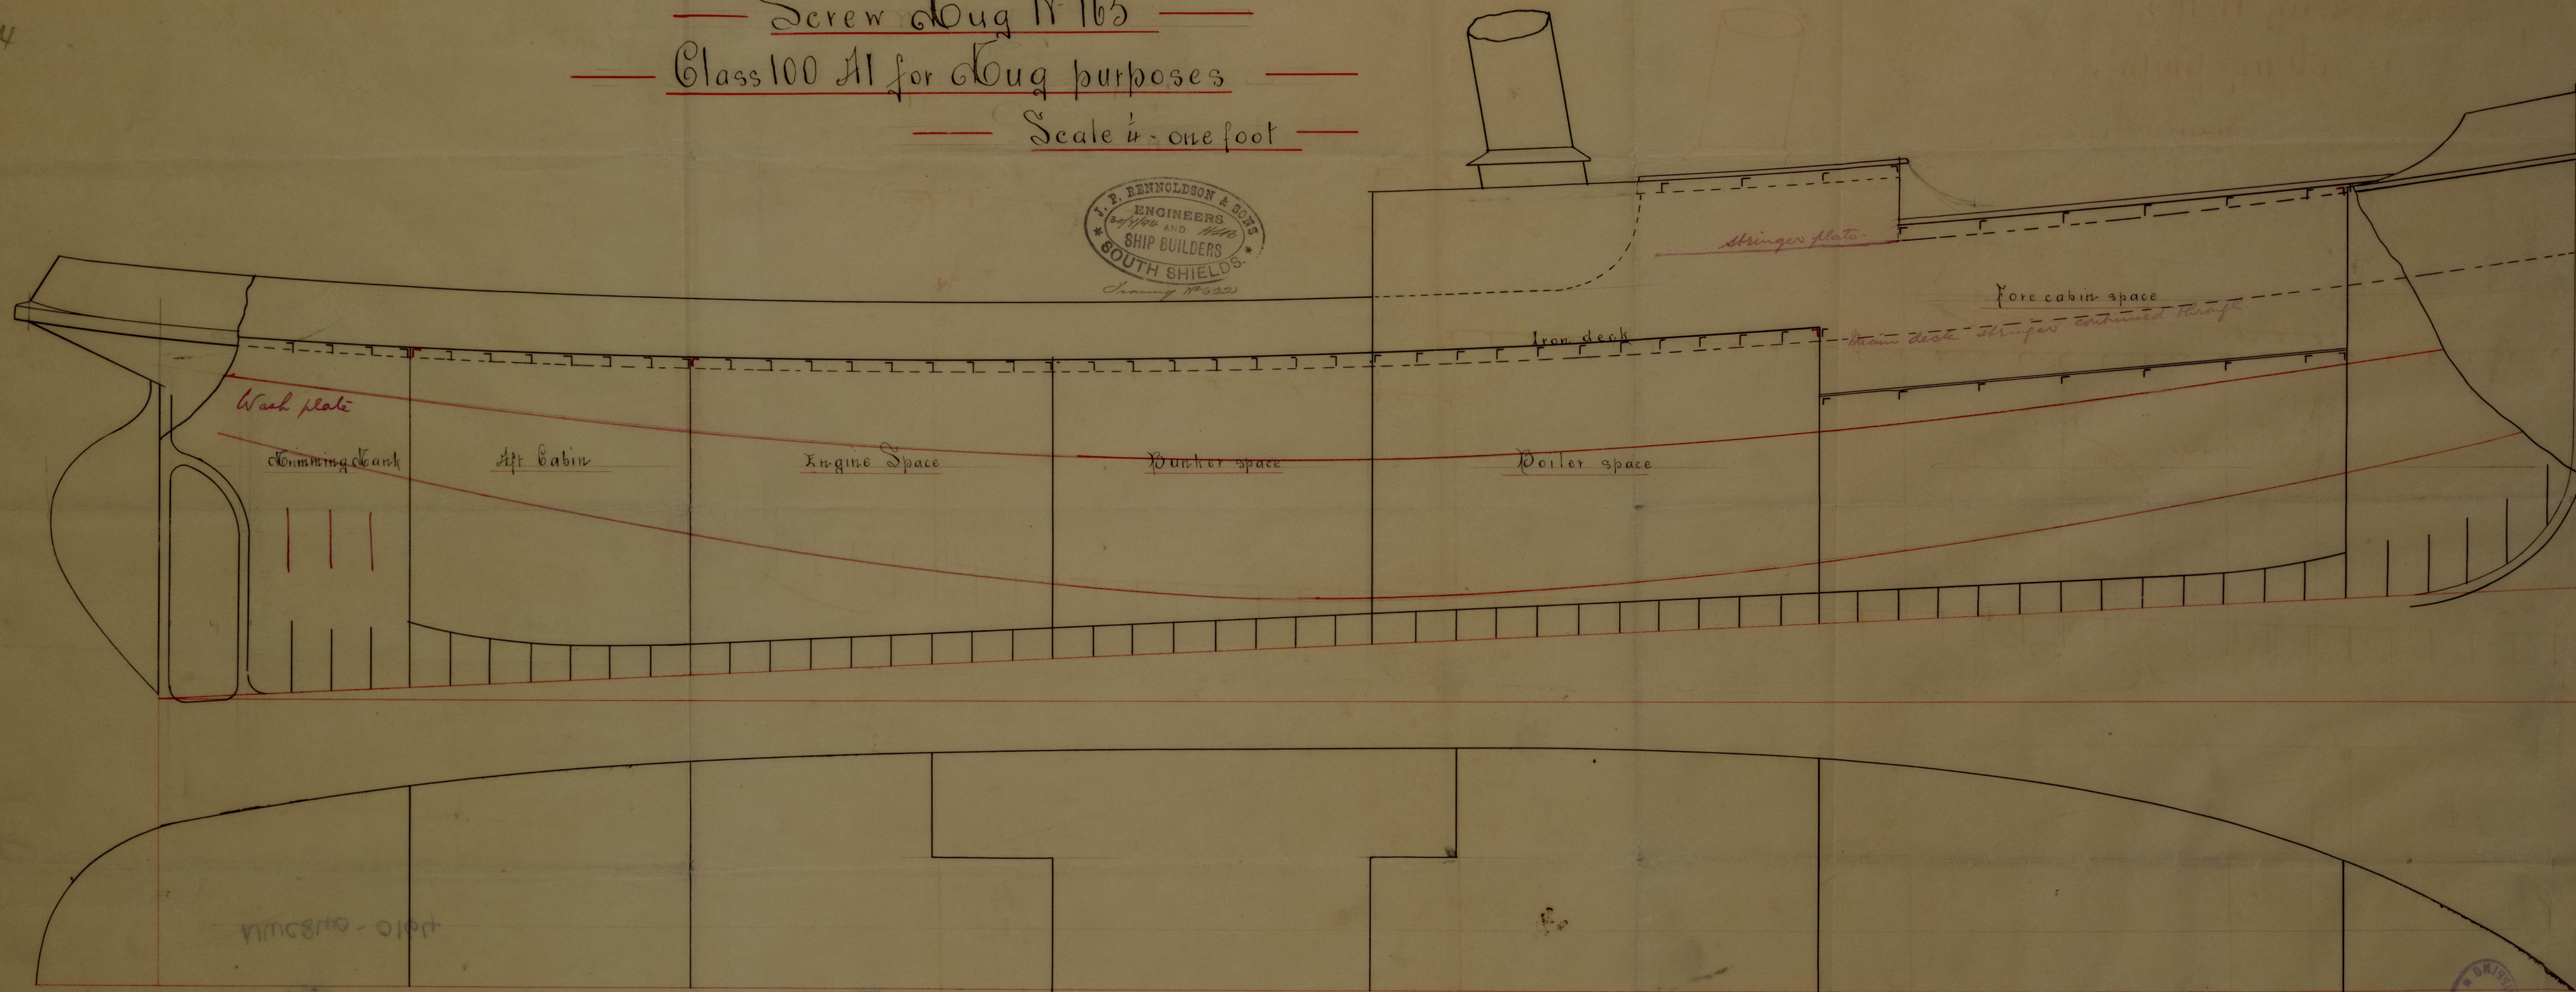

1-8.94  
e



© 2021  
Lloyd's Register  
Foundation


15/1  
2/8/94

NWC840-0164



S.S. "Warrior"  
Linc 31432.

NWC840-0164

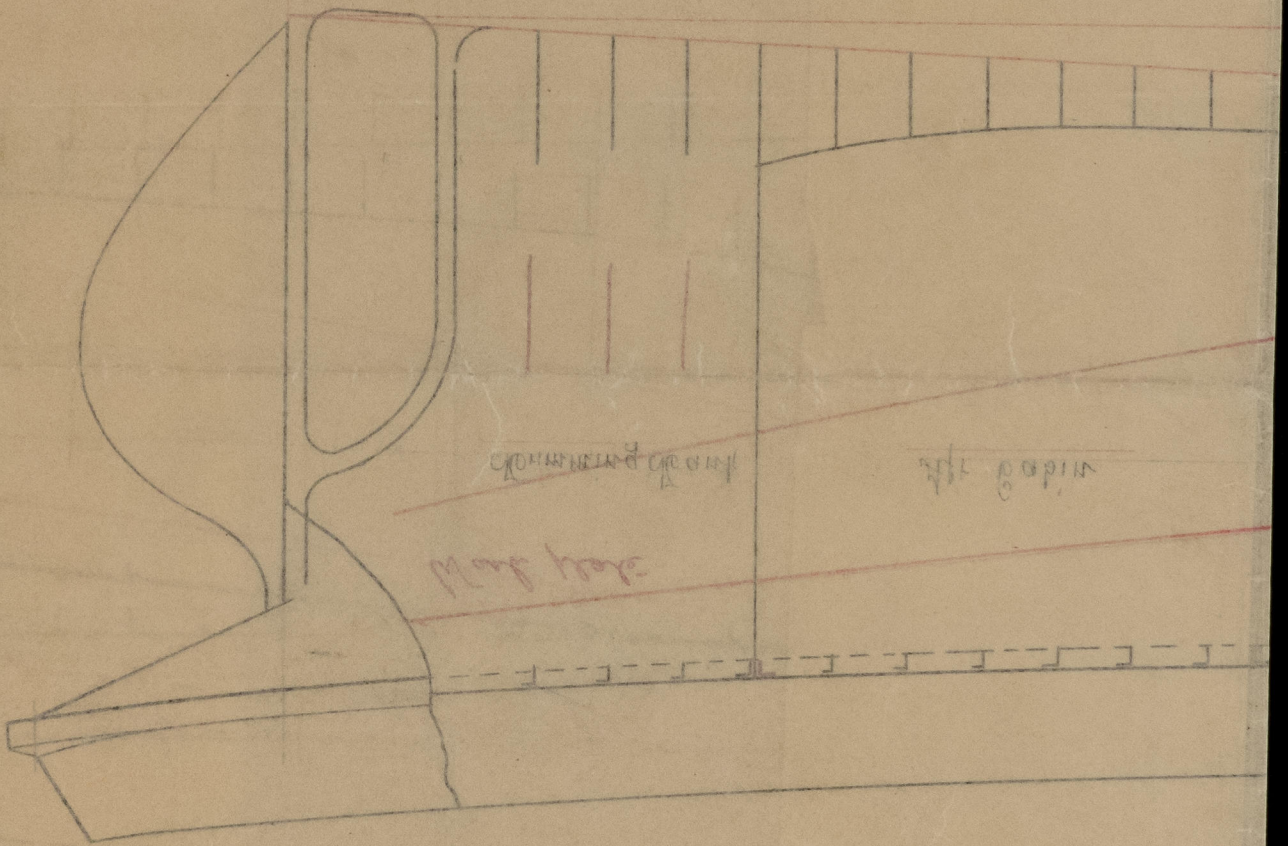

8-10  
LLOYD'S REGISTER  
MARITIME



© 2021

Lloyd's Register  
Foundation



1600  
8-1

LLOYD'S REGISTER OF SHIPPING  
RECEIVED  
2 AUG. 94  
LONDON

WINDING UP

18/8/94  
J.P.

Chimney blank

Ward plate

Section  
Fig No 113  
Deck  
Deck  
Deck



© 2021

Lloyd's Register  
Foundation