
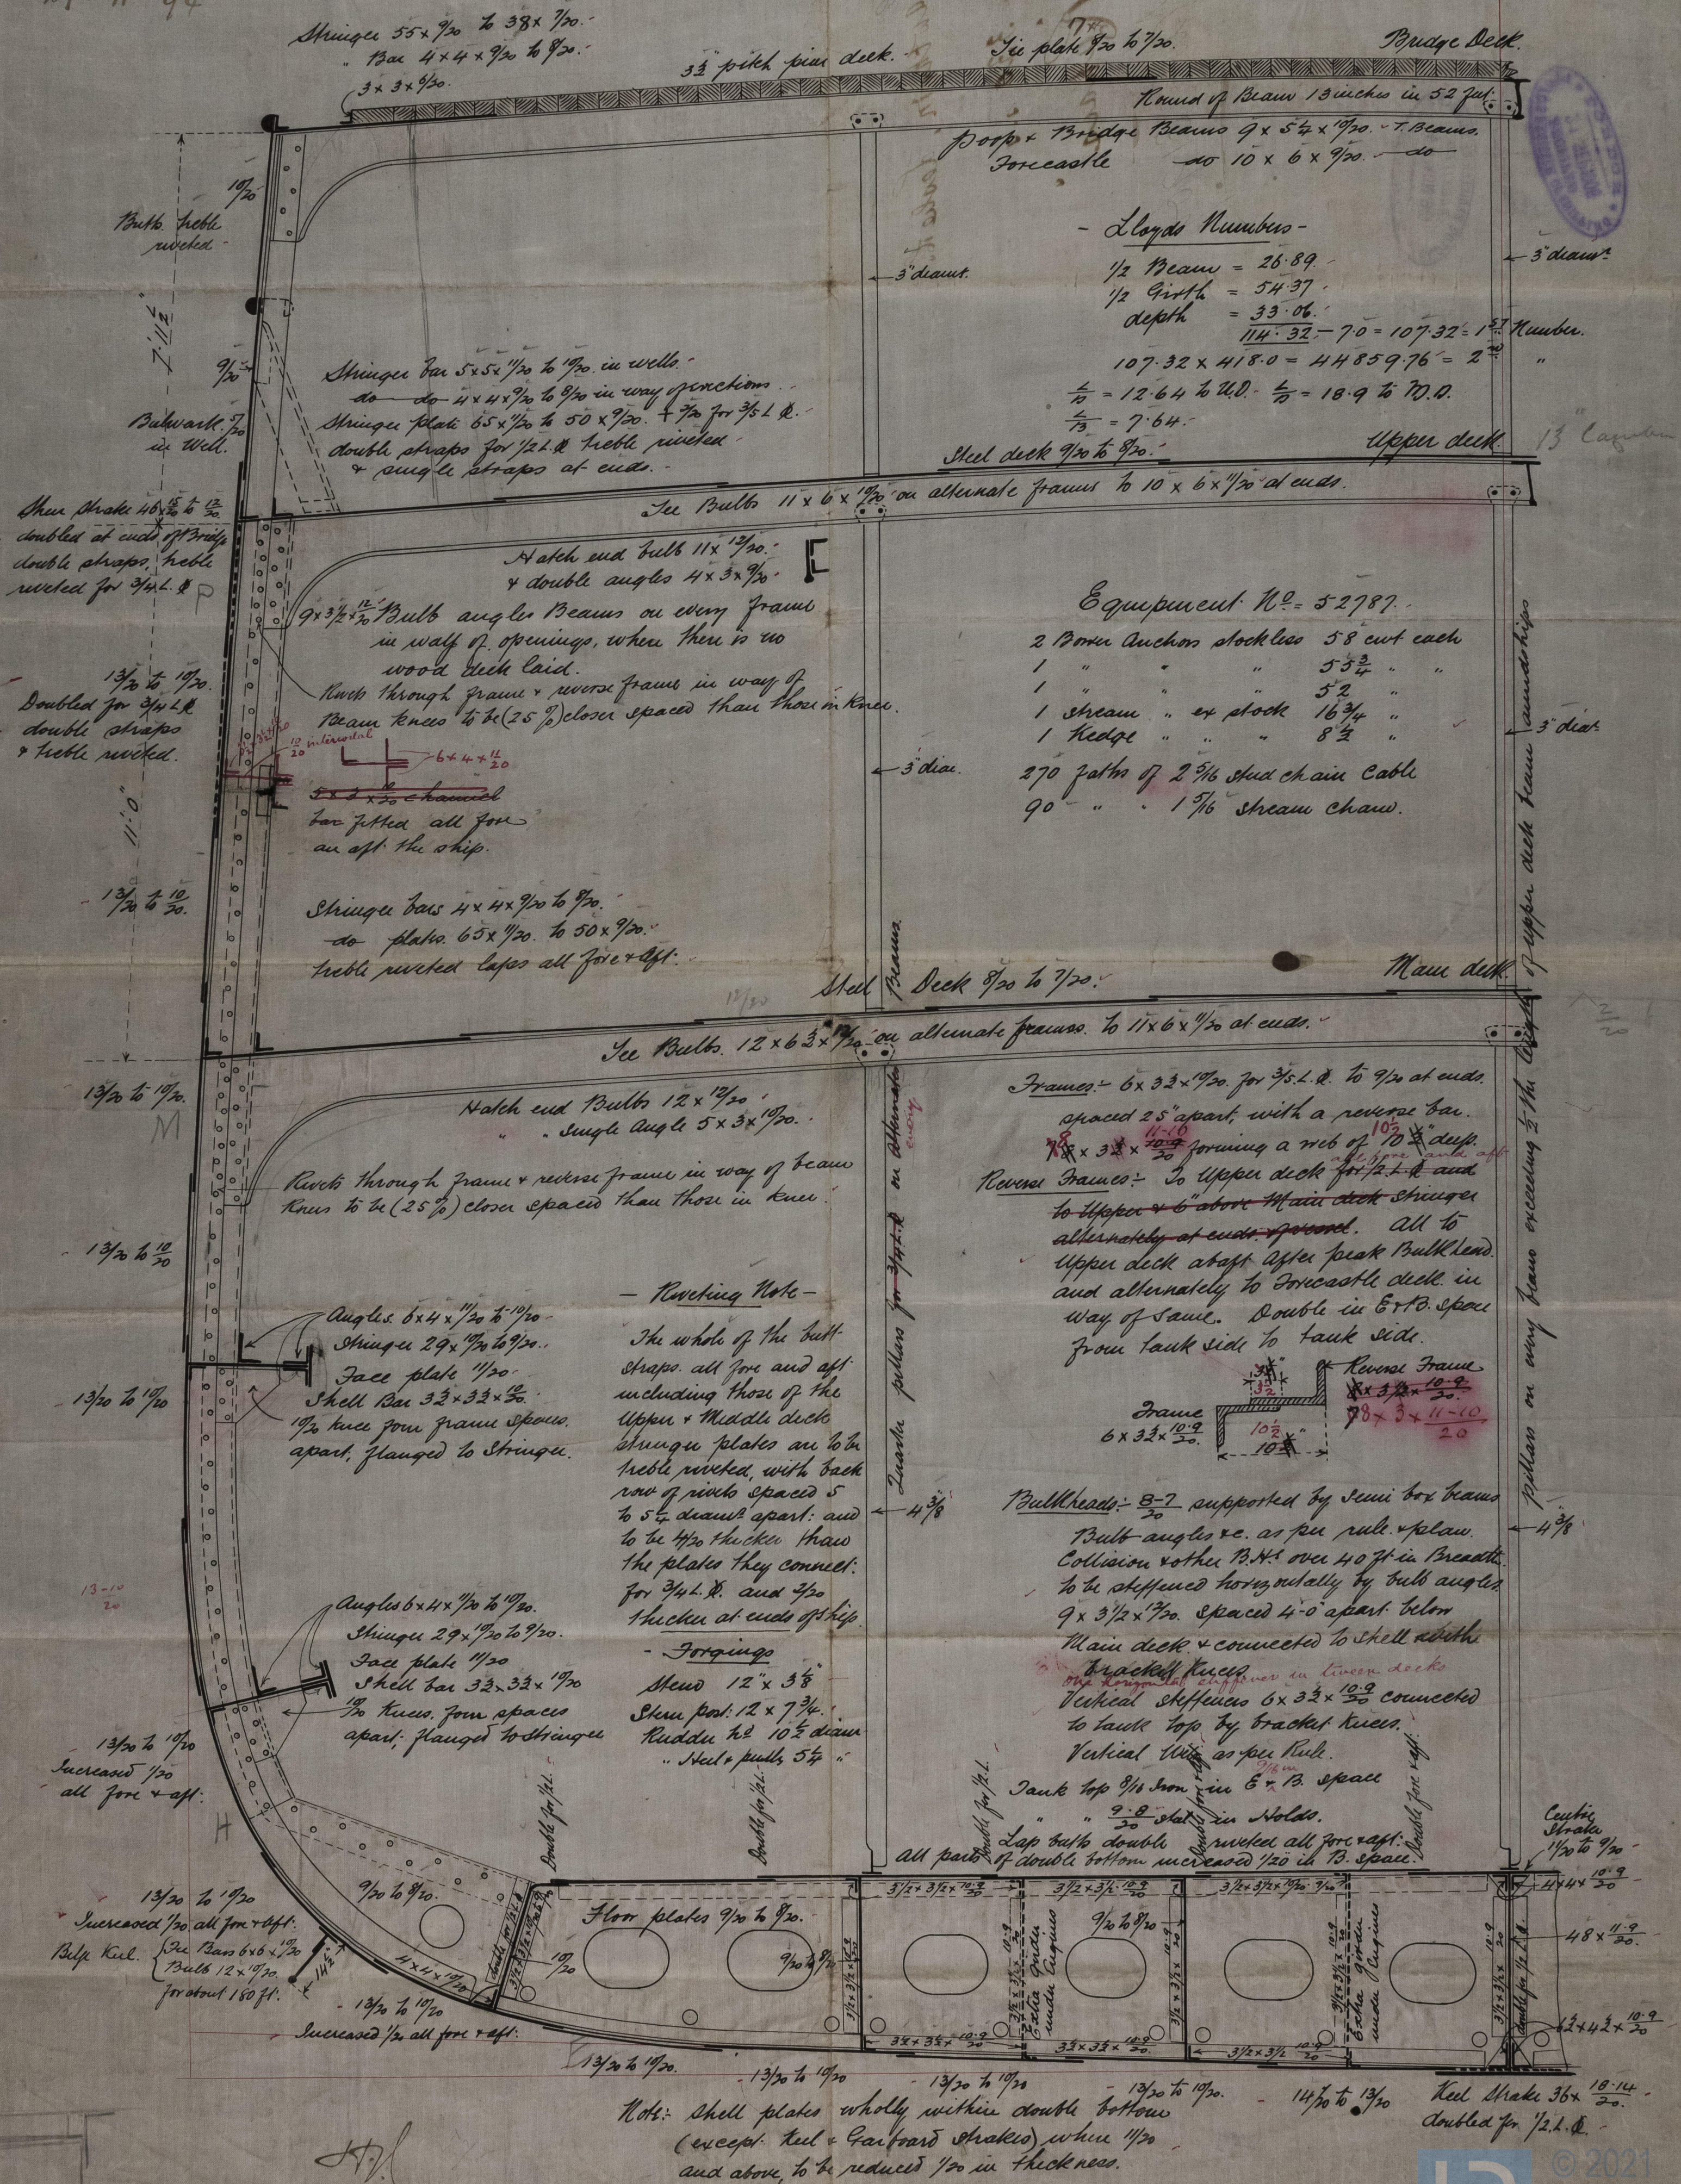


S. S. "Nakara"

Scale  $\frac{1}{2}$  inch = 1 Foot

10 - 9 - 94  
27 - 11 - 94

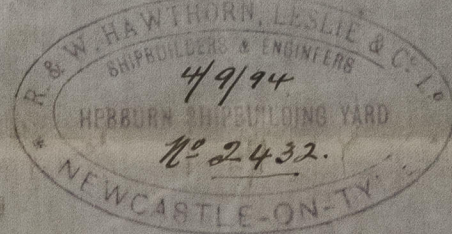

10/9/94

NWC 842-0099



Hawthorn, Leslie H.

No 330 ss

Rakais

No. 31909



© 2021

Lloyd's Register  
NWC842-0099  
Foundation