

SECTION SHOWING WEB FRAMES
IN ENGINE AND BOILER SPACE

SS. № 697.

- Scale $\frac{1}{2}'' = 1 \text{ FT}$

-MIDSHIP SECTION



Frame Number. $\frac{7.00}{98.76}$ ✓

Plating Number. 39322 ✓

-Equipment Number: 45688

1890

300 Fathoms of $2\frac{1}{4}$ " Stud Chain Cable

120	"	"	6	✓	Strip wire rope in fire
90	"	"	4 1/4	✓	Strip wire rope
90	"	"	3 1/2	✓	Strip wire rope
90	"	"	3 1/2	✓	"
90	"	"	3	✓	"
120	"	"	8	✓	MGansippa
120	"	"	8	✓	"
120	"	"	7	✓	"
120	"	"	6	✓	"

Palmer & Co. Ltd.



694. 4.
S.S. "Borneo"

Recd. freight and report

No 30499.



Recd 32134

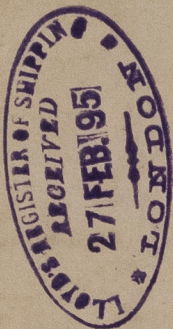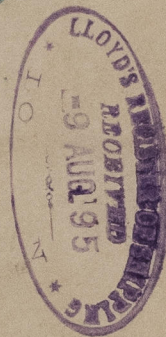

NWC842-0155



© 2021

Lloyd's Register
Foundation