

Lloyd's Register of British and Foreign Shipping.

(Report on Vessel No. 32137 Port NEWCASTLE-ON-TYNE)

No. 2572 SHIP FORGINGS OR CASTINGS.

I have to report that the undermentioned Iron ~~or Steel~~ Forgings ~~or Castings~~,
 manufactured by The Palmers S & S Co
 of Jarrow for the Vessel No. 697, being built
 by The Palmers S & S Co of Jarrow
 have been inspected by me as set forth below, and found to be, so far as can be seen,
Sound

The words FORGINGS or CASTINGS, IRON or STEEL, should be struck out as may be required.

Mark on Forgings.

Lloyd's


No. 40413

J6

John C Gray
Newcastle

	STERN FRAME.	RUDDER FRAME.	STEM.
Material* ...	<u>Scrap Iron</u>	<u>Scrap Iron</u>	
How made ...	<u>Forged</u>	<u>Forged</u>	
Dimensions ...	<u>11 - 7 1/2</u>	<u>10 - 5 1/4</u>	
Progress on Inspection	<u>Forged & Smitted</u>		<u>Not seen</u>
Date when Inspected	<u>December 4-10-14-18/84</u>		
	<u>January 3-11-17/85</u>	<u>March 2 to</u>	<u>May 17/85</u>

SKETCHES OF FRAMES SHOWING POSITION AND DESCRIPTION OF WELDS OF FORGINGS, OR PARTICULARS OF TESTS APPLIED TO CASTINGS.

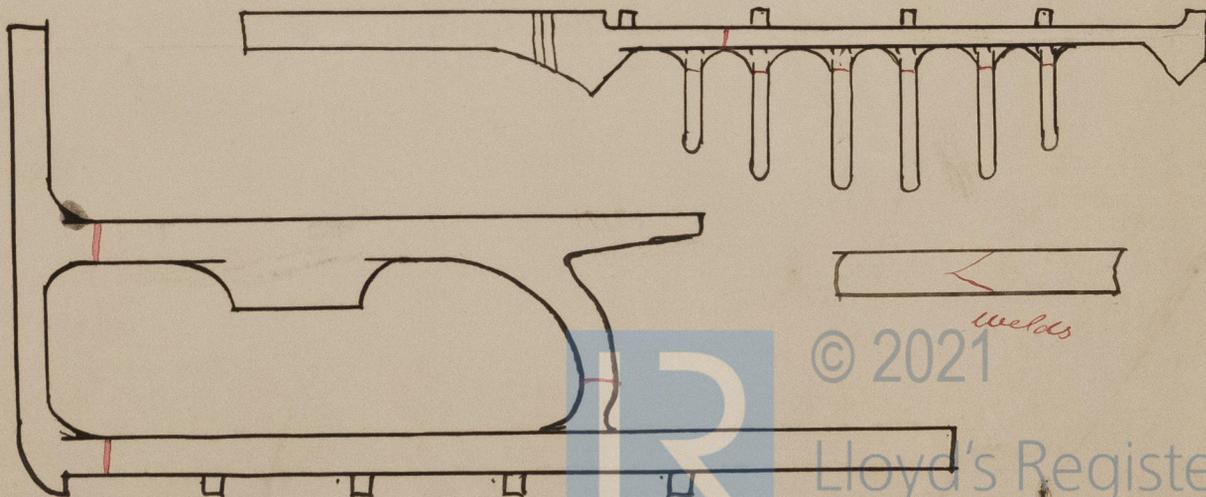

© 2021 Lloyd's Register Foundation

* If of Iron, state whether scrap or puddled Iron.