

Lloyd's Register of British and Foreign Shipping.

(Report on Vessel No. ~~2241~~ Port ~~NEWCASTLE-ON-TYNE~~)

No. 2684 SHIP FORGINGS OR CASTINGS.

I have to report that the undermentioned Iron ~~or Steel~~ ^{of Steel} Forgings ~~or Castings~~,
 manufactured by *The Palmers S^r & Co & Messrs John Rogerson & Co*
 of *Jarrow & Walsingham* for the Vessel No. *106*, being built
 by *The Tyne & S B Co* of *Howdon*
 have been inspected by me as set forth below, and found to be, so far as can be seen,
sound

The words FORGINGS or CASTINGS, IRON or STEEL, should be struck out as may be required.

Mark on Forgings.

Lloyd's

No. 4121+4122B

96



John C Craig

Newcastle

6.8.95

	STERN FRAME.	RUDDER FRAME.	STEM.
Material*	<i>Scrap Iron</i>	<i>Altwoods Steel</i>	
How made	<i>Forged</i>	<i>Cast</i>	
Dimensions	<i>11-6 3/4</i>	<i>As per Tracery Attached</i>	
Progress on Inspection	<i>Forged & Smoothed</i>	<i>Tested & Finished</i>	<i>Not done</i>
Date when Inspected	<i>December 10-18/94 April 10-30 May 3-13 January 3-11-14-17/95 June 14/95</i>		

SKETCHES OF FRAMES SHOWING POSITION AND DESCRIPTION OF WELDS OF FORGINGS, OR PARTICULARS OF TESTS APPLIED TO CASTINGS.

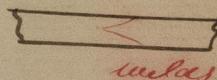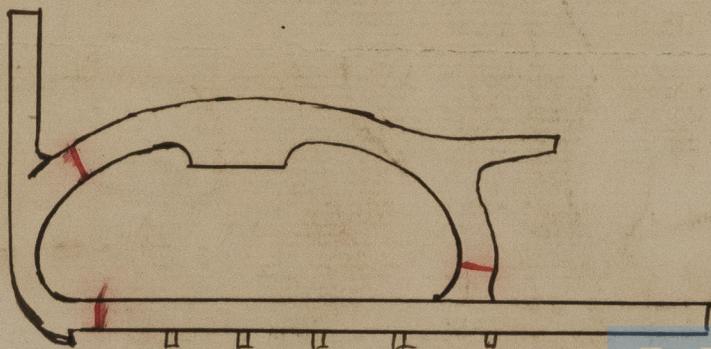

© 2021

Lloyd's Register Foundation