


S.S. AUREOLE
 NEWCASTLE ON TYNE
 REPORT No 62211

2 1/2
Curved

Sketch showing alterations to side structure or beam structure.
 W.R. the alteration on indicated is red.
 Scale 1/8" = 1 foot

S/S "Aureole"

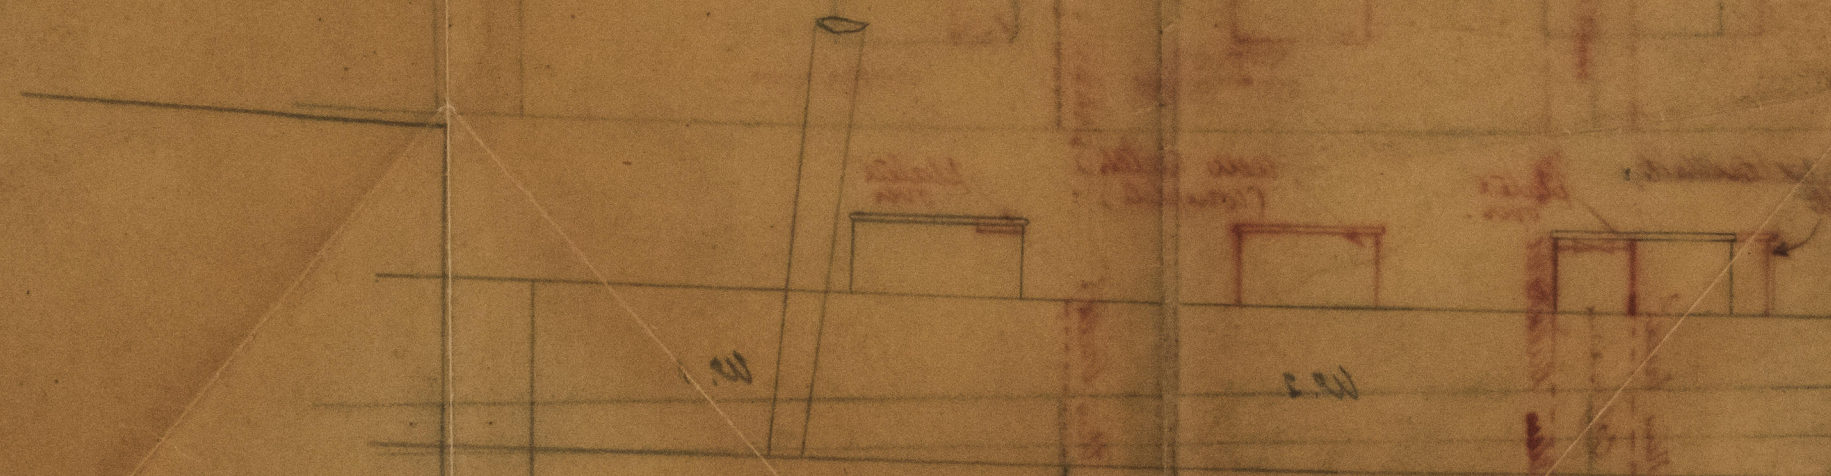

© 2021
 Lloyd's Register
 Foundation

NWC843-0054