

Lloyd's Register of British and Foreign Shipping.

(Report on Vessel No. _____ Port _____)

No. 2674 SHIP FORGINGS OR CASTINGS.

I have to report that the undermentioned Iron ~~or Steel~~ Forgings ~~or Castings~~,
 manufactured by Messrs J March & Co
 of Dunston for the Vessel No. 309, being built
 by Messrs John Readhead & Co of South Shields
 have been inspected by me as set forth below, and found to be, so far as can be seen,
sound

The words FORGINGS OR CASTINGS, IRON OR STEEL, should be struck out as may be required.



Mark on Forgings.

Lloyd's
No. 4452B
96

John C Craig
Newcastle
6.895

	STERN FRAME.	RUDDER FRAME.	STEM.
Material* ...	<u>Scrap Iron</u>	<u>Scrap Iron</u>	<u>Scrap Iron</u>
How made ...	<u>Forged</u>	<u>Forged</u>	<u>Forged</u>
Dimensions ...	<u>11-5/2</u>	<u>8-4</u>	<u>10-2 3/4</u>
Progress on Inspection	<u>Forged & Smithed</u>	<u>Forged & Smithed</u>	<u>Smithed</u>
Date when Inspected	<u>March 25 to April 26/95</u>	<u>June 6 to 29/95</u>	<u>April 26/95</u>

SKETCHES OF FRAMES SHOWING POSITION AND DESCRIPTION OF WELDS OF FORGINGS, OR PARTICULARS OF TESTS APPLIED TO CASTINGS.

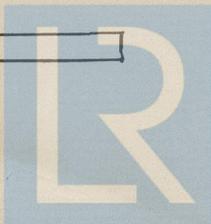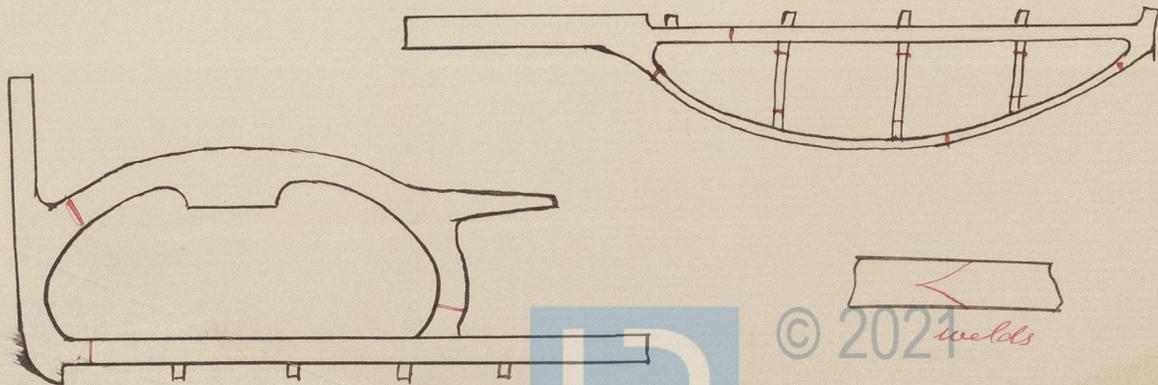

© 2021 Lloyd's Register Foundation

Heathland Row 309
8/5 "Adra"
New Rpt No 32352



© 2021

Lloyd's Register
Foundation