


23.4.95
30.4.95
20.5.95

No 188
Pinnaker Point

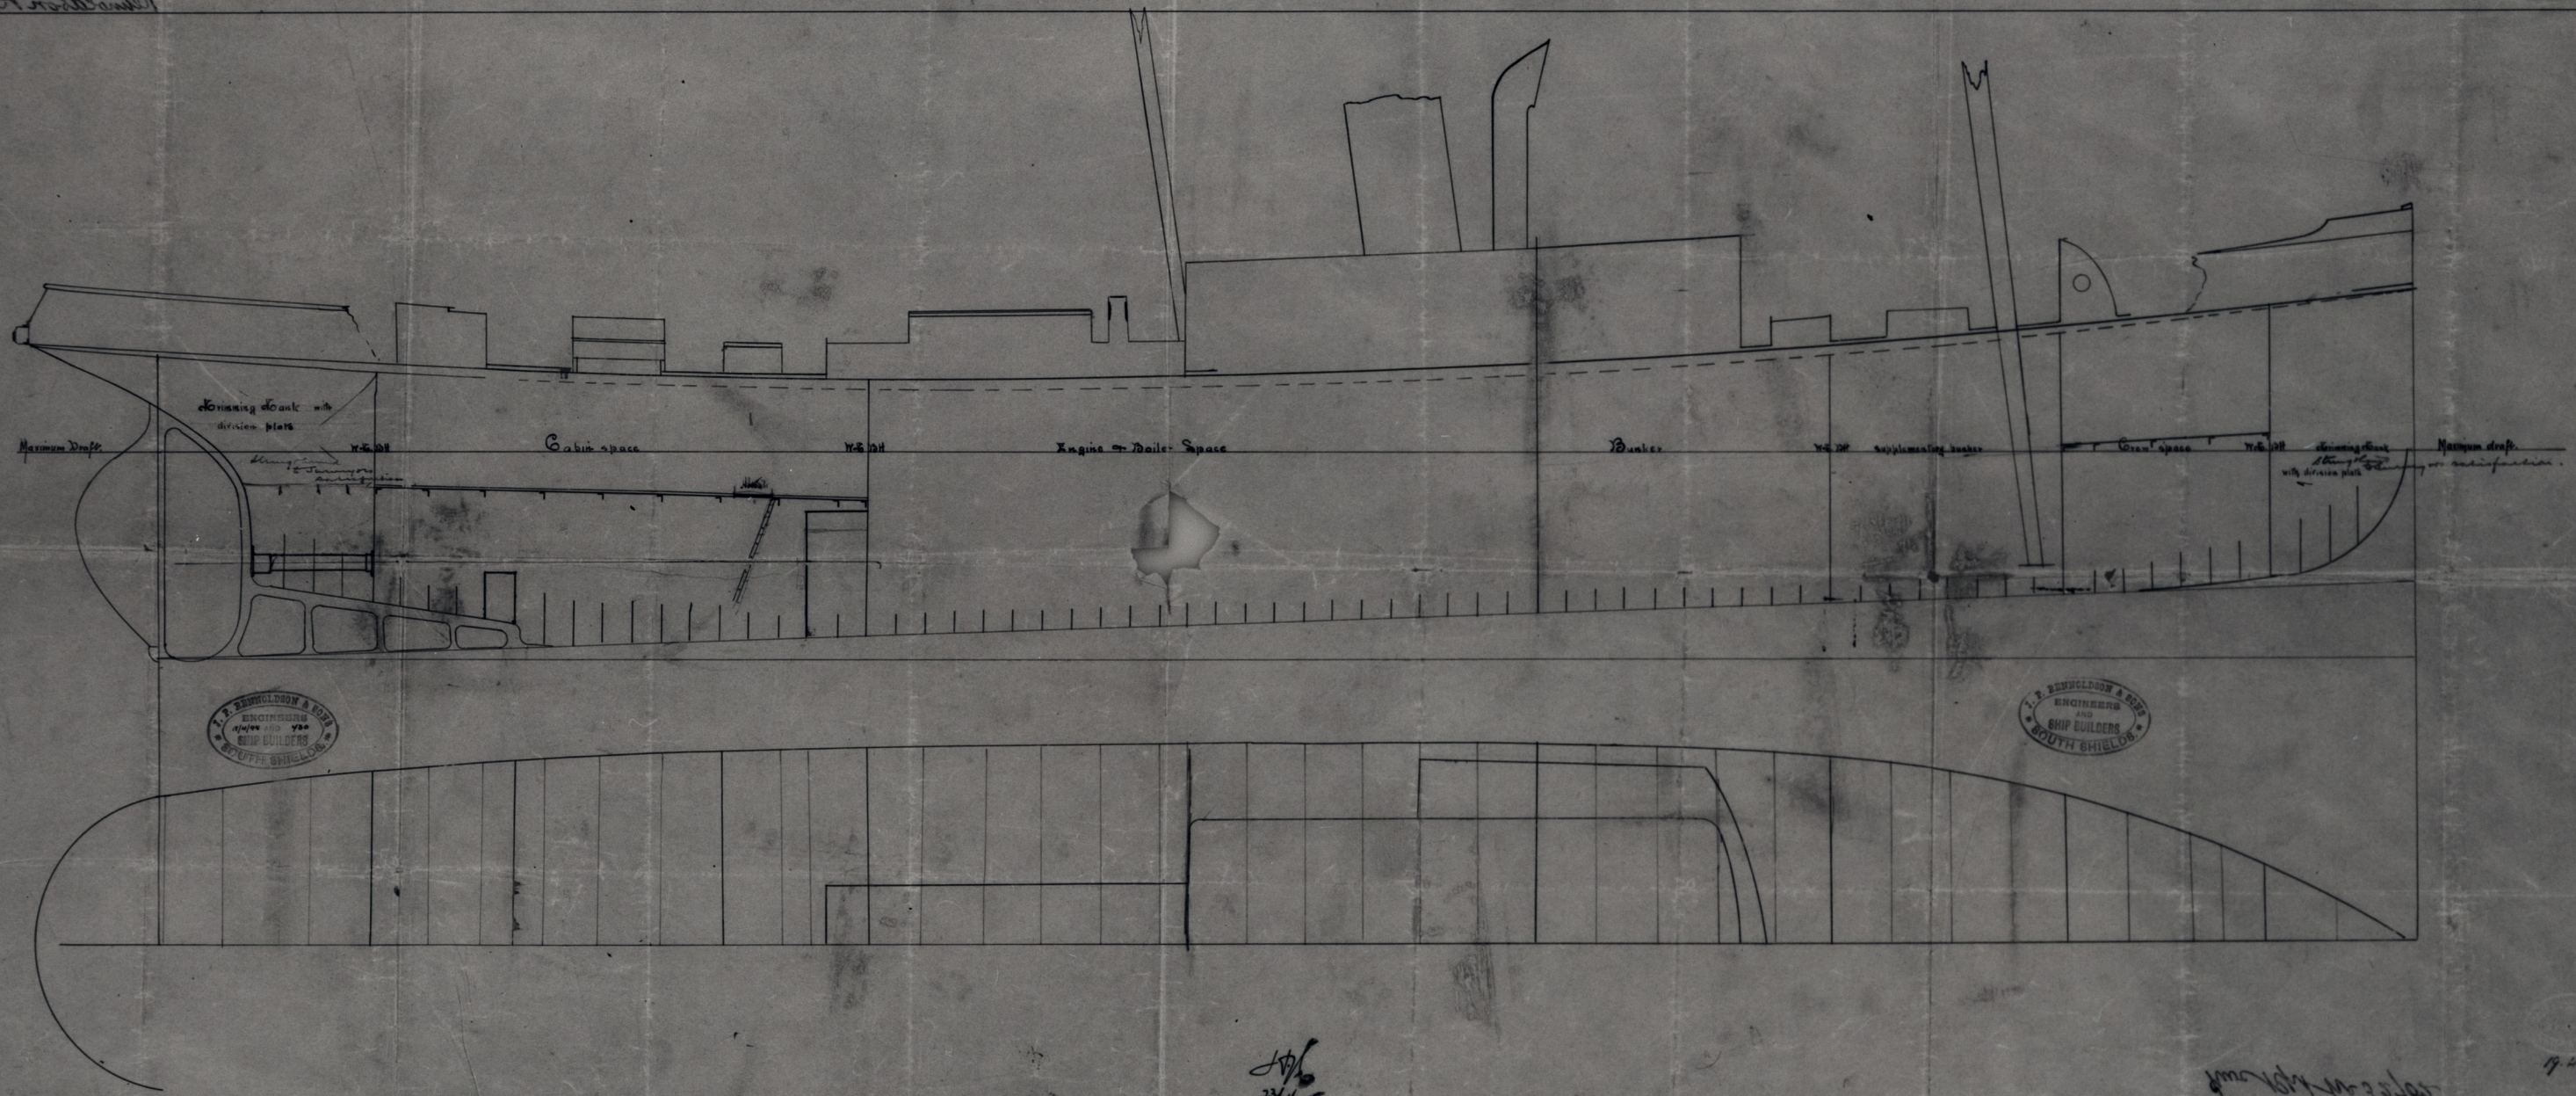

27/4/95

No 188
Pinnaker Point

19.4.95